

7/16/01
Layout - 11:00

04-365542

ISSUE DATE: 7/11/2001

PERMIT

P 515331

APPROVAL DATE: 7/17/01

A 514973

7/17/01
Final
~ Nosh

ON-SITE SEWAGE DISPOSAL SYSTEM HOWARD COUNTY HEALTH DEPARTMENT BUREAU OF ENVIRONMENTAL HEALTH

Will Hopkins IS PERMITTED TO INSTALL ALTER

ADDRESS: 17550 Old Frederick Road 21771 PHONE NUMBER: 410-549-2575

SUBDIVISION: Davis Property LOT NUMBER: _____

ADDRESS: 910 Morgan Station Road PROPERTY OWNER: Robert Davis

SEPTIC TANK CAPACITY (GALLONS): 1000 (TOPSEAM) *Owner may elect to install a 1250*

PUMP CHAMBER CAPACITY (GALLONS): N/A

NUMBER OF BEDROOMS: 3

SQUARE FEET PER BEDROOM: 240

LINEAR FEET OF TRENCH REQUIRED: 180


TRENCHES:	Trench to be 2.0 feet wide. Inlet 4.0 feet below original grade. Bottom maximum depth 8.0 feet below original grade. Effective area begins at 4.0 feet below original grade. 4.0 feet of stone below distribution pipe.
LOCATION:	Place the distribution box 20 feet off the left lot line and 140 feet off the front lot line as seen when facing the lot from Morgan Station Road. Run trenches along contour towards the road.
NOTES:	

PLANS APPROVED: DKC 6/4/01 ON SRK 6/9/01 DATE: 6/4/01

- NOTE: PERMIT VOID AFTER 2 YEARS
- NOTE: CONTRACTOR RESPONSIBLE FOR SCHEDULING A PRE-CONSTRUCTION INSPECTION FOR ALL INSTALLATIONS
- NOTE: WATER TIGHT SEPTIC TANKS REQUIRED
- NOTE: ALL PARTS OF SEPTIC SYSTEM SHALL BE 100 FEET FROM ANY WATER WELL
- NOTE: MANHOLE RISERS REQUIRED ON ALL SEPTIC TANKS AND PUMP CHAMBERS

NEITHER THE HOWARD COUNTY COUNCIL NOR THE HEALTH DEPARTMENT IS RESPONSIBLE FOR THE SUCCESSFUL OPERATION OF ANY SYSTEM PERMITTEE RESPONSIBLE FOR OBTAINING FINAL APPROVAL ON THIS PERMIT CALL 410-313-2640 FOR INSPECTION OF SEPTIC SYSTEM

NOT TO SCALE

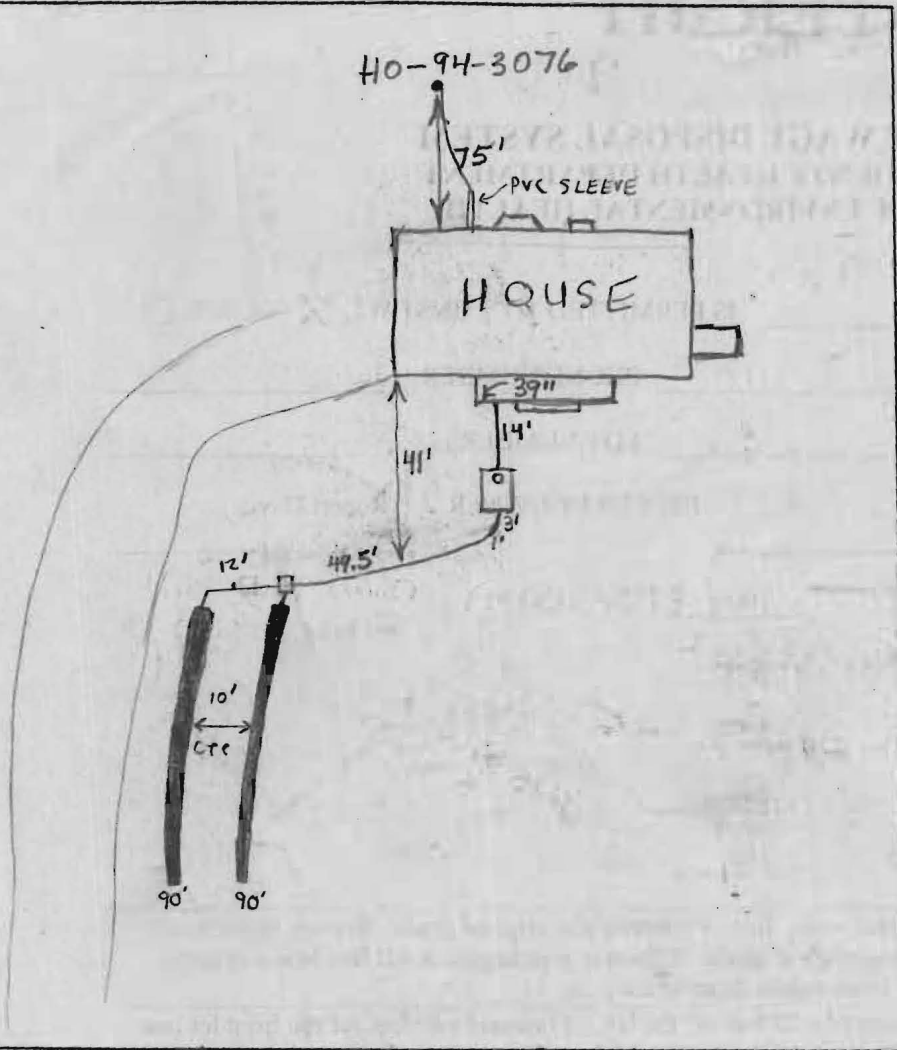

TRENCH DATA

TRENCH WIDTH 2'
 TRENCH INLET DEPTH 3'5"
 TRENCH BOTTOM DEPTH 8'
 DEPTH OF STONE 4-4 1/2'
 NUMBER OF TRENCHES 2
 TOTAL TRENCH LENGTH 180'
 ABSORBENT AREA 720ft²
 DISTRIBUTION BOX LEVEL ✓
 BAFFLE IN DISTRIBUTION BOX ✓

SEPTIC TANK DATA

SEPTIC TANK 1250 TS GALLONS
 MANHOLE RISER No
 6 INCH INSPECTION PORT Yes

PUMP CHAMBER DATA N/A

~~PUMP CHAMBER GALLONS _____
 MANHOLE RISER _____
 ALARM _____
 PUMP PERFORMANCE TEST _____~~

Morgan Station Road

PRE-CONSTRUCTION INSPECTION: _____

INSPECTION COMMENTS: 7/17/01- OK TO COVER ALL WORK - SRK

SPECTOR Steven R. King DATE SYSTEM APPROVED 7/17/01