

State of Maryland
Department of Health
Howard County Health Dept.

APPLICATION

Th-Howard
1957

SEWAGE DISPOSAL TESTING

P. _____

MARYLAND STATE DEPARTMENT OF HEALTH

HOWARD COUNTY 1250 Gallon Tank

ELLICOTT CITY
DISTRICT Third

Dry Well - 500 sq ft Redwall
area below the top 5 FT of clayish
soil with a maximum depth of 16 FT
in the Dry Well between 25 FT and 50 FT
on the north line and between 30 FT and
50 FT on the south line. See notes
on Mt. View Rd

DATE 8/25/59

TO: THE COUNTY HEALTH OFFICER
ELLICOTT CITY, MARYLAND

I, HEREBY, APPLY FOR THE NECESSARY TESTS IN ORDER TO CONSTRUCT (OR RECONSTRUCT) A SEWAGE DISPOSAL SYSTEM.

PROPERTY OWNER Lee J. & Iola B. Wilson

ADDRESS Mt. View Road, Marriottsville, Md. 21104 PHONE DAB-2444

PROPERTY LOCATION:

SUBDIVISION _____ LOT NO. _____

ROAD AND DESCRIPTION Mt. View Road between Old Frederick Road and Sand Hill Road
Across road from Crest Lawn Cemetery. Adjoining property owner on west:
B. Dorsey Ridgely; adjoining property owner on east: Mr. Matee.
This is a one acre lot to be deeded to daughter and son-in-law, Mr. and
Mrs. Robert E. McManus
Unoccupied property

PERSON TO CONSTRUCT SYSTEM Mr. Jack Fyock,

ADDRESS Ten Oaks & Tridelphia Roads PHONE 286-2939

SIZE OF LOT One acre TYPE BLDG. Single residence
162.69x250.22x166.99x284.54 5 bedrooms
IF NOT SINGLE RESIDENCE DESCRIBE _____

SIGNATURE OF APPLICANT Ellen W. McManus (Mrs. Robert E.)


APPROVED BY Robert E. McManus FOR Dry Well DATE 10/3/59

REJECTED BY _____ FOR _____ DATE _____

HOLD PENDING FURTHER TESTS _____ DATE _____

REASONS FOR REJECTION OR HOLDING _____

THIS IS NOT A PERMIT

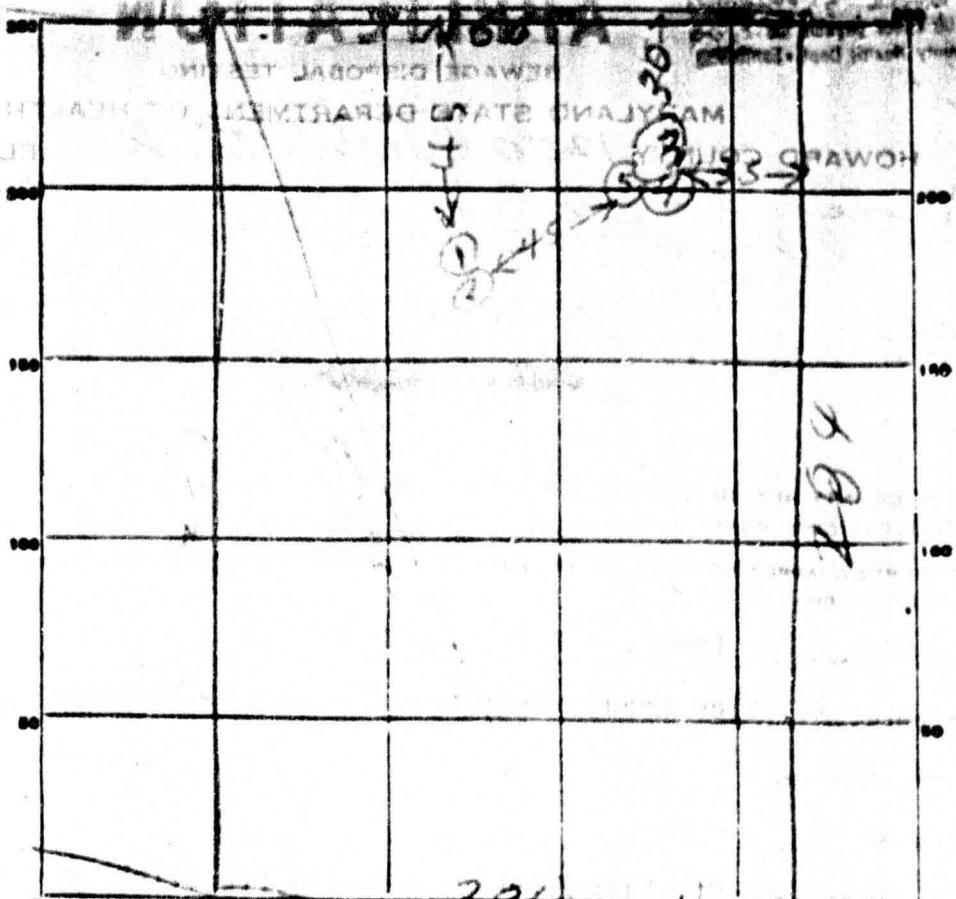

INDICATE NORTH - NAME ADJOINING ROADWAY AS BASE LINE.
 M.T. VIEW RD.

DATE	TEST NO.	DEPTH	PRE-WET		TEST - 1" DROP		TIME	
			START	STOP	START	STOP		
9/25/89	1	2	942	943	943	944	1	
	2	3	946	1022	about 3/4 inch	little more		
	3	10	949	957	950	952	2	
	4	3	950	1010	about 1/2 inch	little more		
	5	12	SAME PLACE AS ②					
			TOP 5 FT CLAYISH BOT 7 FT SAND					

SOIL AUGER FINDING _____
 TESTED BY B. Hodge
 REMARKS _____

THIS IS NOT