

PERMIT

P. 18261

A. 14787 514965-B

4/3/70 *Randy*

SEWAGE DISPOSAL SYSTEM

MARYLAND STATE DEPARTMENT OF HEALTH

HOWARD COUNTY

ELLICOTT CITY

DISTRICT 3

DATE 5/27/70

INDEXED

Jack Frock

IS PERMITTED TO INSTALL ALTER

ADDRESS Tea Oaks Road, Glenneck, Maryland

PHONE 286-2999

SEWAGE DISPOSAL SYSTEM LOCATED AT

address may be changing to

DIVISION

2054

OR 2125

2125

ROAD Mt. View Rd. (see application for better directions)

PROPERTY OWNER Mrs. Robert E. Hoffman

ADDRESS

REQUIREMENTS - 3 bedrooms

DRAIN FIELD DEPTH FEET. BOTTOM AREA SQ. FT.

SEEPAGE PITS ABSORBENT SIDE-WALL AREA SQ. FT.

SEPTIC TANK CAPACITY 1,250 GALLONS

FOR GARBAGE GRINDER, INCREASE DISPOSAL AREA 22% & TANK CAPACITY 50%.

OTHER Dry well - 500 sq. ft. sidewall area below the top 5 ft. of clayish soil with a maximum depth of 16 ft. Place the dry well between 25 ft. and 30 ft. from the back lot line and between 20 ft. and 30 ft. from the right side of the lot as seen when facing the lot from Mt. View Road.

NOTE: ALL PIPES FROM HOUSE TO SEPTIC TANK MUST BE CAST IRON.

PERMIT VOID AFTER THREE YEARS.


PLANS APPROVED BY Raymond Hodges

DATE 10/3/69

FILL SEPTIC TANK AND DISTRIBUTION BOX WITH WATER BEFORE CALLING FOR AN INSPECTION. COVER NO WORK UNTIL INSPECTED AND APPROVED.

NEITHER THE HOWARD COUNTY COMMISSIONERS NOR THE HEALTH DEPARTMENT IS RESPONSIBLE FOR THE SUCCESSFUL OPERATION OF ANY SYSTEM.

514964-B

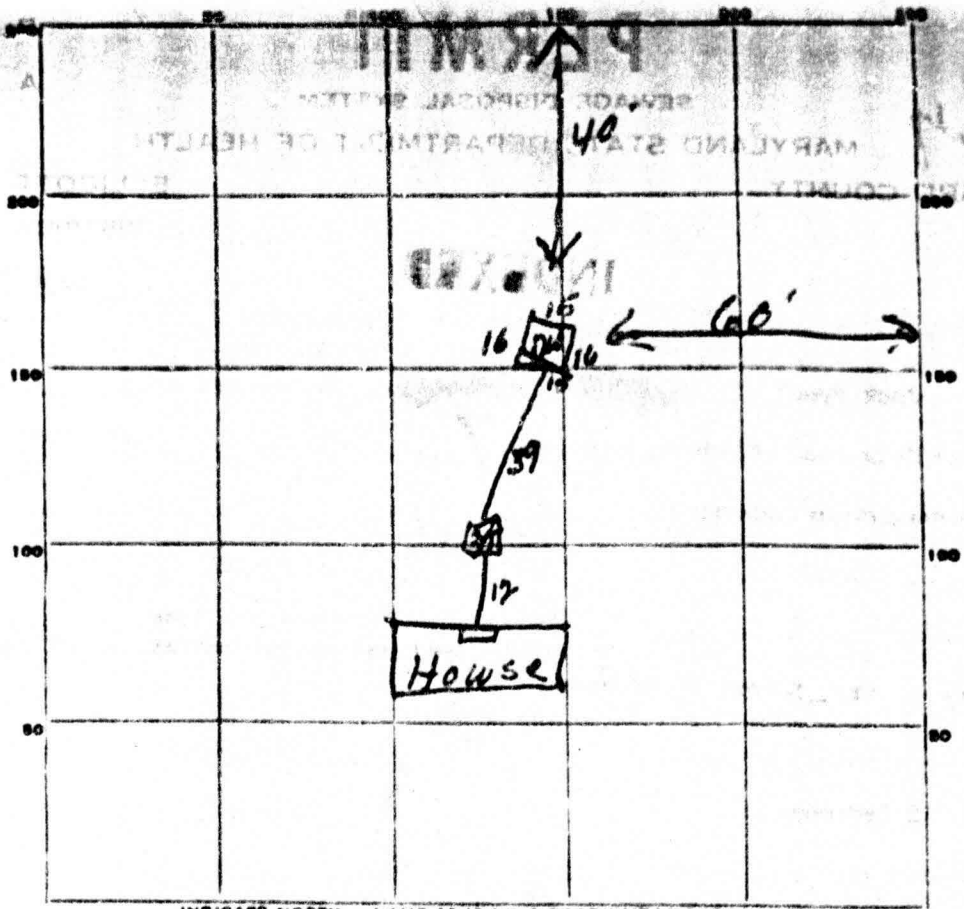

INDICATE NORTH - NAME ADJOINING ROADWAY AS BASE LINE.

PERMIT CARD OK Mt New Rd

SEPTIC TANK, LEVEL OK 1200 limit CLEANOUTS OK

DISTRIBUTION BOX, LEVEL _____

TILE FIELD, DEPTH _____ FT. TRENCH WIDTH _____ FT.

GRAVEL DEPTH _____ IN. TOTAL LENGTH _____ FT.

NUMBER OF TRENCHES _____ TOTAL BOTTOM AREA _____

SEEPAGE FITS, INSIDE DIAMETER 16x16 x 15x15 12 FT. DEPTH BELOW INLET 9 FT.

ABSORBENT AREA 558 SQ. FT.

REMARKS _____

DATE SYSTEM APPROVED 6/2/70 INSPECTOR [Signature]