


P531977-

Robert A. Tull Co.
Did Connection
Inspection Done
Without Wall Check
or Permit

H0-95-0063

NOT TO SCALE

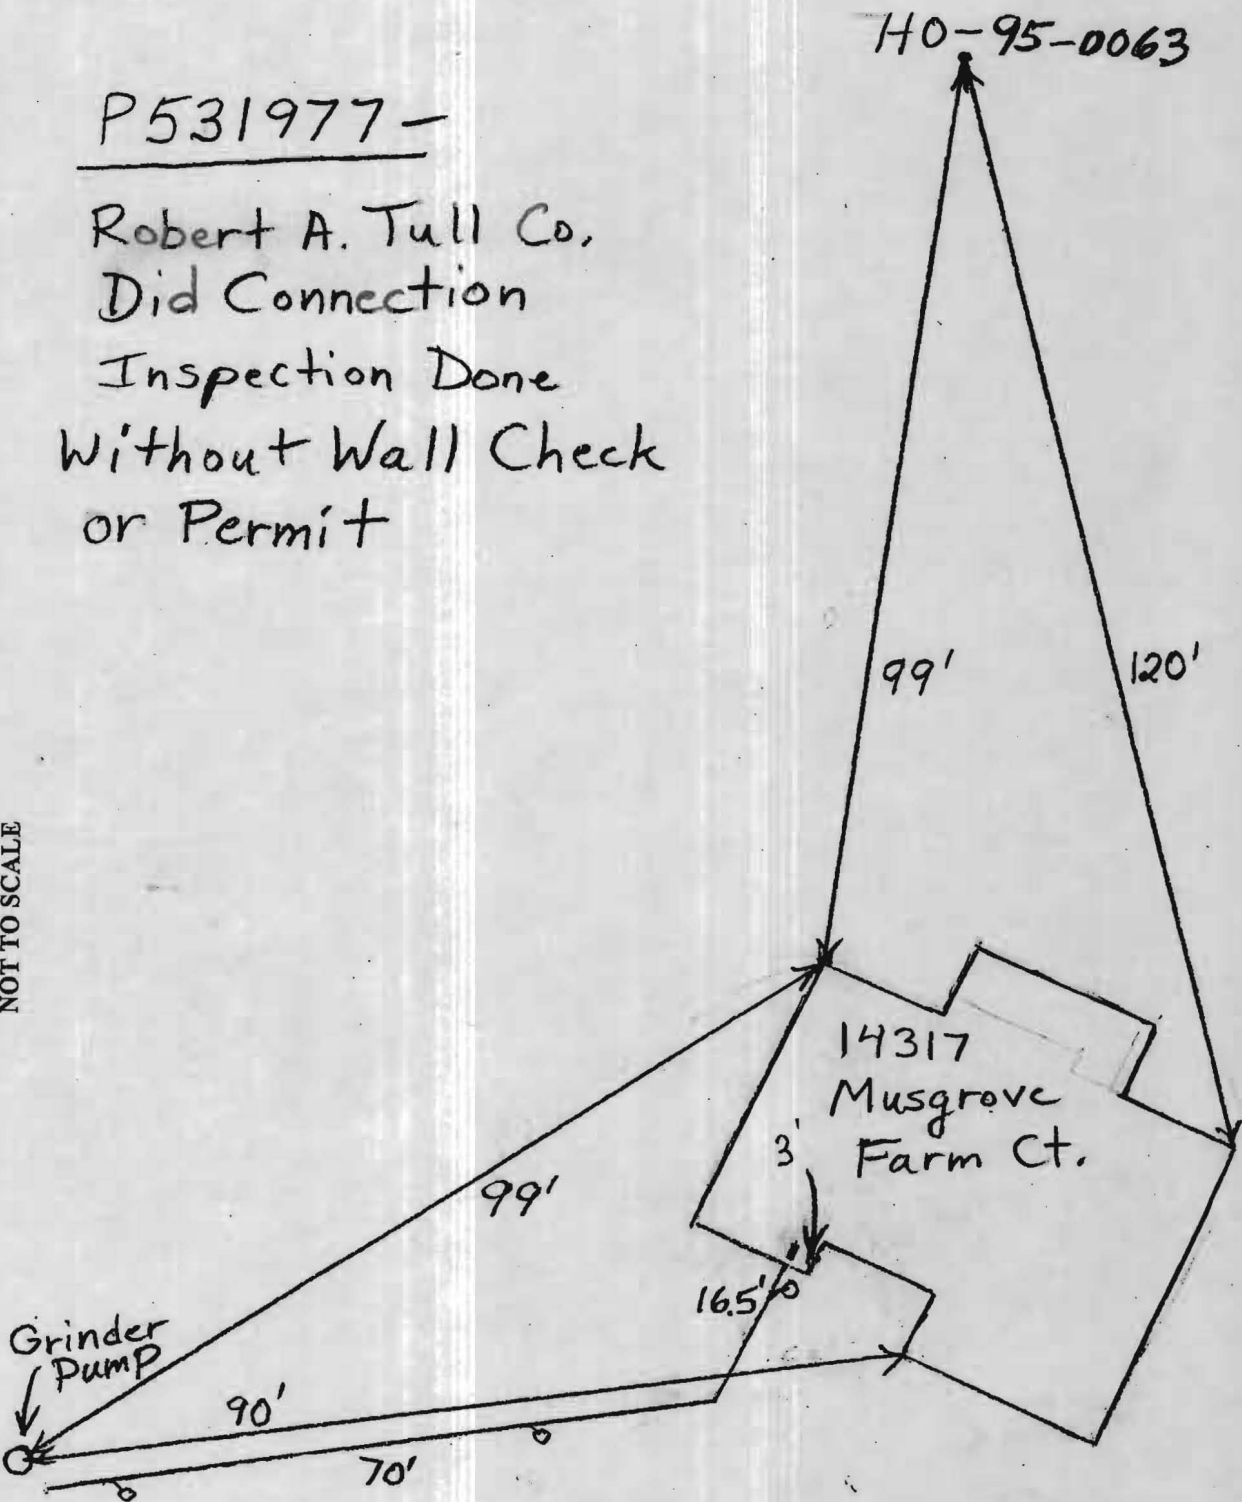

12/9/09 Started on connection from house to grinder pump. (BB)

12/10/09 Connection finished. Need confirmation that pump and alarm are working. (BB) 2/19/10 Pump & alarm test verified. Everything working correctly. System

Complete (CW)