

APPLICATION

SEWAGE DISPOSAL TESTING

A 08044

P _____

MARYLAND STATE DEPARTMENT OF HEALTH

HOWARD COUNTY

ELLICOTT CITY

DISTRICT 5

DATE 8/25/64

*8/27/64
9:30
9/13/65
4:30 PM*

*8/26/64 - Mack didn't show up
RF
9/4/64 - Rejected
5/13/65 - Final rejection, accept no
more appointments for this lot. RF.*

TO: THE COUNTY HEALTH OFFICER
ELLICOTT CITY, MARYLAND

I, HEREBY, APPLY FOR THE NECESSARY TESTS IN ORDER TO CONSTRUCT (OR RECONSTRUCT) A SEWAGE DISPOSAL SYSTEM.

PROPERTY OWNER ~~XXXXXXXX~~ Wayne H. Wilson

ADDRESS Nichols Drive, Clarksville, Md. PHONE WA 6-1296

PROPERTY LOCATION: 32 W. Diamond Ave.
Gaithersburg, Md.

SUBDIVISION _____ LOT NO. _____

ROAD AND DESCRIPTION Nichols Drive off Brighton Dam Road - about 1500 ft. - across
from pond on left

OCCUPANT _____ PHONE _____

PERSON TO CONSTRUCT SYSTEM _____

ADDRESS _____ PHONE _____

SIZE OF LOT 1.487 acres TYPE BLDG. 3
NUMBER OF BEDROOMS

IF NOT SINGLE RESIDENCE DESCRIBE _____

SIGNATURE OF APPLICANT *Carl J. [Signature]*

APPROVED BY _____ FOR _____ (KIND OF SYSTEM) DATE _____

REJECTED BY R. F. Fletcher FOR _____ (KIND OF SYSTEM) DATE 9/4/64

HOLD PENDING FURTHER TESTS R. F. Fletcher DATE 8/27/64

REASONS FOR REJECTION OR HOLDING water at 9 ft - only 1 hole dug
9/4/64 - not enough porous soil to support system RF.
water at 7 1/2 ft. - no pipe at 3 ft in two holes

THIS IS NOT A PERMIT

APPLICATION

A 08944

P _____

SEWAGE DISPOSAL TESTING

MARYLAND STATE DEPARTMENT OF HEALTH

HOWARD COUNTY

ELLICOTT CITY

DISTRICT 5

DATE 8/25/64

*9/4/64 - Rejected
5/13/65 - Final rejection, accept no
more appointments on this list.*

TO: THE COUNTY HEALTH OFFICER
ELLICOTT CITY, MARYLAND

I, HEREBY, APPLY FOR THE NECESSARY TESTS IN ORDER TO CONSTRUCT (OR RECONSTRUCT) A SEWAGE DISPOSAL SYSTEM.

PROPERTY OWNER ~~XXXXXXXX~~ Wayne H. Wilson

ADDRESS Nichols Drive, Clarksville, Md. PHONE WA 6-1296

PROPERTY LOCATION:

SUBDIVISION _____ LOT NO. _____

ROAD AND DESCRIPTION Nichols Drive off Brighton Dam Road - about 1500 ft. - across
from pond on left

OCCUPANT _____ PHONE _____

PERSON TO CONSTRUCT SYSTEM _____

ADDRESS _____ PHONE _____

SIZE OF LOT 1.487 Acres TYPE BLDG. 3 NUMBER OF BEDROOMS _____

IF NOT SINGLE RESIDENCE DESCRIBE _____

SIGNATURE OF APPLICANT *Wayne H. Wilson*

APPROVED BY _____ FOR _____ (KIND OF SYSTEM) DATE _____


REJECTED BY *R.F. Little* FOR _____ (KIND OF SYSTEM) DATE 9/4/64

HOLD PENDING FURTHER TESTS *R.F. Little* DATE 8/27/64

REASONS FOR REJECTION OR HOLDING *water is apt. only 1 hole dug*

9/4/64 - not enough ground soil to support system - R.F.

THIS IS NOT A PERMIT

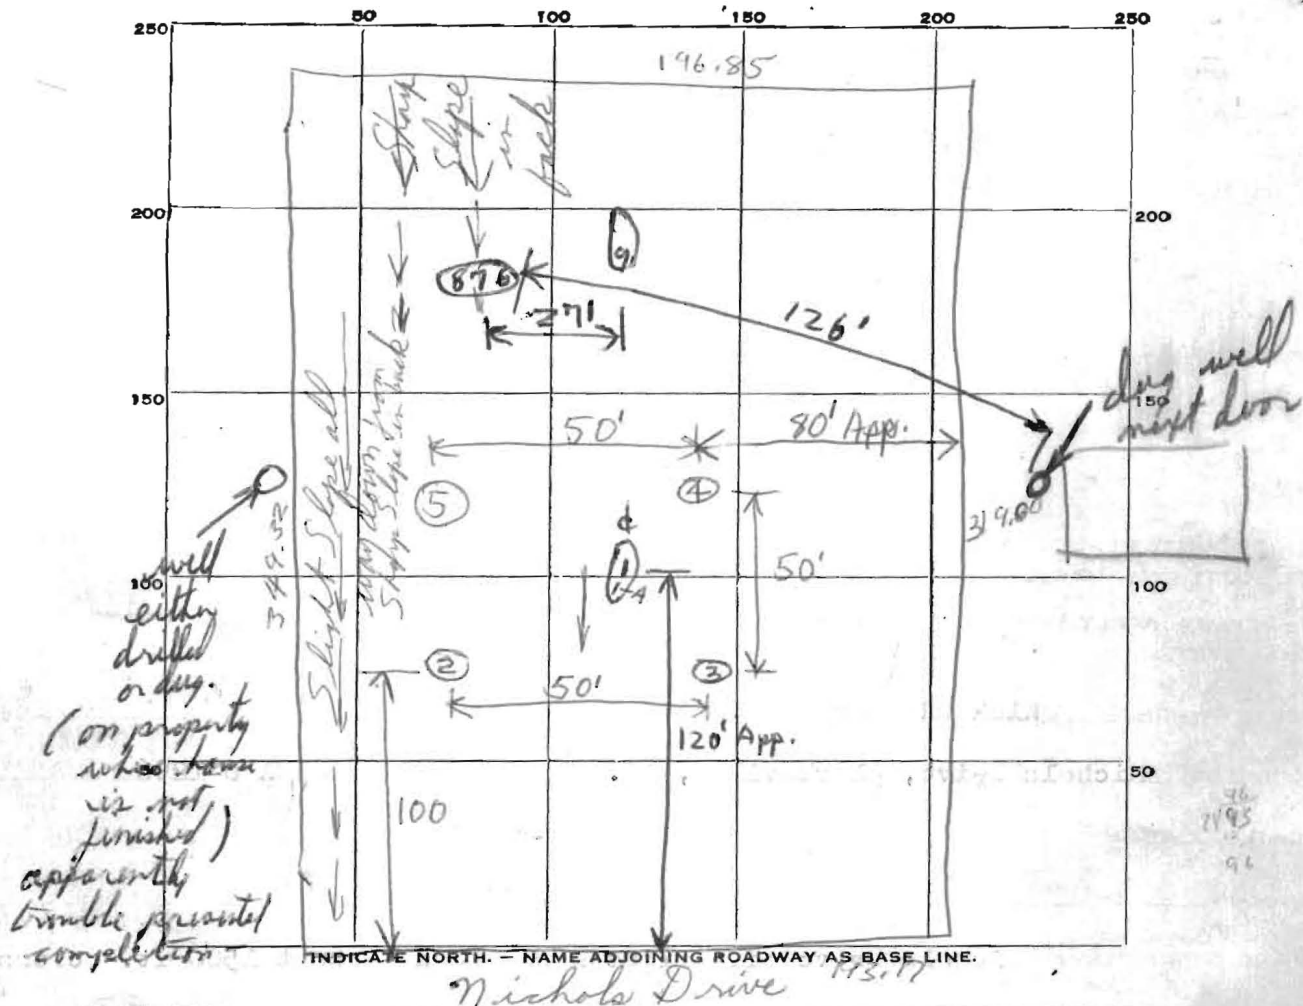


| DATE | TEST NO. | DEPTH | PRE-WET | | TEST - 1" DROP | | TIME |
|---------|----------|---|---------|-------|----------------|-------|---------------------------------|
| | | | START | STOP | START | STOP | |
| 8/27/64 | 1 | | | | | | |
| 9/4/64 | 2 | 3 ft. | 9:45 | | | | |
| | 3 | 3 ft. | 9:50 | 10:04 | 10:04 | 10:37 | 33 min. |
| | 4 | 3 ft. | 9:57 | 10:29 | 10:29 | | Over time on 2nd inch - 75 min. |
| | 5 | 3 ft. | 10:00 | 10:08 | 10:08 | 10:28 | 20 min. |
| | (1-A) | (same as hole #1) | | | | | |
| | | water now at 7 1/2 ft in hole #1 - water | | | | | |
| | | water at 9 ft on 8/27/64 - no rain during period from 8/27/64 to 9/4/64 | | | | | |
| 5/13/65 | 6 | 12 ft. | 1:31 | | | | Step test - no perc in 40 min. |
| | 7 | 5 1/2 ft. | 1:32 | | | | " " " " " " |
| | 8 | 6 ft. | 1:34 | | | | Over time on just inch. |
| | 9 | 5 ft. | 2:18 | | | | No Perc - Step test |
| | 10 | 7 1/2 ft. | 2:23 | | | | " " " " |

SOIL AUGER FINDING water at 9 ft - clayish to 6 ft - very damp 6' - 9' only one hole dug -

TESTED BY ROP 8/27/64

REMARKS 9/4/64 - not enough porous soil to support auger

ALSO PRESENT [Signature] LOT NO. [Signature]

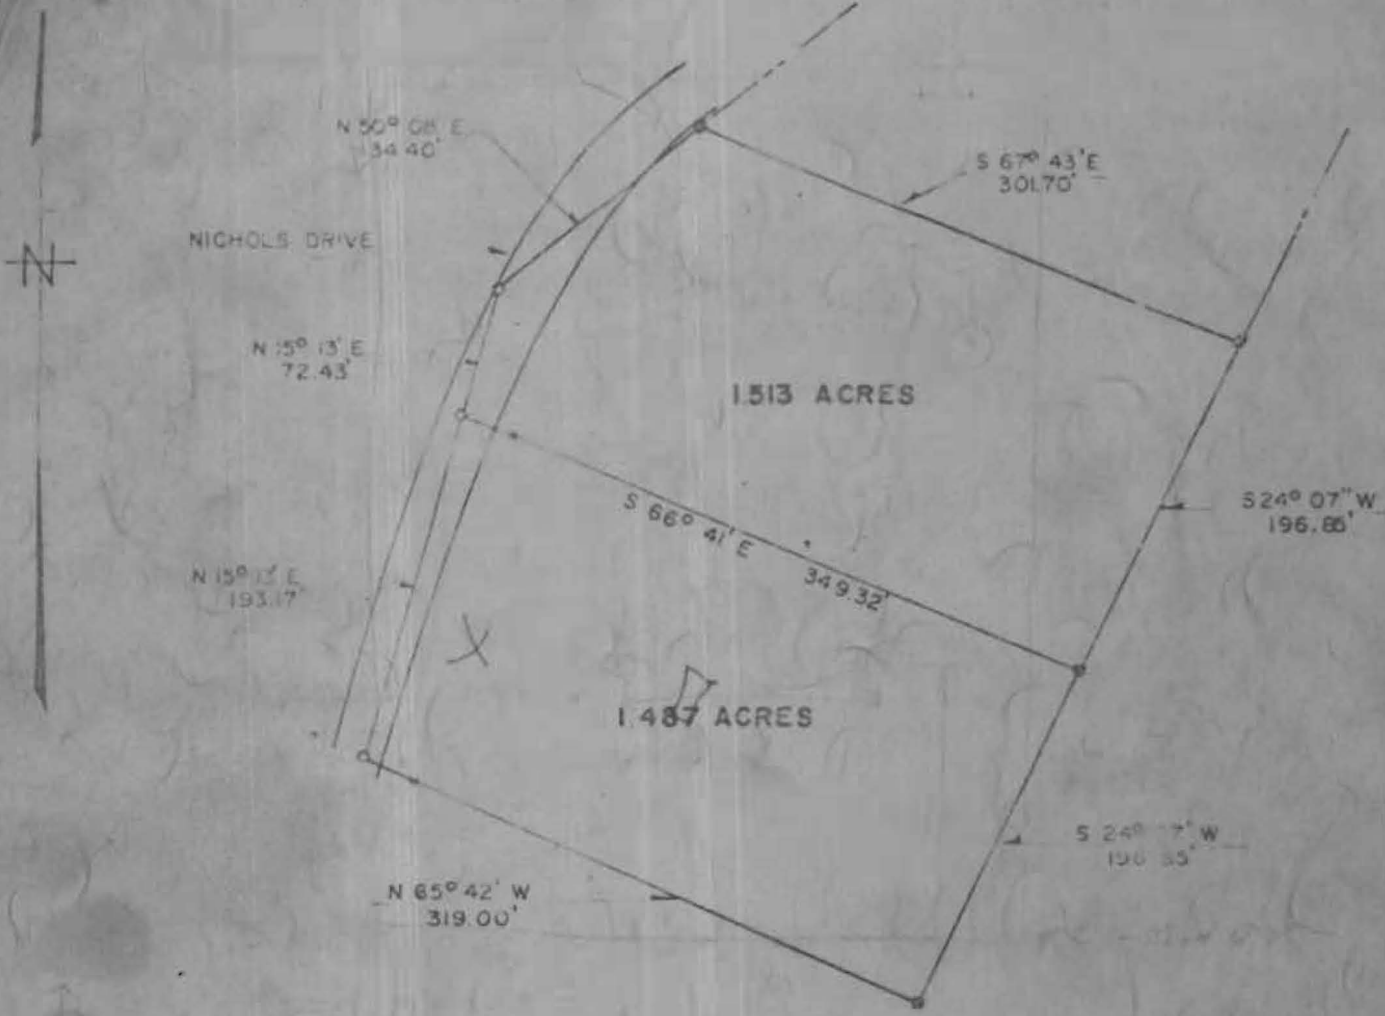

PLAT OF SURVEY
FOR
WOODROW JONES

FIFTH ELECTION DISTRICT OF HOWARD COUNTY
CLARKSVILLE, MARYLAND
SCALE 1 IN. = 100 FT. JANUARY 21, 1960

Claude M. Skinner, Jr.
CLAUDE M. SKINNER, JR. REG. ENGR. & LAND SURVEYOR NO. 2237

NOTES

x DENOTES IRON PIPE

Wagner Wilson

Nichols Dr.

1 + 2 ⁱⁿ test 10 min. - 5 ft.

3rd hole 14 min. 1st inch
20 min. 2nd inch = 11 ft.

no water

May 14, 1965

Mr. Wayne H. Wilson
32 West Diamond Avenue
Gaithersburg, Maryland

RE: Property on Nichols Road
off Brighton Dam Road

Dear Mr. Wilson:

Tests conducted on the above property on August 27, 1964, September 4, 1964 and May 13, 1965, have shown the property to be unsuited for an individual sewage system. Therefore, your application for permission to install such a system on the property now has a final rejection.

Very truly yours,

Ronald Fletcher,
Sanitarian

RF: jr

September 9, 1964

Mr. Wayne H. Wilson
32 West Diamond Avenue
Gaithersburg, Maryland

RE: Property on Nichols Road
off Brighton Dam Road

Dear Mr. Wilson:

Tests conducted on the above property on August 27, 1964 and September 4, 1964, have shown the property to be unsuited for an individual sewage system. Therefore, your application for permission to install such a system on the property is being rejected.

Very truly yours,

Ronald Fletcher,
Sanitarian

RF:jr