

APPLICATION

A 24611

SEWAGE DISPOSAL TESTING

P _____

STATE OF MARYLAND - DEPARTMENT OF HEALTH AND MENTAL HYGIENE

HOWARD COUNTY HEALTH DEPARTMENT
ENVIRONMENTAL HEALTH SERVICES
P. O. BOX 476, ELLICOTT CITY, MARYLAND 21043
TELEPHONE: 465-5000, EXT. 356

DISTRICT 5th

DATE Oct. 27, 1976



TO: THE COUNTY HEALTH OFFICER
ELLICOTT CITY, MARYLAND

I, HEREBY, APPLY FOR THE NECESSARY TEST IN ORDER TO CONSTRUCT (OR RECONSTRUCT) A SEWAGE DISPOSAL SYSTEM.

PROPERTY OWNER Mr. Bokkil & Mrs. Jung Suk Chung

ADDRESS 5600 32th Street, N.W., Washington, D.C. 20015 PHONE 363-8242

PROPERTY LOCATION:

SUBDIVISION Nichols Drive LOT NO. _____

ROAD AND DESCRIPTION tar and chip road, Nichols Drive; 3 acres consisting of parcels no. 114 and 216; Liber 514 Folio 665 and Liber 514 Folio 663

SIZE OF LOT 3 acres TYPE BLDG. Residential
NUMBER OF BEDROOMS _____

IF NOT SINGLE RESIDENCE DESCRIBE _____

THE SYSTEM INSTALLED UNDER THIS APPLICATION IS ACCEPTABLE ONLY UNTIL PUBLIC FACILITIES BECOME AVAILABLE.

SIGNATURE OF APPLICANT Clinton J. Haught CLINTON J. HAUGHT
R.E. STRIMEL REAL ESTATE 596-5535

APPROVED BY _____ FOR _____ DATE _____
(KIND OF SYSTEM)


REJECTED BY _____ FOR _____ DATE _____
(KIND OF SYSTEM)

HOLD PENDING FURTHER TESTS _____ DATE _____

REASONS FOR REJECTION OR HOLDING _____

THIS IS NOT A PERMIT

all soils:
 clay
 12'

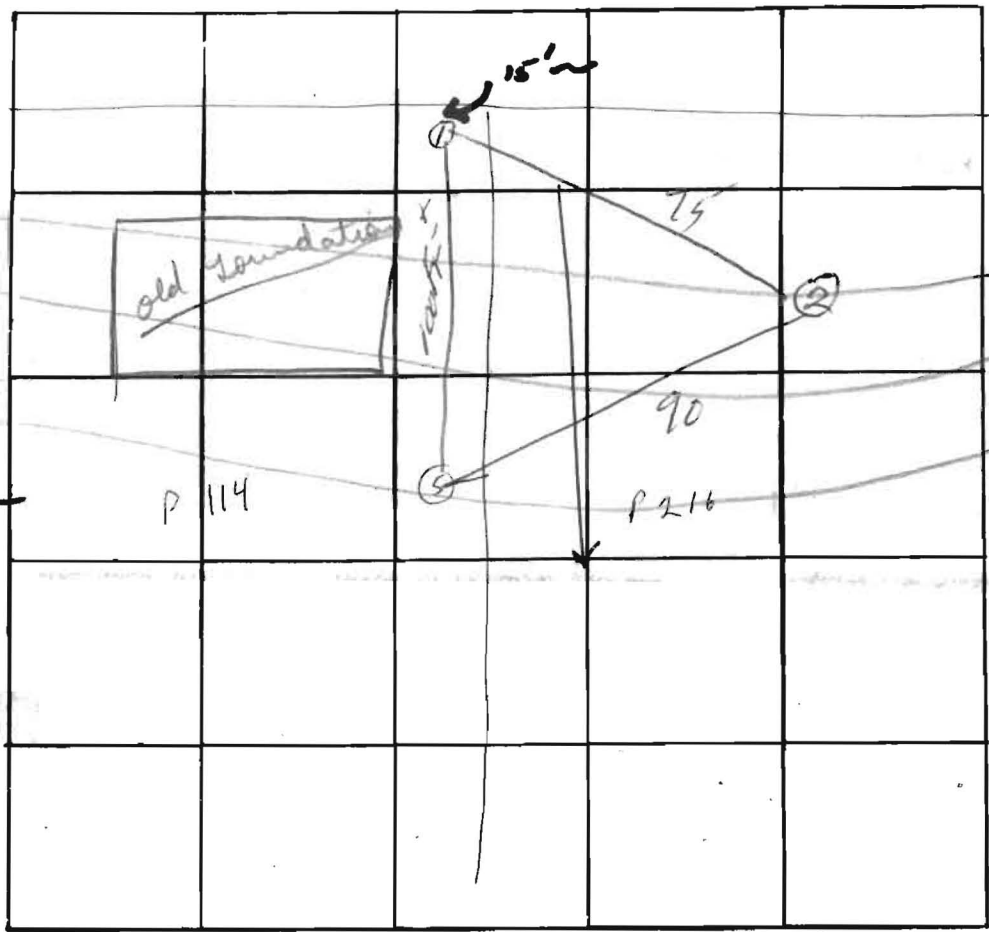

INDICATE NORTH. - NAME ADJOINING ROADWAY AS BASE LINE.

DATE	TEST NO.	DEPTH	PRE-WET		TEST - 1" DROP		TIME
			START	STOP	START	STOP	
12/29/16	1	2 1/2	1103	NO	PERK	30	min
	1a	12	1103	"	"	"	"
	2		Water @		12 ft		
	2a						
	3	No Test					
	3a						
	4	No Test					
	4a						
	5	water @ 10 1/2 feet					

REMARKS Test ended due to water and clay, indication
 TYPE OF SOIL that no area would give better tests due
water contour covering most of lot.
 TESTED BY R Briggs ALSO PRESENT: Sheel + Haught