


Approved Septic System Plan  
Howard County Health Department

total linear feet of trench required **840** feet  
width of trench(es) **3.9** feet  
depth of trench(es) **5.5** feet  
depth of stone required below distribution pipe **2.0** feet

*Lawrence McNeil*  
Signature  
Date

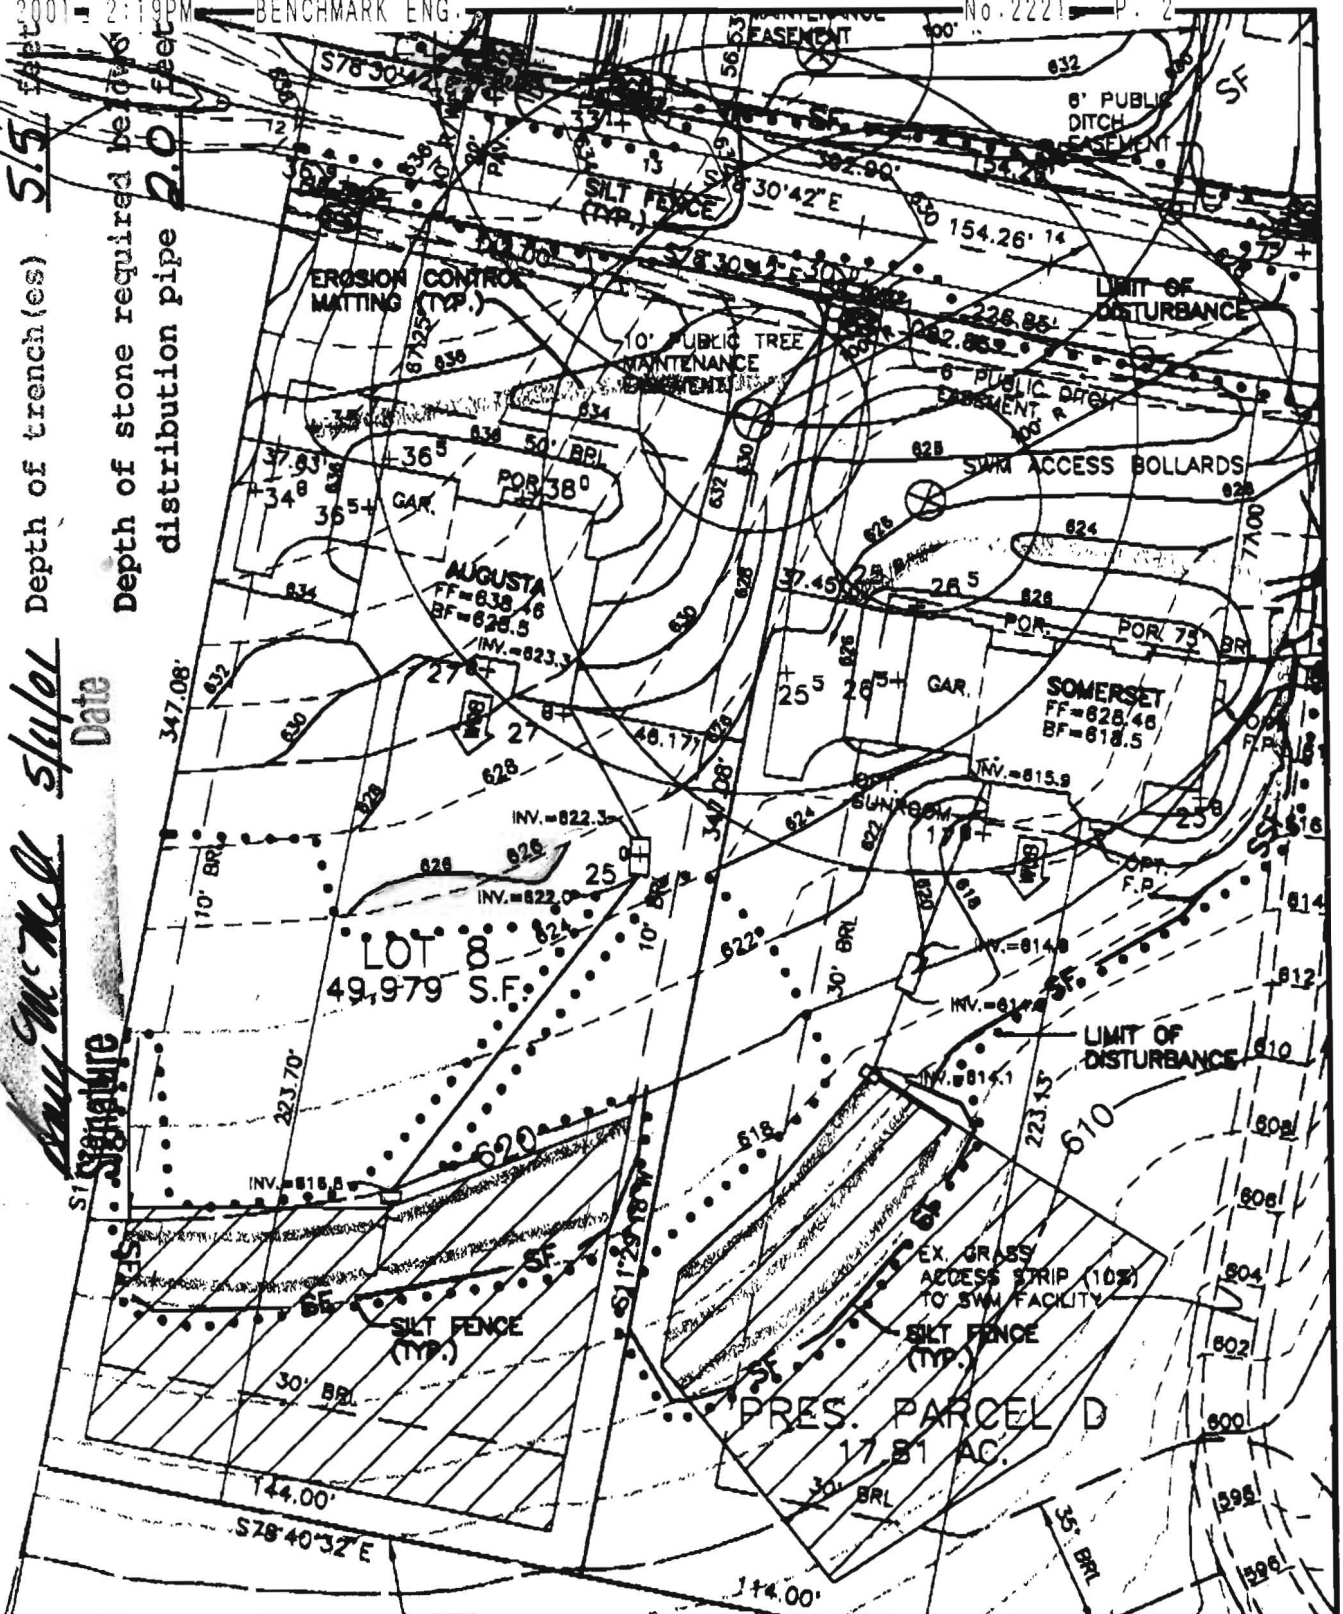

FIRST FLOOR ELEVATION = 638.46  
BASEMENT ELEVATION = 628.5  
SPOT ELEVATION AT GARAGE = 636.5

SLOPE OF DRIVEWAY = 5.2%  
NUMBER OF RISERS IN GAR. = 3  
NUMBER OF RISERS ON LEAD WALK = 3

**BENCHMARK**

**MONTICELLO  
LOT 8**



**ENGINEERING, INC.**

FOURTH ELECTION DISTRICT  
HOWARD COUNTY, MARYLAND.  
SCALE: 1" = 50' DATE: 4/20/01

8480 BALTIMORE NATIONAL PIKE • SUITE 418 • ELLICOTT CITY, MD 21043  
PHONE: 410-485-8105 FAX: 410-485-8844