

6/8/01
Layout = PM
6/22/01 - Final 2-3pm
8/15/01

PERMIT

SEWAGE DISPOSAL SYSTEM
HOWARD COUNTY HEALTH DEPARTMENT
BUREAU OF ENVIRONMENTAL HEALTH
410-313-2640

P 515242

A 59914-A

ISSUE DATE 5/11/2001

APPROVAL DATE 8/31/01

INDEXED

04-363698

Fogles Septic Clean Inc

IS PERMITTED TO INSTALL ALTER

ADDRESS 580 Obrecht Road, Sykesville, MD 21784 PHONE 410-795-5670

UBDIVISION Monticello LOT NUMBER 25 ADDRESS 1733 Oakdale Drive

PROPERTY OWNER D R Horton Custom Homes PROPERTY OWNER'S ADDRESS 1370 Piccard Dr, #230

SEPTIC TANK CAPACITY 1500 GALLONS * **WATERTIGHT SEPTIC TANK REQUIRED *** (20850)

PUMP CHAMBER CAPACITY N/A GALLONS

NUMBER OF BEDROOMS 5

SQUARE FEET PER BEDROOM 180

LINEAR FEET OF TRENCH REQUIRED 225

TRENCHES: Trenches to be 2 feet wide. Inlet, 3 feet below original grade. Bottom maximum depth

7 feet below original grade. 4 feet of stone below distribution ~~box~~ pipe.

LOCATION: Place the distribution box 160 feet down the right lot line and 80 feet off this same lot line. Run (4) 56' trenches on contour, (2) in each direction.

2/13/01 OK (BB)

PLANS APPROVED Mark Rifkin, R.S.

DATE 2/7/2001

PERMIT VOID AFTER 2 YEARS

NOTE: CONTRACTOR RESPONSIBLE FOR SCHEDULING A PRE-CONSTRUCTION INSPECTION FOR ALL INSTALLATIONS

NOTE: TOP OF SEPTIC TANKS ARE TO BE NO DEEPER THAN 3.0 FEET BELOW FINISH GRADE

NOTE: WATERTIGHT SEPTIC TANKS REQUIRED

NOTE: CLEANOUT REQUIRED EVERY 70 FEET OF SEWER LINE AND/OR AT 90° SWEEPS IN LINES FROM HOUSE TO DRAIN FIELDS, 90° ELBOWS ARE NOT ACCEPTABLE

NOTE: ALL PARTS OF SEPTIC SYSTEMS (I.E. TANK, DISTRIBUTION BOX, DRAINFIELDS) TO BE 100 FEET FROM ANY WATER WELL UNLESS OTHERWISE SPECIFICALLY AUTHORIZED

NOTE: NO ABSORPTION TRENCH TO EXCEED 100 FEET IN LENGTH UNLESS SPECIFICALLY AUTHORIZED

NOTE: ALL PIPE FROM HOUSE TO SEPTIC TANK MUST BE CAST IRON OR SCHEDULE 35/40 PVC OR ABS

NOTE: MANHOLE RISERS REQUIRED ON ALL SEPTIC TANKS AND PUMP CHAMBERS

NOTE: DISTRIBUTION BOXES MUST HAVE BAFFLES


NOTE: IF PUMPED SEPTIC SYSTEM REQUIRED, (1) SEPTIC PUMP DETAIL TO BE PROVIDED BY INSTALLER PRIOR TO ISSUANCE OF SEPTIC PERMIT (2) PUMP PERFORMANCE TEST IS NECESSARY PRIOR TO HEALTH DEPARTMENT APPROVAL OF SEPTIC PERMIT

OLD PERMIT SIGNED AND RETURNED 8/30/01
B00132213 - deck

515242

NEITHER THE HOWARD COUNTY COUNCIL NOR THE HEALTH DEPARTMENT IS RESPONSIBLE FOR THE SUCCESSFUL OPERATION OF ANY SYSTEM
PERMITTEE RESPONSIBLE FOR OBTAINING FINAL APPROVAL ON THIS PERMIT
CALL 410-313-2640 FOR INSPECTION OF SEPTIC SYSTEM

NOT TO SCALE

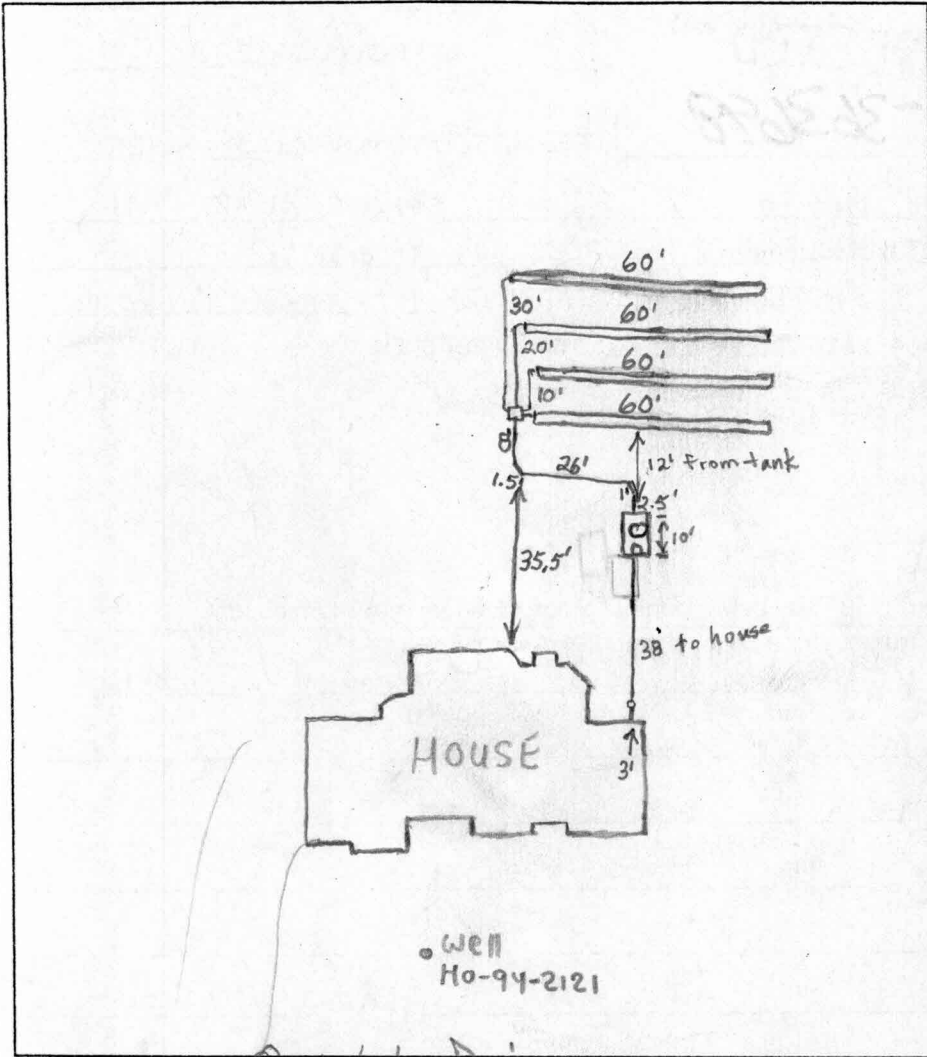

TRENCH DATA

TRENCH WIDTH 2'
 TRENCH INLET DEPTH 3'
 TRENCH BOTTOM DEPTH 7'
 DEPTH OF STONE 4'
 NUMBER OF TRENCHES 4
 TOTAL TRENCH LENGTH 240'
 ABSORBENT AREA 960 sq ft
 DISTRIBUTION BOX LEVEL Yes
 BAFFLE IN DISTRIBUTION BOX Yes

SEPTIC TANK DATA

SEPTIC TANK 1500TS GALLONS
 MANHOLE RISER on center
 6 INCH INSPECTION PORT Yes

PUMP CHAMBER DATA N/A

~~PUMP CHAMBER GALLONS _____~~
~~MANHOLE RISER _____~~
~~ALARM _____~~
~~PUMP PERFORMANCE TEST _____~~

Oakdale Drive

PRE-CONSTRUCTION INSPECTION: 6/8/01 Easement not staked. Builder notified (BB)

6/21/01 - OK TO RUN 4 - 60' TRENCHES TOWARDS RIGHT LOT LINE (SRK)

INSPECTION COMMENTS: 6/21/01 - TANKS SET (SRK) 6/22/01 O.K. to cover. Need

house connection. (BB) 8/31/01 - HOUSE CONNECTION VERIFIED TO HAVE BEEN

MADE BY BUILDER (SRK)

INSPECTOR Steven R. Krieg

DATE SYSTEM APPROVED 8/31/01