


FIRST FLOOR ELEVATION = 627.26
 BASEMENT ELEVATION = 617.30
 SPOT ELEVATION AT GARAGE = 625.3

BENCHMARK

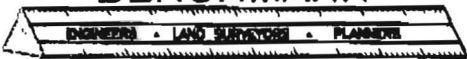

ENGINEERING, INC.

8480 BALTIMORE NATIONAL PIKE • SUITE 418 • ELICOTT CITY, MD 21043
 PHONE: 410-485-6105 FAX: 410-485-6644

SLOPE OF DRIVEWAY = 4.0% AT GAR.
 NUMBER OF RISERS IN GAR. = 3
 NUMBER OF RISERS ON LEAD WALK = 3

MONTICELLO

LOT 9

FOURTH ELECTION DISTRICT
 HOWARD COUNTY, MARYLAND

SCALE: 1" = 50' DATE: 3/21/01

Total linear feet of trench
 required 240 feet

Width of trench(es) ³ 2.0 feet

Depth of trench(es) ⁵ 6.0 feet

Depth of stone required below
 distribution pipe 3.0 feet

2

Approved Septic System Plan
 Howard County Health Department

[Signature] 5/14/01
 Signature Date

40
40
180
60
20