

2/20/01 Layout anytime

2/21/01 necessary to use conn. all

2/21/01 - PM

RPS# ?

PERMIT
SEWAGE DISPOSAL SYSTEM
 HOWARD COUNTY HEALTH DEPARTMENT
 BUREAU OF ENVIRONMENTAL HEALTH
 410-313-2640

P 514937-W

A 59915-W

ISSUE DATE 2/16/01

APPROVAL DATE 5/24/01

INDEXED

Fogles Septic Clean Inc IS PERMITTED TO INSTALL INSTALL ALTER

ADDRESS 580 Obrecht Road, Sykesville, MD 21784 PHONE 410-795-5670

SUBDIVISION Monticello LOT NUMBER 21 ADDRESS 1749 Oakdale Drive

PROPERTY OWNER D R Horton Custom Homes PROPERTY OWNER'S ADDRESS 1370 Piccard Dr, Ste 230
Rockville, MD 20850

SEPTIC TANK CAPACITY 1250 GALLONS

PUMP CHAMBER CAPACITY N/A GALLONS

NUMBER OF BEDROOMS 4

SQUARE FEET PER BEDROOM 180

LINEAR FEET OF TRENCH REQUIRED 240

(TOP SEAM)
***** WATERTIGHT SEPTIC TANK REQUIRED *****

TRENCHES: Trenches to be 3 feet wide. Inlet, 3 feet below original grade. Bottom maximum depth 5 feet below original grade. 2 feet of stone below distribution box.

LOCATION: Place the distribution box 80 feet from the left lot line and 95 feet from the rear lot line. Run trenches on contour in either direction.

PLANS APPROVED Mark Rifkin, R.S. OK SRK 11/30/00 DATE 11/14/2000

PERMIT VOID AFTER 2 YEARS


- NOTE: CONTRACTOR RESPONSIBLE FOR SCHEDULING A PRE-CONSTRUCTION INSPECTION FOR ALL INSTALLATIONS
- NOTE: TOP OF SEPTIC TANKS ARE TO BE NO DEEPER THAN 3.0 FEET BELOW FINISH GRADE
- NOTE: WATERTIGHT SEPTIC TANKS REQUIRED
- NOTE: CLEANOUT REQUIRED EVERY 70 FEET OF SEWER LINE AND/OR AT 90° SWEEPS IN LINES FROM HOUSE TO DRAIN FIELDS, 90° ELBOWS ARE NOT ACCEPTABLE
- NOTE: ALL PARTS OF SEPTIC SYSTEMS (I.E. TANK, DISTRIBUTION BOX, DRAINFIELDS) TO BE 100 FEET FROM ANY WATER WELL UNLESS OTHERWISE SPECIFICALLY AUTHORIZED
- NOTE: NO ABSORPTION TRENCH TO EXCEED 100 FEET IN LENGTH UNLESS SPECIFICALLY AUTHORIZED
- NOTE: ALL PIPE FROM HOUSE TO SEPTIC TANK MUST BE CAST IRON OR SCHEDULE 35/40 PVC OR ABS
- NOTE: MANHOLE RISERS REQUIRED ON ALL SEPTIC TANKS AND PUMP CHAMBERS
- NOTE: DISTRIBUTION BOXES MUST HAVE BAFFLES
- NOTE: IF PUMPED SEPTIC SYSTEM REQUIRED, (1) SEPTIC PUMP DETAIL TO BE PROVIDED BY INSTALLER PRIOR TO ISSUANCE OF SEPTIC PERMIT (2) PUMP PERFORMANCE TEST IS NECESSARY PRIOR TO HEALTH DEPARTMENT APPROVAL OF SEPTIC PERMIT

NEITHER THE HOWARD COUNTY COUNCIL NOR THE HEALTH DEPARTMENT IS RESPONSIBLE FOR THE
 SUCCESSFUL OPERATION OF ANY SYSTEM
 PERMITTEE RESPONSIBLE FOR OBTAINING FINAL APPROVAL ON THIS PERMIT
 CALL 410-313-2640 FOR INSPECTION OF SEPTIC SYSTEM

0514937W

NOT TO SCALE

INDEXED

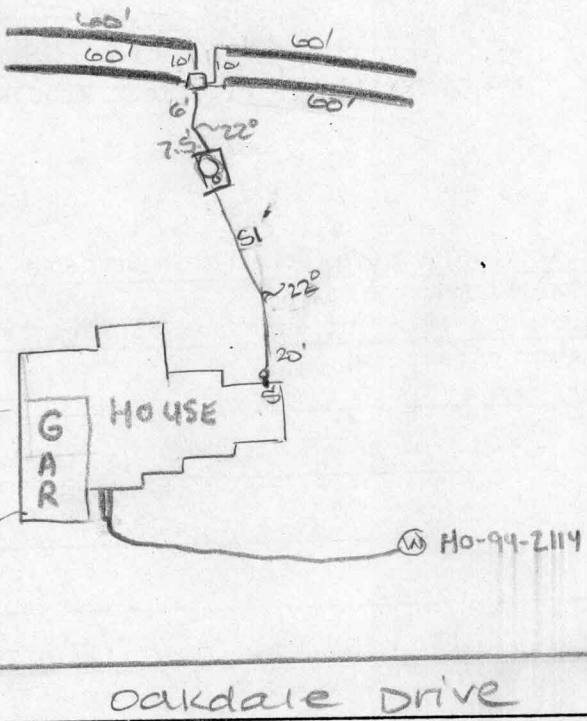

TRENCH DATA

TRENCH WIDTH 3'
 TRENCH INLET DEPTH 3'
 TRENCH BOTTOM DEPTH 5'
 DEPTH OF STONE 2'
 NUMBER OF TRENCHES 4'
 TOTAL TRENCH LENGTH 240'
 ABSORBENT AREA 720ft²
 DISTRIBUTION BOX LEVEL ✓
 BAFFLE IN DISTRIBUTION BOX ✓

SEPTIC TANK DATA

SEPTIC TANK 1250 GALLONS
 MANHOLE RISER ✓
 6 INCH INSPECTION PORT ✓

PUMP CHAMBER DATA

~~PUMP CHAMBER GALLONS _____
 MANHOLE RISER _____
 ALARM _____
 PUMP PERFORMANCE TEST _____~~

PRE-CONSTRUCTION INSPECTION: 2/20/01 SDA staked - house plumbing to be raised to make correct d. box depth - OK to
 INSPECTION COMMENTS: continue. DKC
2/21/01 A.M. OK to continue work. DKC
2/21/01 P.M. OK to cover all septic work - Needs house connection verified prior to final approval. DKC
5/24/01 - HOUSE CONN. VERIFIED TO HAVE BEEN MADE (TALKED TO MARTY FROM DR HORTON) (SRW)

INSPECTOR Steven R. Krieg DATE SYSTEM APPROVED 5/24/01