

PERMIT

SEWAGE DISPOSAL SYSTEM

MARYLAND STATE DEPARTMENT OF HEALTH

P 32357

A REPAIR

HOWARD COUNTY

BUREAU OF ENVIRONMENTAL HEALTH
992-2330

ELLICOTT CITY

DISTRICT _____

INDEX

DATE 12/9/82

Jack Fyock

IS PERMITTED TO INSTALL _____ ALTER X

ADDRESS _____ PHONE _____

SUBDIVISION _____ ROAD 14854 Old Frederick Road LOT _____

PROPERTY OWNER Dr. Honaski R. J. Honaski phone 442-2804

ADDRESS 14854 Old Frederick Road
Woodbine, Maryland

IF GARBAGE GRINDER IS USED INCREASE SEPTIC TANK CAPACITY BY 50% AND ABSORPTION AREA BY 22%.

GARBAGE GRINDER? YES _____ NO _____

SEPTIC TANK CAPACITY _____ GALLONS NUMBER OF BEDROOMS 4

REPAIR - CALL FOR INSPECTION WHEN GROUND IS OPENED UP SO SANITARIAN CAN RECOMMEND REPAIR.

4 B.R. home soil ok below 25-5'2" of clayey loam 500 # trench ok F.S.

PLANS APPROVED BY Palmer F. Wine DATE 12/09/82

COVER NO WORK UNTIL INSPECTED AND APPROVED.

NEITHER THE HOWARD COUNTY COUNCIL NOR THE HEALTH DEPARTMENT IS RESPONSIBLE FOR THE SUCCESSFUL OPERATION OF ANY SYSTEM.

NOTE: IF TRENCH IS USED CALL FOR INSPECTION BEFORE AND AFTER PLACING GRAVEL IN TRENCH.

NOTE: NO DRY WELL SHALL EXCEED 15 FOOT IN DIAMETER. NO ABSORPTION TRENCH TO EXCEED 100 FEET IN LENGTH.

NOTE: ALL PIPE FROM HOUSE TO SEPTIC TANK MUST BE CAST IRON OR SCHEDULE 40 PVC OR ABS.

PERMIT VOID AFTER THREE YEARS.


NOTE: INSTALL STAND PIPE ON SEPTIC TANK AND DRY WELL. STAND PIPES MUST BE 6 INCHES IN DIAMETER. CAST IRON, CONCRETE OR TERRA COTTA, OR PVC OR ABS ACCEPTED. IF TOP OF SEPTIC TANK IS DEEPER THAN 3 FEET MANHOLE TO GRADE REQUIRED.

***INSTALLER IS RESPONSIBLE FOR OBTAINING FINAL APROVAL ON THIS PERMIT**

*CALL 992-2330 FOR INSPECTION OF SEPTIC SYSTEMS.

EH - 2-1082

X 32357

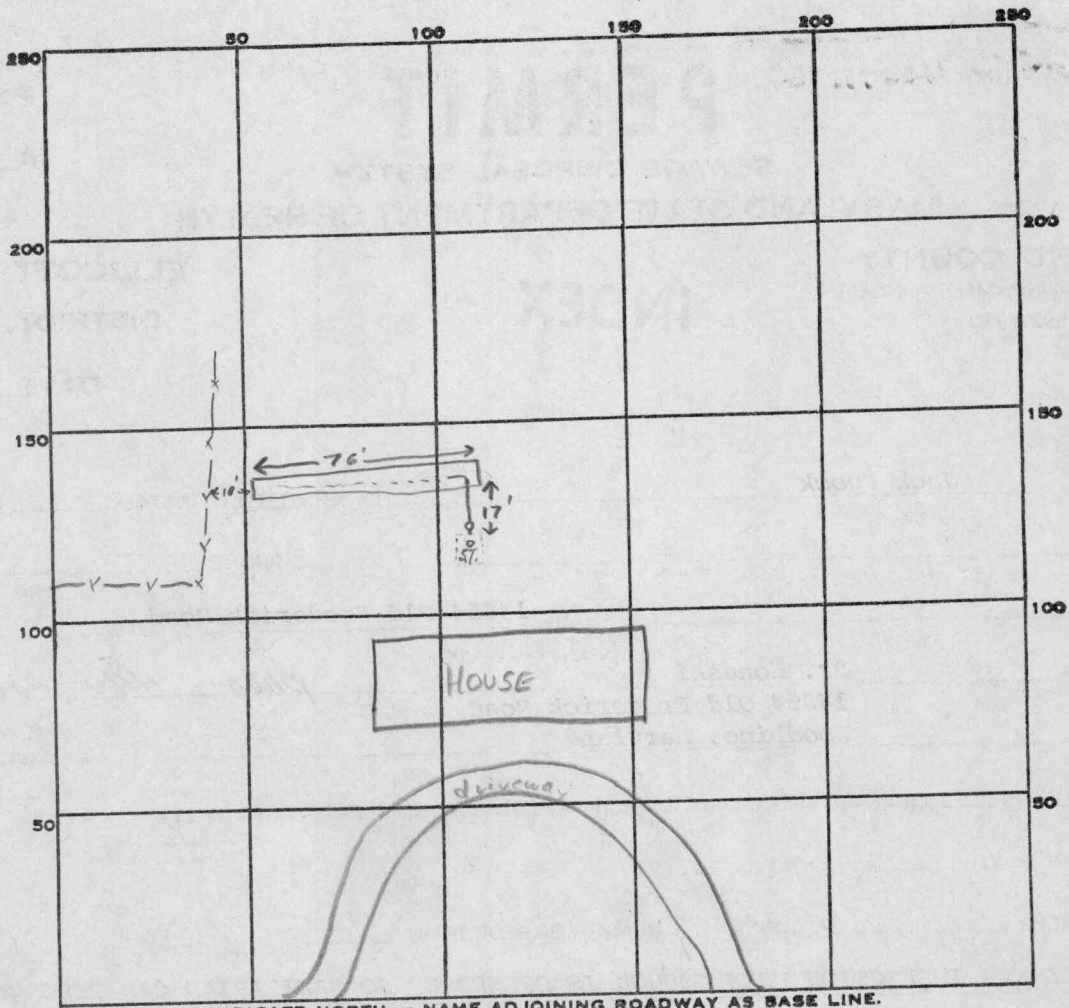

INDICATE NORTH. NAME ADJOINING ROADWAY AS BASE LINE.
 Old Fredrick Road

PERMIT CARD ✓ signed

SEPTIC TANK, LEVEL existing steel tank

CLEANOUTS S.T. / connecting line
existing / new pipe added

DISTRIBUTION BOX, LEVEL n.a.

TILE FIELD, DEPTH 13 FT. TRENCH WIDTH 2 FT.

GRAVEL DEPTH ~8 FT. TOTAL LENGTH 76 FT.

NUMBER OF TRENCHES 1 ONE SIDEWALL
 TOTAL BOTTOM AREA ±532

SEEPAGE PITS, INSIDE DIAMETER - FT. DEPTH BELOW INLET 7-8 FT.

ABSORBENT AREA ±532 SQ. FT.

REMARKS 12/9/82 work OK continuing 12/9/82 OK to comm all work JS.

DATE SYSTEM APPROVED 12/9/82

INSPECTOR F. Skinner