

APPLICATION

PERCOLATION TESTING

A 45354
P _____

HOWARD COUNTY HEALTH DEPARTMENT
BUREAU OF ENVIRONMENTAL HEALTH
P.O. BOX 476 ELLICOTT CITY, MARYLAND 21043
TELEPHONE: 461-9933

DISTRICT _____
DATE 12/12/89

TO: THE COUNTY HEALTH OFFICER
ELLICOTT CITY, MARYLAND

I HEREBY APPLY FOR THE NECESSARY TEST IN ORDER TO CONSTRUCT (OR RECONSTRUCT) A SEWAGE DISPOSAL SYSTEM.

PROPERTY OWNER SARAH STOUT

ADDRESS 15802 OLD FREDERICK RD WOODBINE, MD 21797 PHONE (301) 489-4836

PROSPECTIVE BUYER - N/A

ADDRESS _____ PHONE _____

PROPERTY LOCATION: Now Hong

SUBDIVISION STOUT PROPERTY LOTS 4-7 LOT NO. 4 1

ROAD AND DESCRIPTION SOUTH SIDE OF OLD FREDERICK RD 1300' EAST OF
RTE 94.

TAX MAP 7 PARCEL # 3

SIZE OF LOT 3.07 AC. TYPE BLDG. SINGLE
(SINGLE FAMILY DWELLING OR COMMERCIAL)

THE SYSTEM INSTALLED UNDER THIS APPLICATION IS ACCEPTABLE ONLY UNTIL PUBLIC FACILITIES BECOME AVAILABLE. I FULLY UNDERSTAND THE FEE CONNECTED WITH THE FILING OF THIS PERC TEST APPLICATION IS NON-REFUNDABLE UNDER ANY CIRCUMSTANCES. I ALSO AGREE TO COMPLY WITH ALL M.O.S.H.A. REQUIREMENTS IN TESTING THIS LOT. x Sarah Stout
(SIGNATURE OF APPLICANT)

APPROVED BY _____ FOR _____ DATE _____

REJECTED BY _____ FOR _____ DATE _____

HOLD PENDING FURTHER TESTS _____ DATE _____

REASONS FOR REJECTION OR HOLDING PERC OK - HOLD FOR PLAT MR. 1/12/90


THIS IS NOT A PERMIT

Lot 4

A45334

ALL HOLES SOIL PROFILE

3' 3/4
 brn & org clay loam
 deep org & brn sandy silt loam
 10-15% frags
 9'-10' HARD BOT

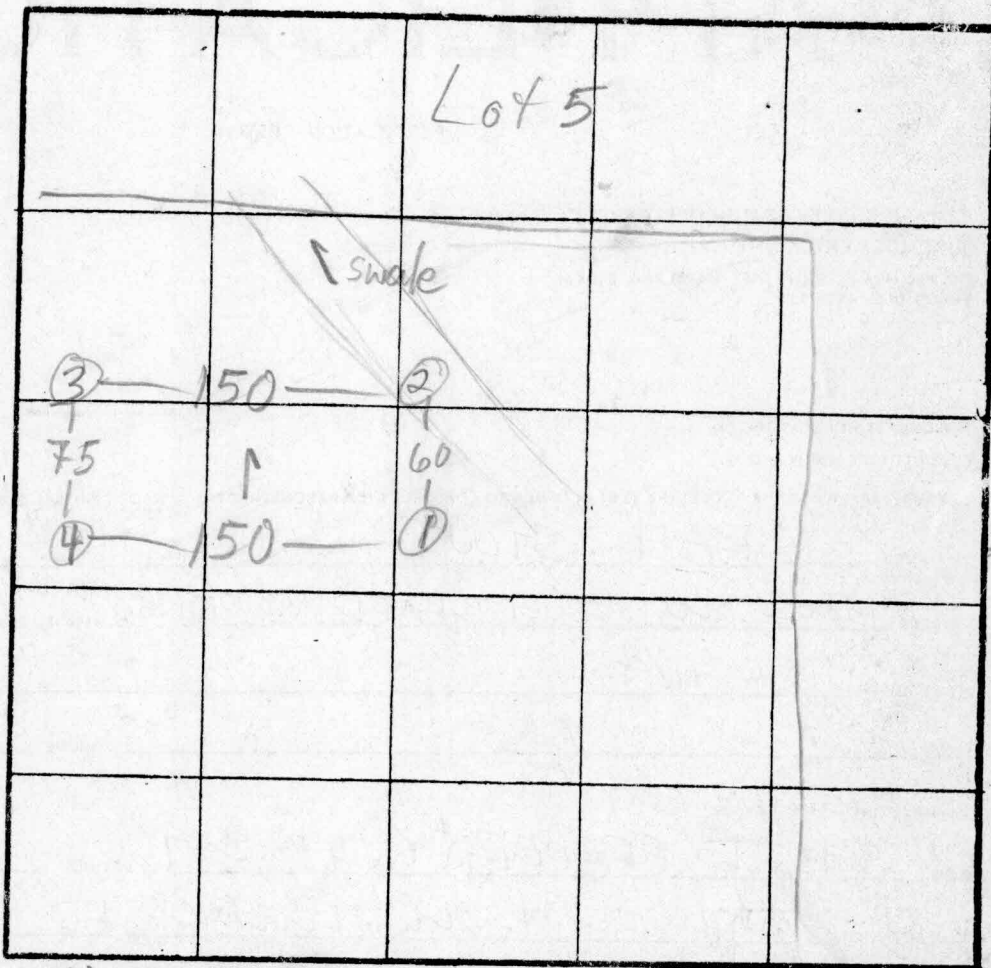

(1)(4) H1
 (2)(3) L0

$\bar{x} = 10$
 210 ABR
 Inlet 3 1/2'
 Bottom 5'

OLD FRED. RD INDICATE NORTH - NAME ADJOINING ROADWAY AS BASE LINE.


DATE	TEST NO.	DEPTH	PRE-WET		TEST - 1" DROP		TIME
			START	STOP	START	STOP	
11/2/90	1 S	4	10:59	11:03	11:03	11:28	25
	1 V	9	see profile				
	2 S	4	10:58	10:59	10:59	11:04	5
	2 V	9	see profile				
	3 V	10	OK 2 1/4 clay		10-15%	Frags	
	4 S	5	11:19	11:24	11:24	11:32	8
	4 M	7	11:18	11:19	11:19	11:21	2
	4 V	9	see profile				

REMARKS HOLES DUG PER PLAT - MOVE 30' UPHILL TO COMPENSATE FOR SWALE AND SHALLOW DEPTHS - SHALLOW ONLY

TYPE OF SOIL _____
 TESTED BY M. Riskin ALSO PRESENT Dave

EH-12-1079

Signed Perc Cert
1990

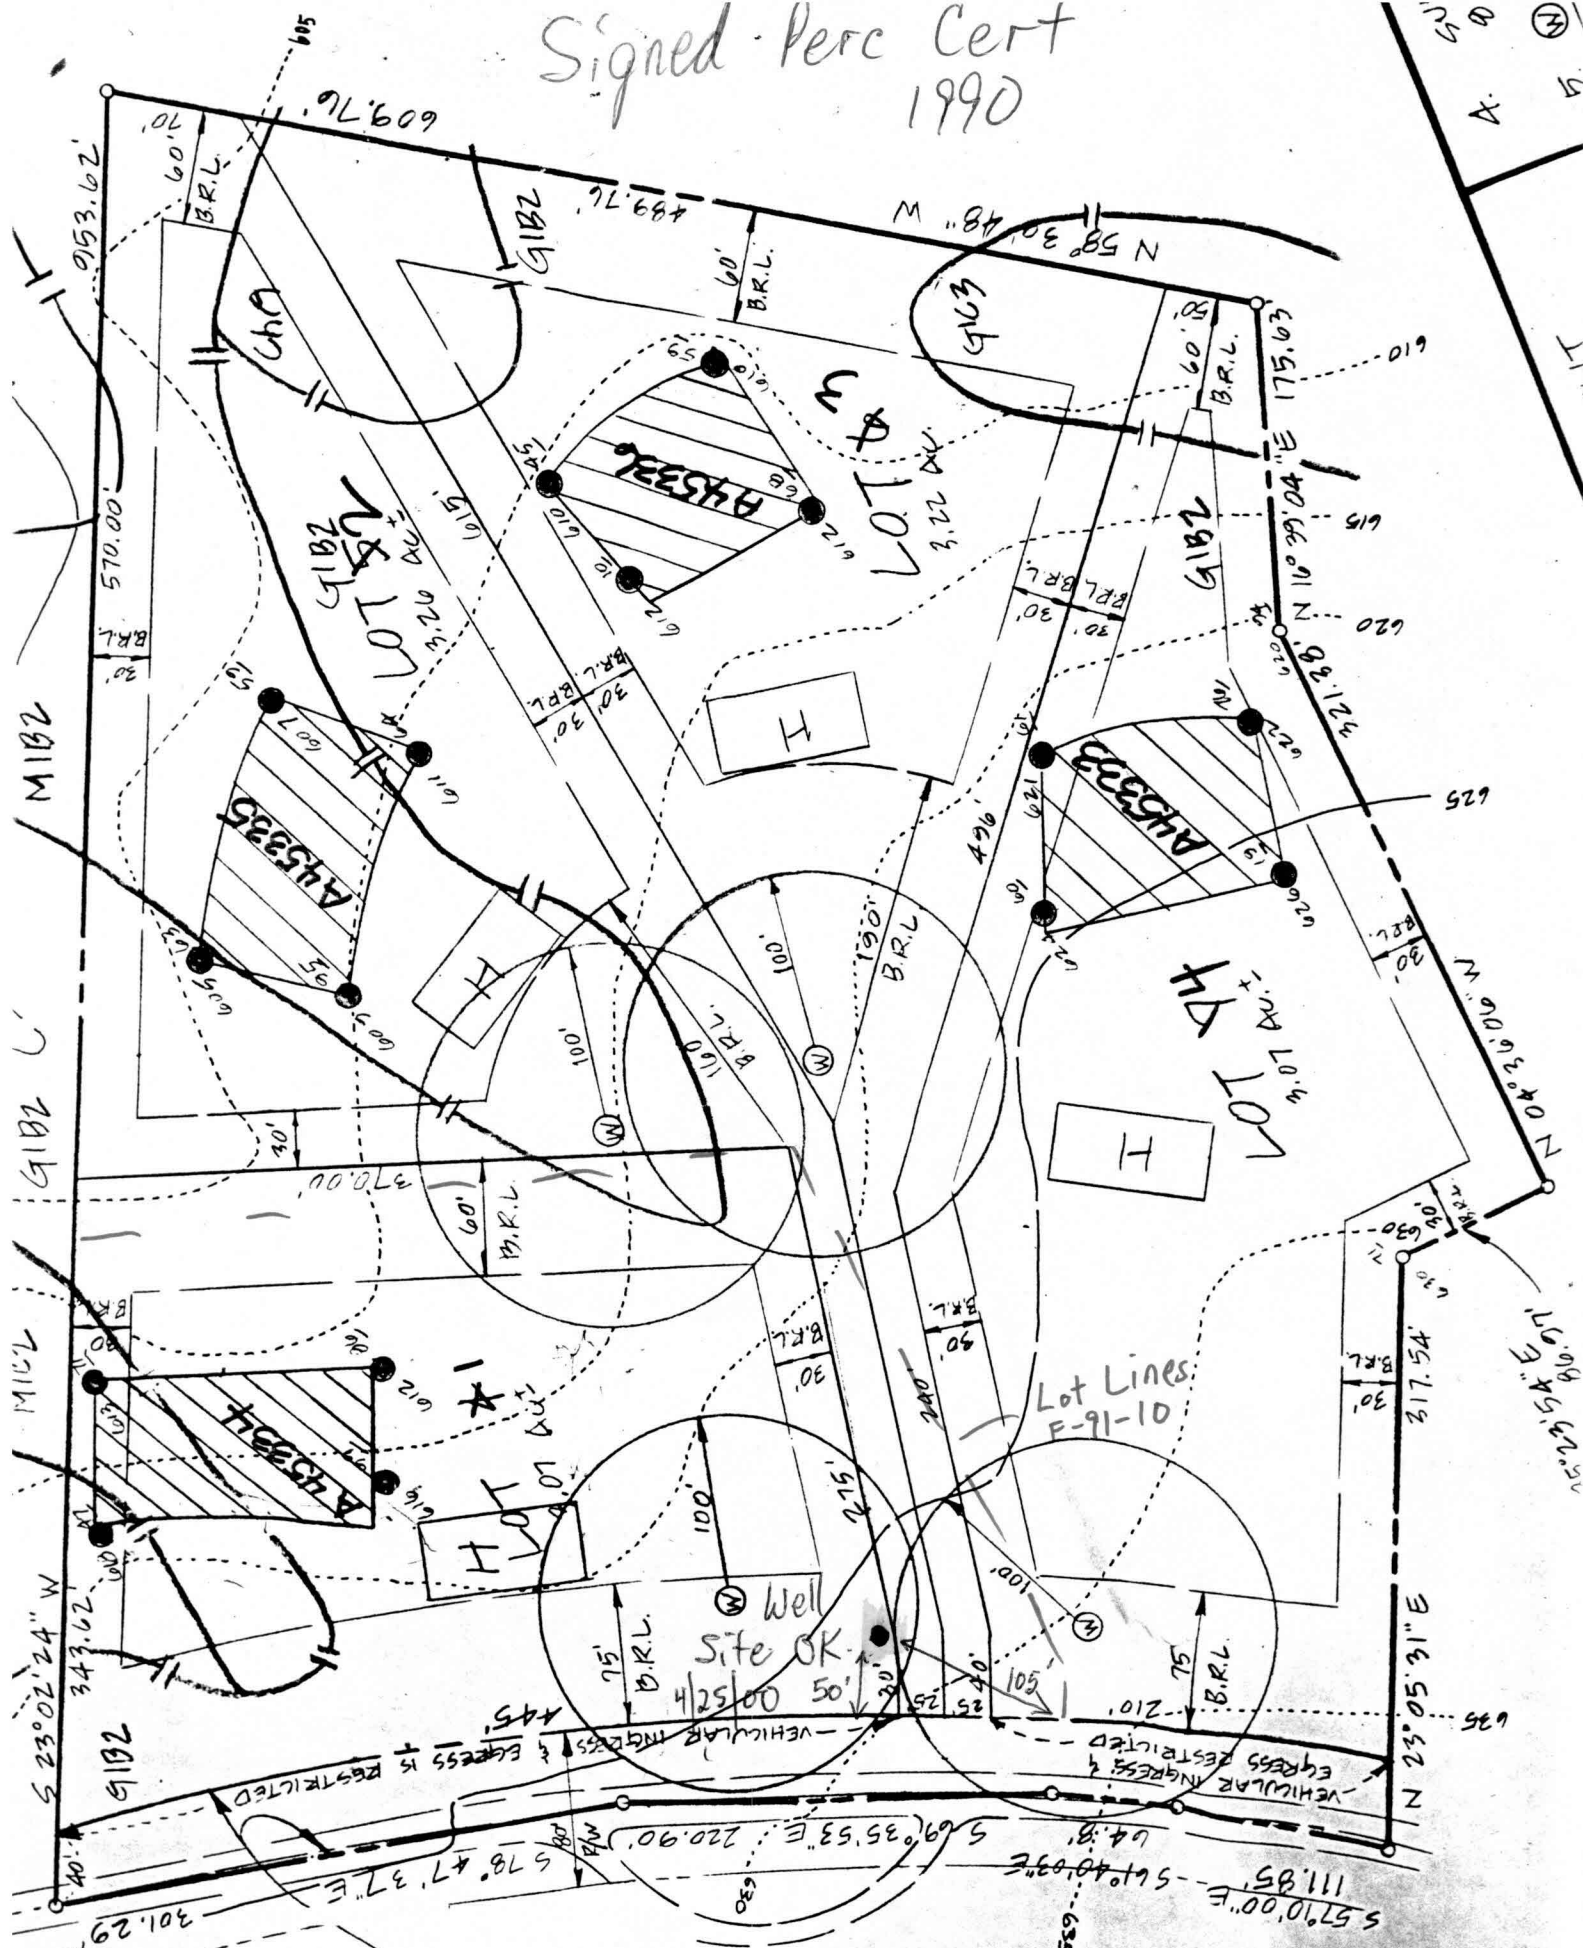

FREYERICK

5 SE OF
35 E OF
WARD

