

# APPLICATION

PERCOLATION TESTING

A 45332

P \_\_\_\_\_

HOWARD COUNTY HEALTH DEPARTMENT  
BUREAU OF ENVIRONMENTAL HEALTH  
P.O. BOX 476 ELLICOTT CITY, MARYLAND 21043  
TELEPHONE 461-9933

DISTRICT \_\_\_\_\_

DATE 12/12/89

TO: THE COUNTY HEALTH OFFICER  
ELLICOTT CITY, MARYLAND

I, HEREBY, APPLY FOR THE NECESSARY TEST IN ORDER TO CONSTRUCT (OR RECONSTRUCT) A SEWAGE DISPOSAL SYSTEM.

PROPERTY OWNER SARAH STOUT

ADDRESS 15802 OLD FREDERICK RD WOODBINE, MD 21797 PHONE (301) 489-4836

PROSPECTIVE BUYER N/A

ADDRESS \_\_\_\_\_ PHONE \_\_\_\_\_

PROPERTY LOCATION:

SUBDIVISION STOUT PROPERTY LOTS 1-3 LOT NO 2

ROAD AND DESCRIPTION NORTH SIDE OF OLD FREDERICK RD 1300' EAST OF  
RTE 94

TAX MAP 7 PARCEL # 99

SIZE OF LOT 3.96 ACRES TYPE BLDG SINGLE  
(SINGLE FAMILY DWELLING OR COMMERCIAL)

THE SYSTEM INSTALLED UNDER THIS APPLICATION IS ACCEPTABLE ONLY UNTIL PUBLIC FACILITIES BECOME AVAILABLE. I FULLY UNDERSTAND THE FEE CONNECTED WITH THE FILING OF THIS PERC TEST APPLICATION IS NON-REFUNDABLE UNDER ANY CIRCUMSTANCES. I ALSO AGREE TO COMPLY WITH ALL M.O.S.H.A. REQUIREMENTS IN TESTING THIS LOT.

Sarah Stout  
(SIGNATURE OF APPLICANT)

APPROVED BY \_\_\_\_\_ FOR \_\_\_\_\_ DATE \_\_\_\_\_

REJECTED BY \_\_\_\_\_ FOR \_\_\_\_\_ DATE \_\_\_\_\_

HOLD PENDING FURTHER TESTS \_\_\_\_\_ DATE \_\_\_\_\_

REASONS FOR REJECTION OR HOLDING PERC OK - HOLD FOR PLAT - MR 1/12/90


HD-216

# THIS IS NOT A PERMIT


A #45332

LOT #2

SOIL PROFILE

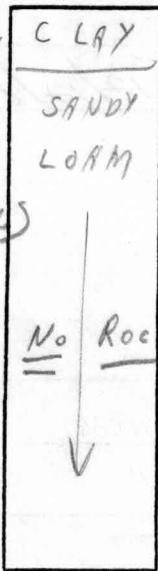

2B (No tests)

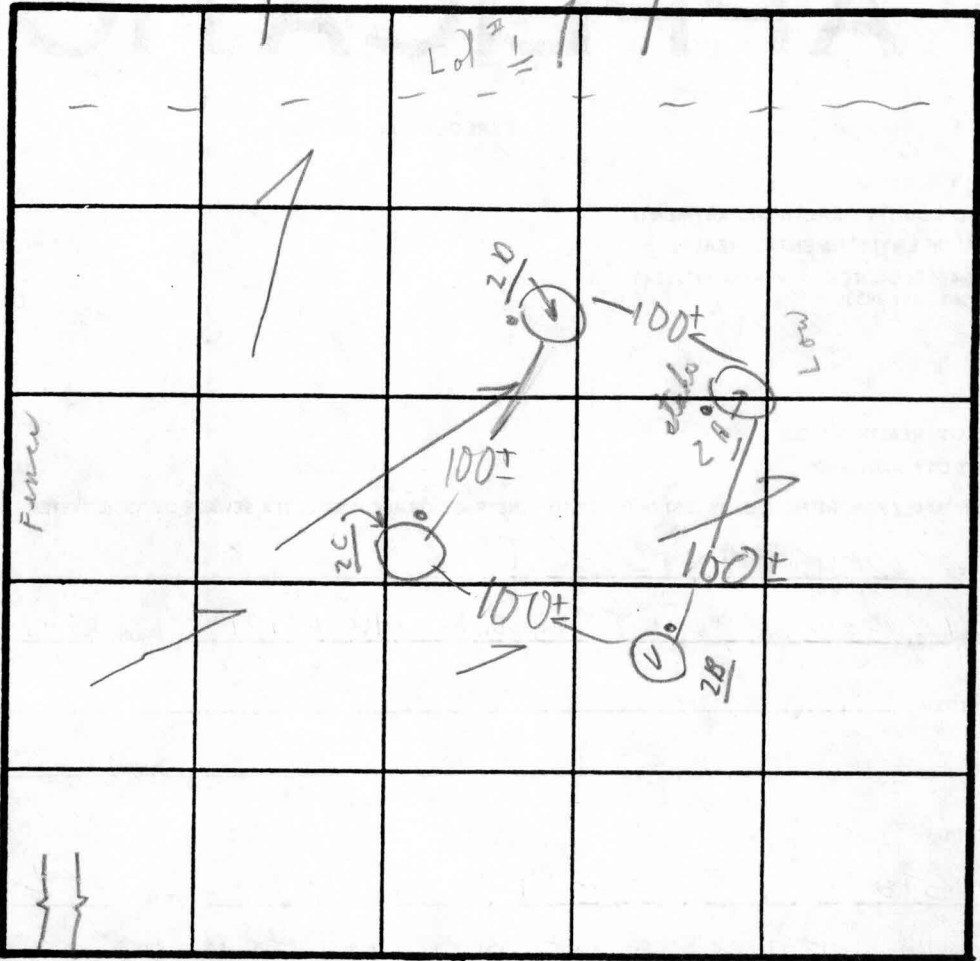

X 13 mi  
 Inlet 3'  
 (3' ← GOOD TO)

2C → 3 1/2' CLAY  
 LOAM 12'

2A 4' to 12'  
 70% LOAM  
 30% ± weathered shale

INDICATE NORTH - NAME ADJOINING ROADWAY AS BASE LINE.  
 OLD FRED ROAD

2D 0'-3 1/2' clay  
 3 1/2' LOAM  
 12'

DATE	TEST NO.	DEPTH	PRE-WET		TEST - 1" DROP		TIME
			START	STOP	START	STOP	
1/10/90	2C	3 1/2'	10:25	10:28	10:28	10:41	13 min
	2C	9 ft	10:24	10:27	10:27	10:36	9 min
	2B	4'	No tests				
	2B	12'	Visual		1-4 Clay light (NO ROCKS)		
	2A	4'	10:06	10:09	10:09	10:12	3 min
	2A	12'	Mostly loam		(30% ± weathered shale)		
	2D	3 1/2'	10:13	10:16	10:16	10:22	6 min
	2D	12'			LOAM Light colored		

12' deep

X=8  
 Inlet 3 1/2'  
 Bot 5 1/2'  
 210 BR

REMARKS: Tests per stake; 1/10/90 Tests in open, above a pond & at rear of existing lot with house.  
 TYPE OF SOIL: \_\_\_\_\_  
 TESTED BY: C.B.S. ALSO PRESENT: {O. Ketterman}



