

APPLICATION

PERCOLATION TESTING

A 45334
P _____

HOWARD COUNTY HEALTH DEPARTMENT
BUREAU OF ENVIRONMENTAL HEALTH
P.O. BOX 476 ELLICOTT CITY, MARYLAND 21043
TELEPHONE: 461-9933

DISTRICT _____
DATE 12/12/89

TO: THE COUNTY HEALTH OFFICER
ELLICOTT CITY, MARYLAND

I, HEREBY, APPLY FOR THE NECESSARY TEST IN ORDER TO CONSTRUCT (OR RECONSTRUCT) A SEWAGE DISPOSAL SYSTEM.

PROPERTY OWNER SARAH STOUT

ADDRESS 15802 OLD FREDERICK RD WOODBINE, MD 21797 PHONE (301) 489-4836

PROSPECTIVE BUYER - N/A

ADDRESS _____ PHONE _____

PROPERTY LOCATION: Hong
SUBDIVISION STOUT PROPERTY LOTS 4 THRU 7 LOT NO. 3

ROAD AND DESCRIPTION SOUTH SIDE OF OLD FREDERICK RD 1300' EAST OF ROUTE 94

TAX MAP 7 PARCEL # 3

SIZE OF LOT 3.22 TYPE BLDG. SINGLE
(SINGLE FAMILY DWELLING OR COMMERCIAL)

THE SYSTEM INSTALLED UNDER THIS APPLICATION IS ACCEPTABLE ONLY UNTIL PUBLIC FACILITIES BECOME AVAILABLE. I FULLY UNDERSTAND THE FEE CONNECTED WITH THE FILING OF THIS PERC TEST APPLICATION IS NON-REFUNDABLE UNDER ANY CIRCUMSTANCES. I ALSO AGREE TO COMPLY WITH ALL M.O.S.H.A. REQUIREMENTS IN TESTING THIS LOT. Sarah Stout
(SIGNATURE OF APPLICANT)

APPROVED BY _____ FOR _____ DATE _____

REJECTED BY _____ FOR _____ DATE _____

HOLD PENDING FURTHER TESTS _____ DATE _____

REASONS FOR REJECTION OR HOLDING PERC OK - HOLD FOR PLAT MR 1/12/90

THIS IS NOT A PERMIT


Lot 6
A45336

①③④
SOIL PROFILE

dk org
+ red
clay
loam
4
dk. org
brn
tan
silty
sand
loam
15% frags

3 1/2
4

10 1/2

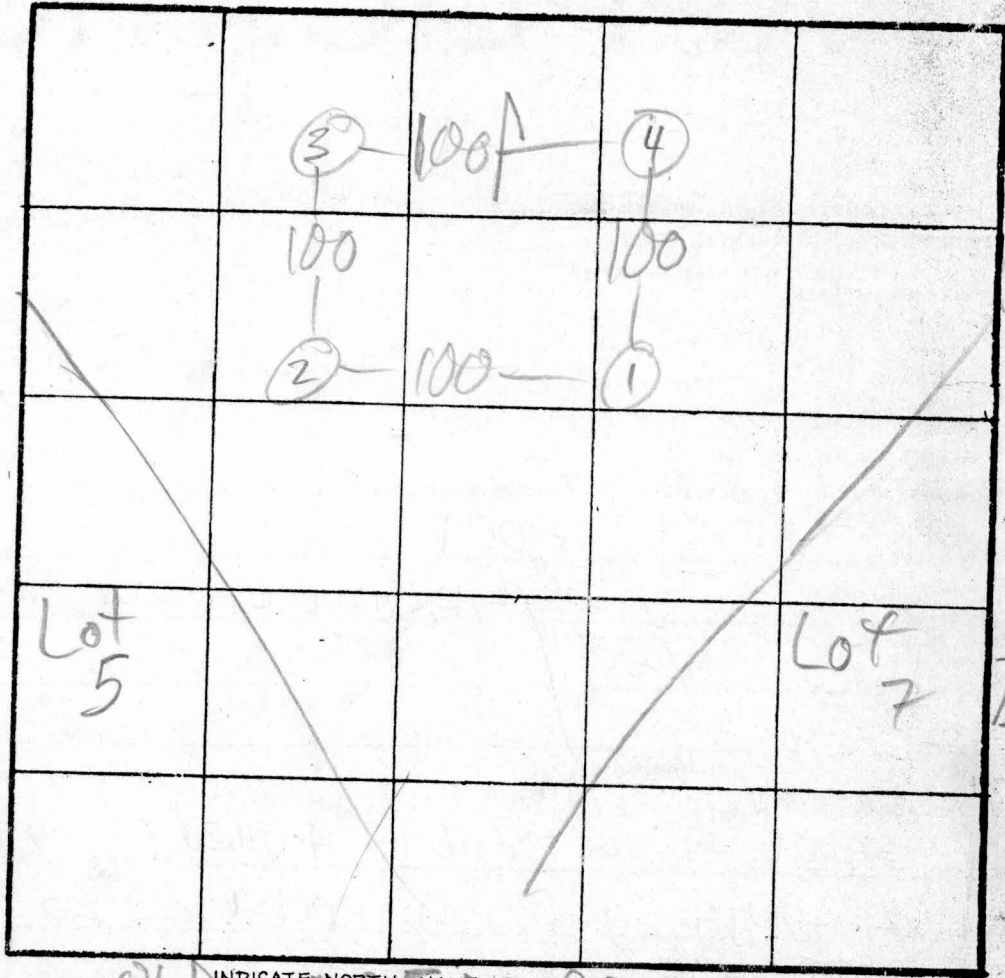


OLD HIGHWAY 1015
INDICATE NORTH NAME ADJOINING ROADWAY AS BASE LINE.

②
org
clay
loam
3
org
tan
sand
loam
25%
frags
HARD
BOT
9


DATE	TEST NO.	DEPTH	PRE-WET		TEST - 1' DROP		TIME
			START	STOP	START	STOP	
1/10/90	1 M	4 1/2	3:44	3:47	NO PERC	4:00	1.3
	1 V	10 1/2	see	PTO	file		
	2 S2	5	3:56	4:03	4:03	4:13	10
	2 V	9	OK 25% frags	see	profile		
	3 S	4 1/2	4:02	SLOW PERC			
	3 V	10 1/2	see	PTO	file		
	4 S	4	4:03	4:05	4:05	4:14	9
	4 V	10 1/2	see	profile			
	3 S2	5	4:22	4:25	4:25	4:31	6

REMARKS: HOLES PER PLAT, SHALLOW ONLY
 TYPE OF SOIL: M. Riffin
 TESTED BY: M. Riffin
 ALSO PRESENT: OK, Dave

Signed Perc Cert 1990

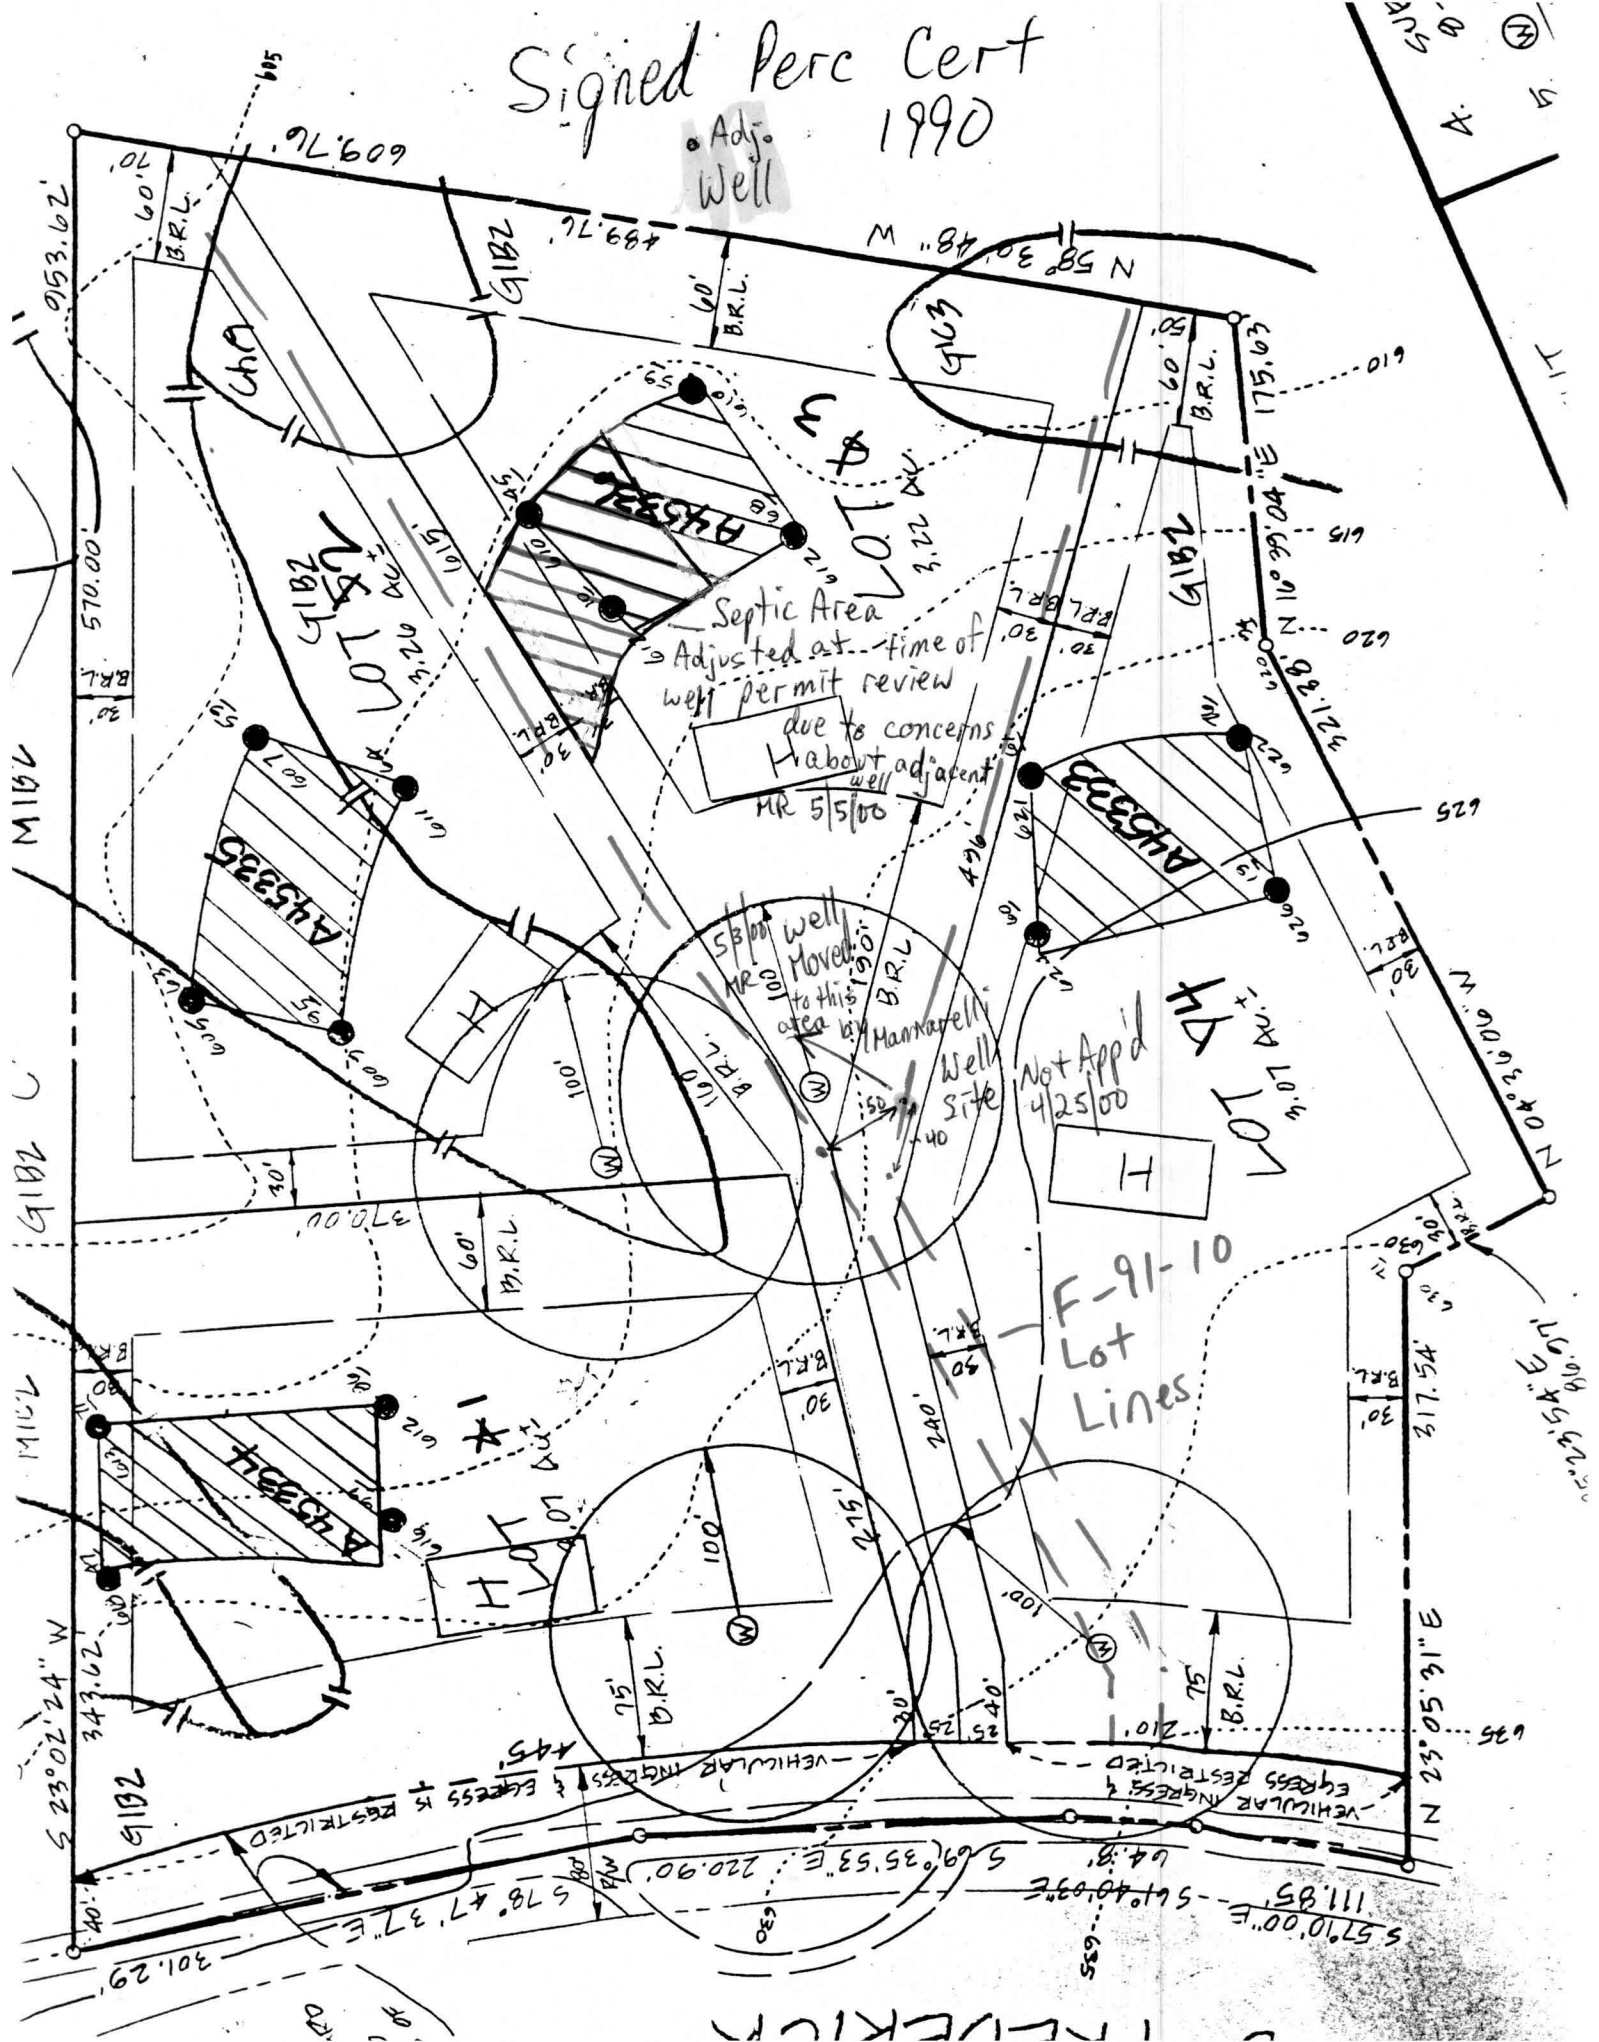

6/10/19
F-91-10 Hong Prop

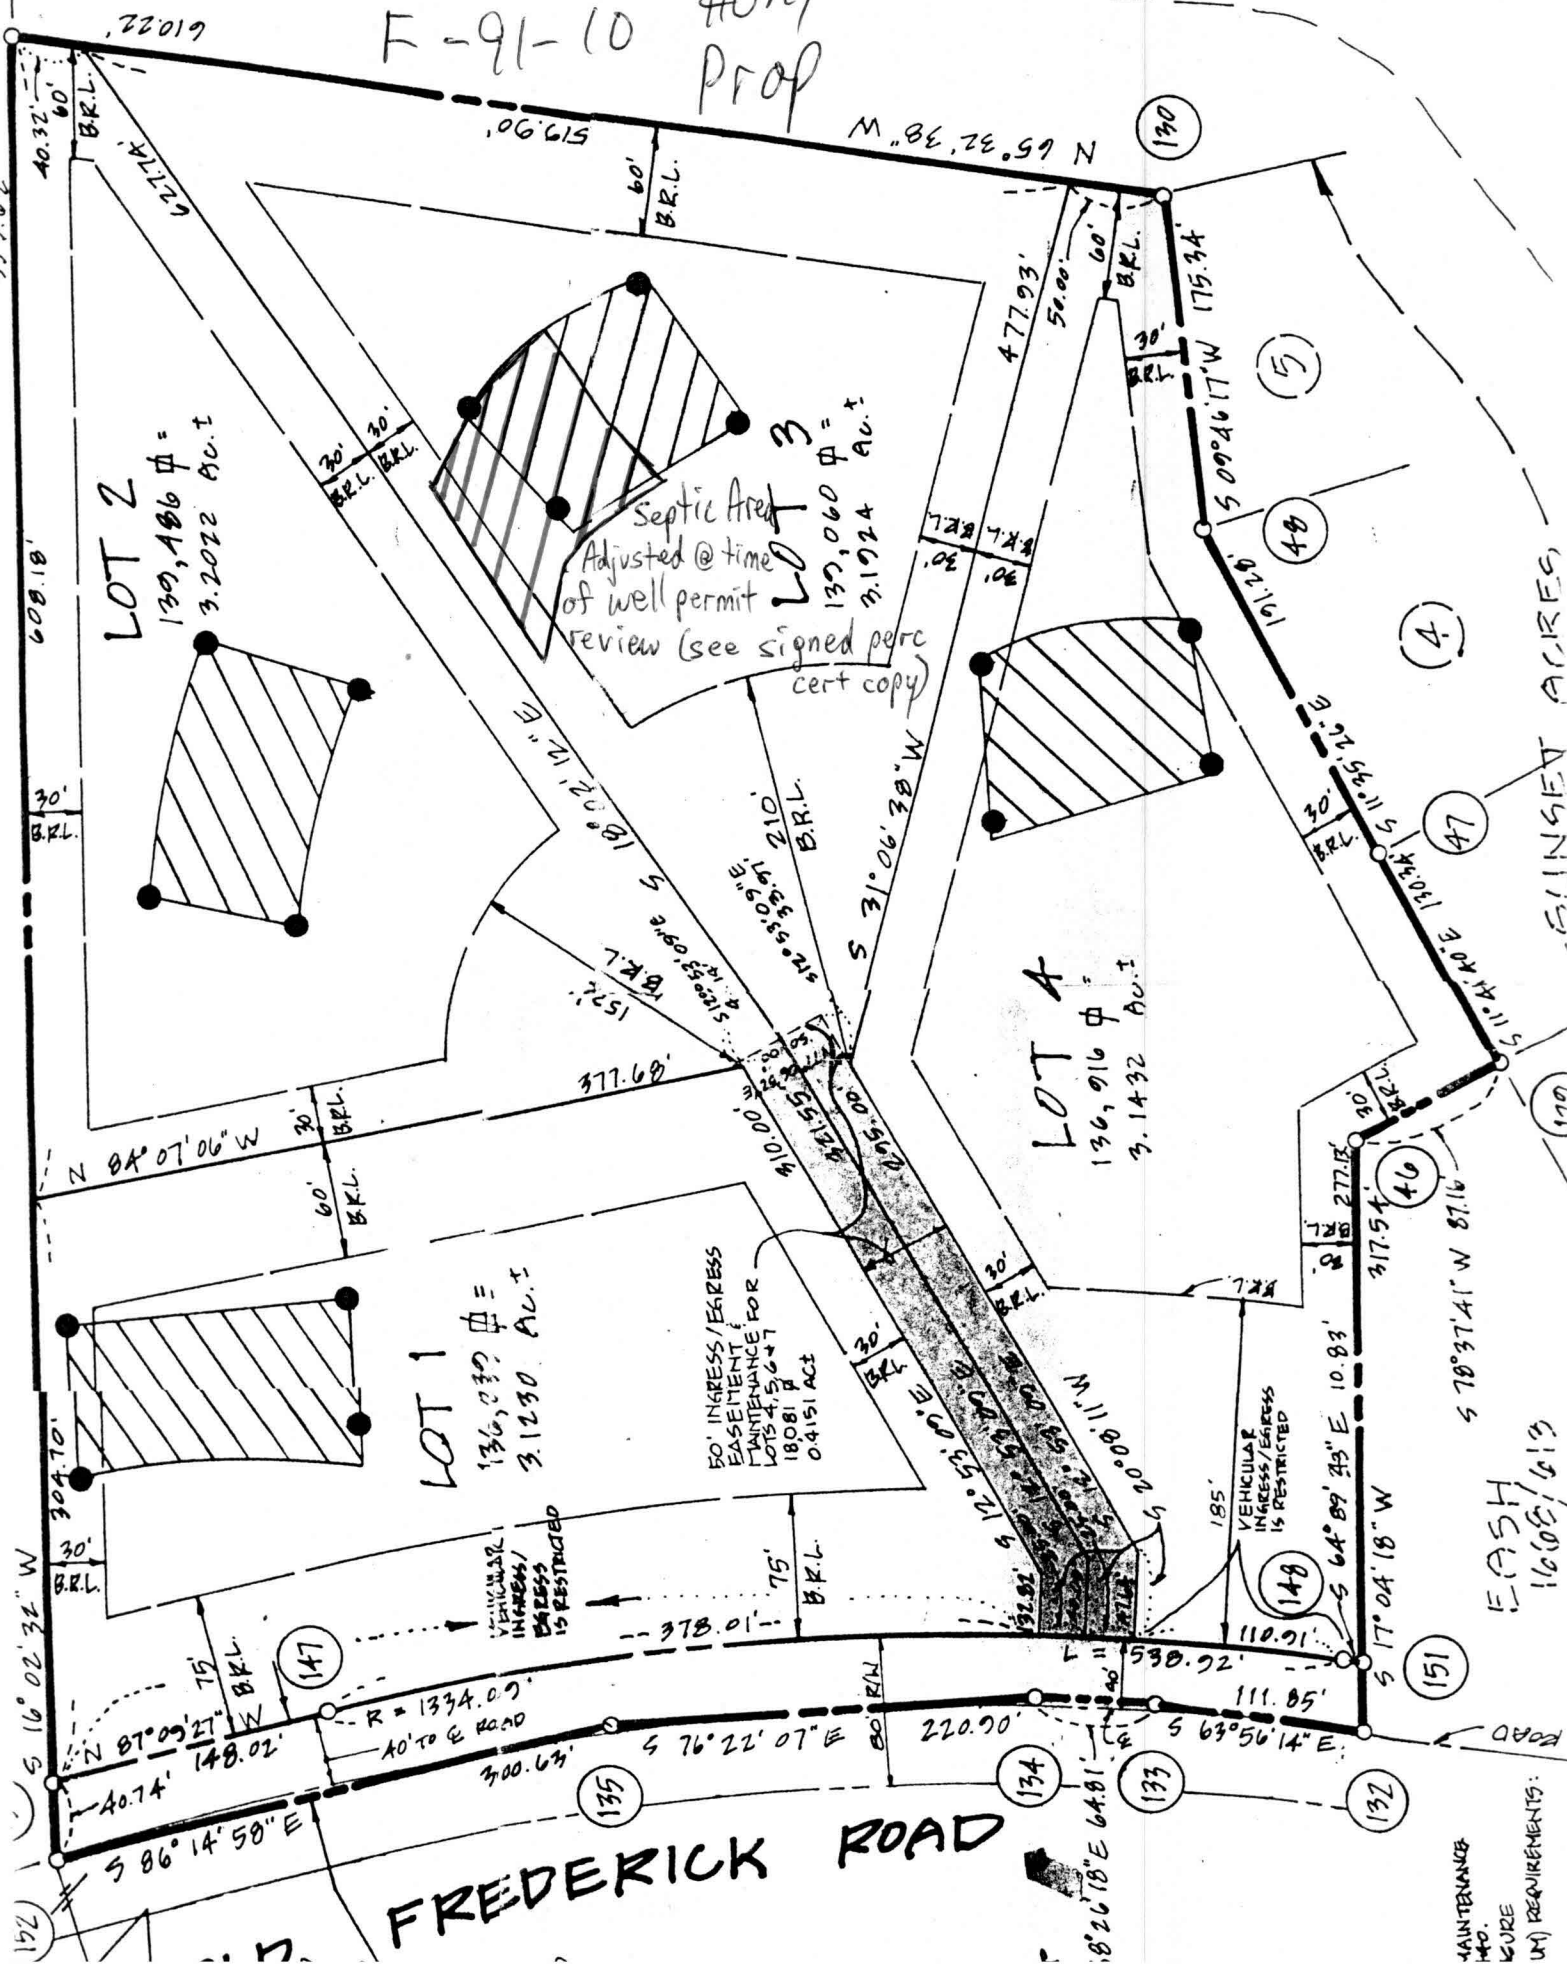

LOT 2
139,186 A.C.I.
3,2022 A.C.I.


LOT 1
136,030 A.C.I.
3,1230 A.C.I.

LOT 3
139,060 A.C.I.
3,1924 A.C.I.

LOT A
136,916 A.C.I.
3,1432 A.C.I.

Septic Area
Adjusted @ time
of well permit
review (see signed perc
cert copy)

50' INGRESS/EGRESS
EASEMENT FOR
MAINTENANCE FOR
LOTS 1, 2 & 3
18081 A.C.I.
04151 ACI

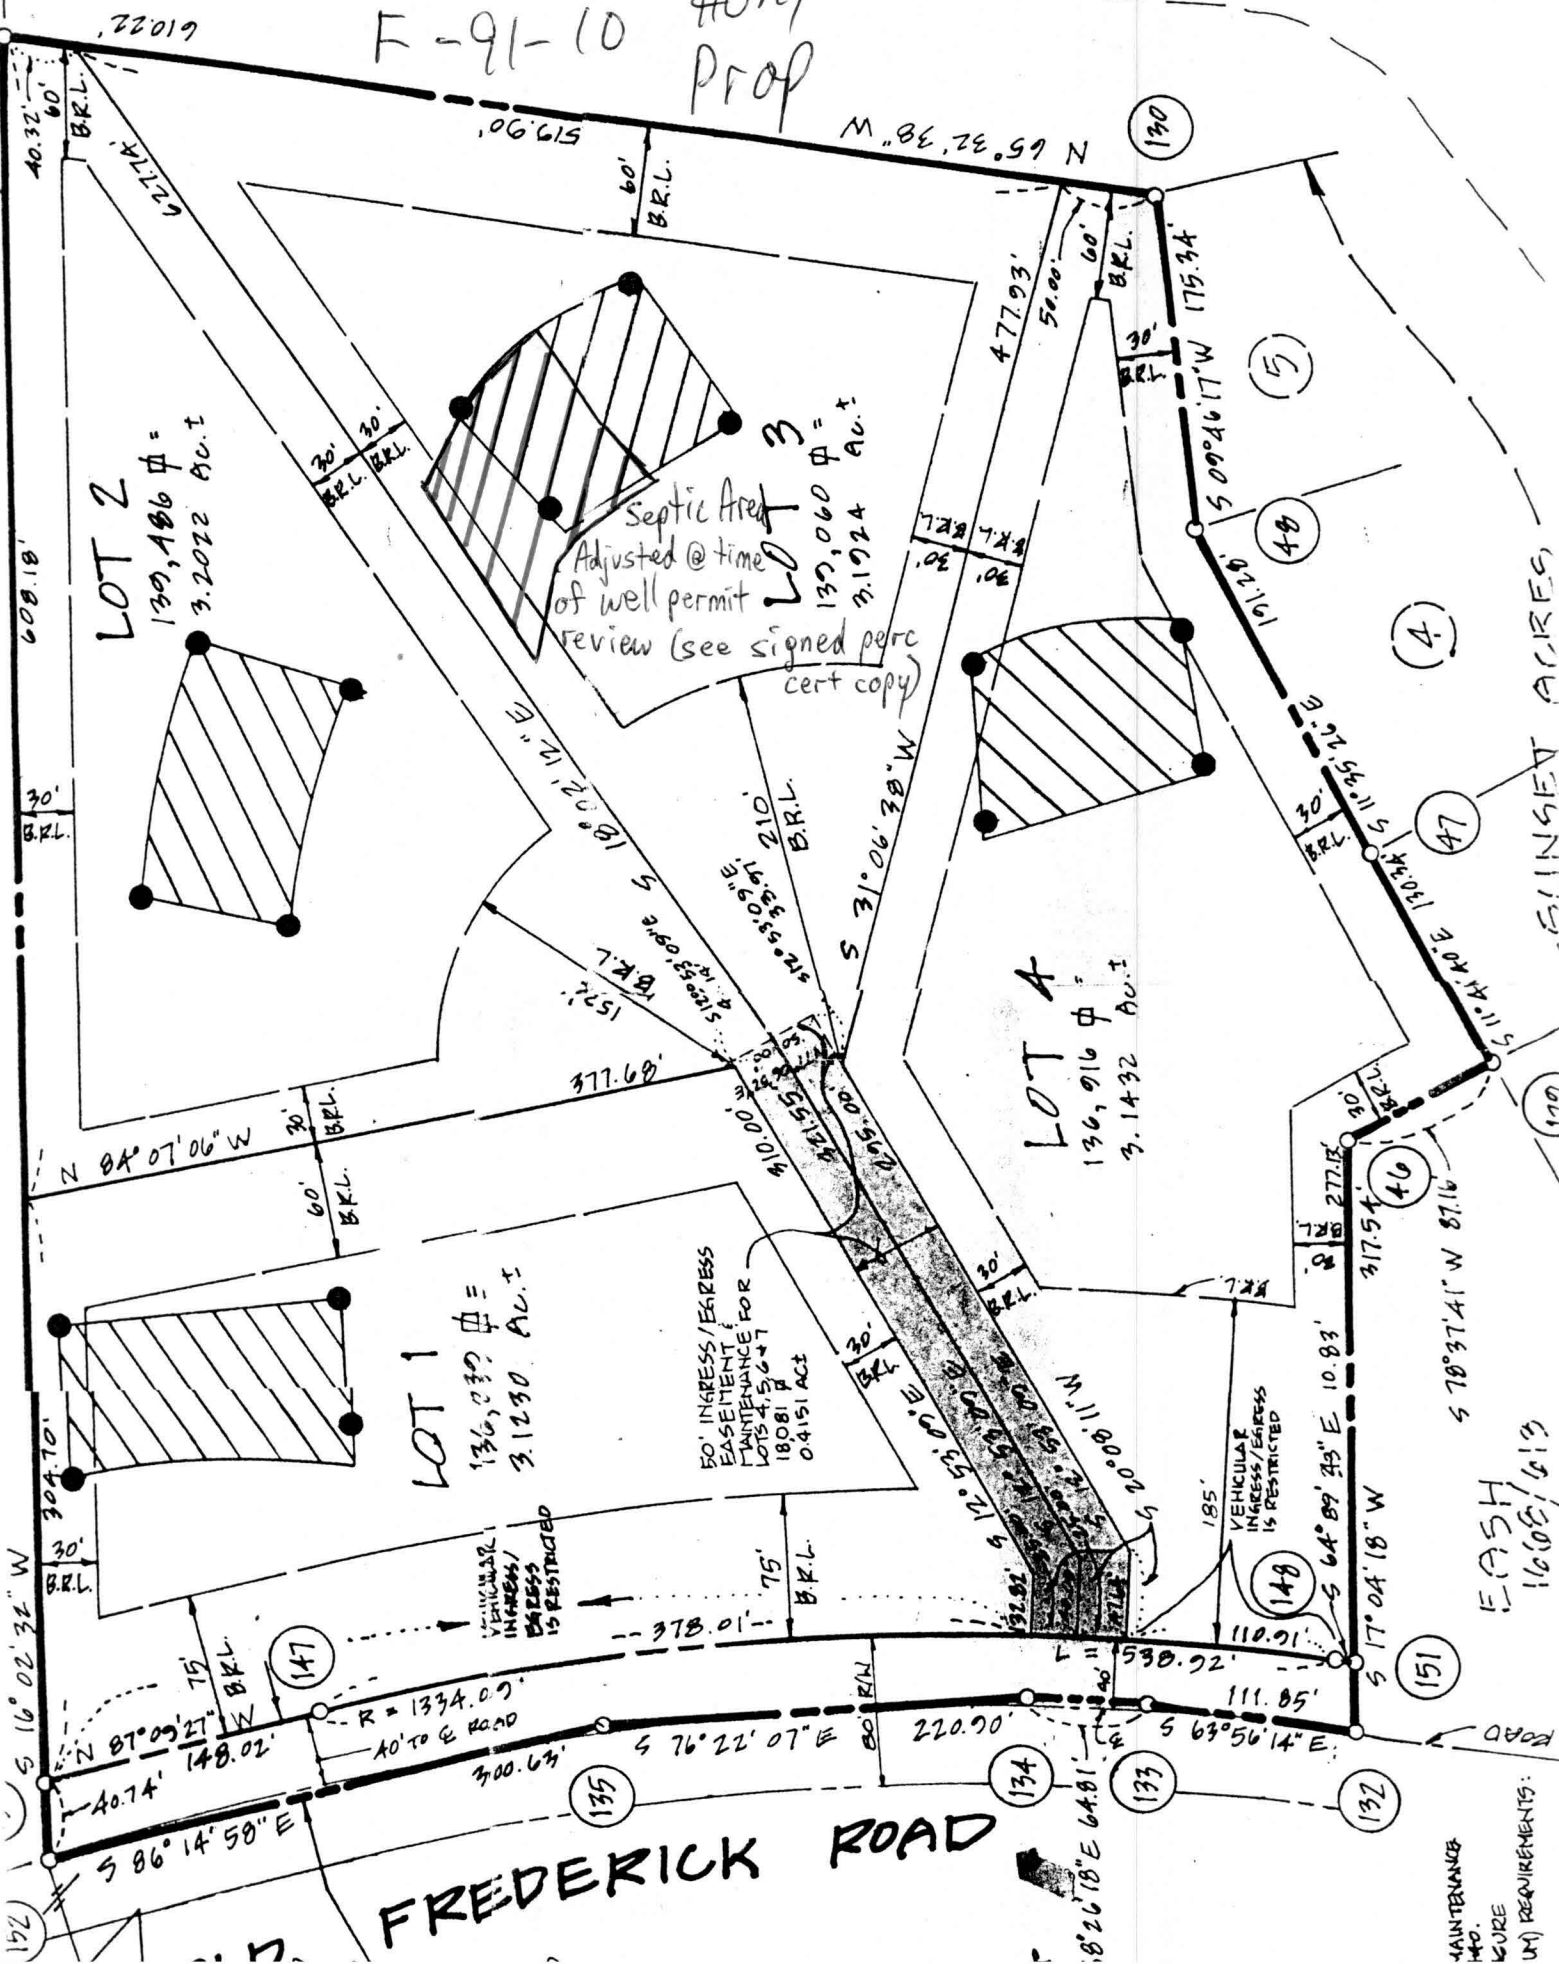

SINGLED ACRES

EASH
16/05/19

MAINTENANCE
REQ.
W/ REQUIREMENTS:

FREDERICK ROAD

