

6/24/01  
about am

04-352491

ISSUE DATE: 6/27/2001

APPROVAL DATE: 7/2/01

# PERMIT

## INDEXED

P 515307A

A 45336

### ON-SITE SEWAGE DISPOSAL SYSTEM HOWARD COUNTY HEALTH DEPARTMENT BUREAU OF ENVIRONMENTAL HEALTH

J Joseph Gartland IS PERMITTED TO INSTALL  ALTER

ADDRESS: 1835 West Old Liberty Road, Westminster PHONE NUMBER: 410-875-2400

SUBDIVISION: Hong Property LOT NUMBER: 3

ADDRESS: 15813 Old Frederick Road PROPERTY OWNER: Carrigan Homes

SEPTIC TANK CAPACITY (GALLONS): 1250  
1000 (TOP SEAM)

PUMP CHAMBER CAPACITY (GALLONS): 1000 (TOP SEAM)

NUMBER OF BEDROOMS: 34

SQUARE FEET PER BEDROOM: 280 210

LINEAR FEET OF TRENCH REQUIRED: 135 280

TRENCHES:	Trench to be 3.0 feet wide. Inlet 3.0 feet below original grade. Bottom maximum depth 5.0 feet below original grade. Effective area begins at 3.0 feet below original grade. 2.0 feet of stone below distribution pipe.
LOCATION:	Begin trenches 180 feet off the rear property line and 125 feet off the left lot line as seen when facing the lot from Old Frederick Road. Run trenches on contour toward the left lot line.
NOTES:	

PLANS APPROVED: Amy Mc Millen OK SRK DATE: 5-25-01  
6/7/01

- NOTE: PERMIT VOID AFTER 2 YEARS
- NOTE: CONTRACTOR RESPONSIBLE FOR SCHEDULING A PRE-CONSTRUCTION INSPECTION FOR ALL INSTALLATIONS
- NOTE: WATERTIGHT SEPTIC TANKS REQUIRED
- NOTE: ALL PARTS OF SEPTIC SYSTEM SHALL BE 100 FEET FROM ANY WATER WELL
- NOTE: MANHOLE RISERS REQUIRED ON ALL SEPTIC TANKS AND PUMP CHAMBERS


**NEITHER THE HOWARD COUNTY COUNCIL NOR THE HEALTH DEPARTMENT IS RESPONSIBLE FOR THE SUCCESSFUL OPERATION OF ANY SYSTEM PERMITTEE RESPONSIBLE FOR OBTAINING FINAL APPROVAL ON THIS PERMIT CALL 410-313-2640 FOR INSPECTION OF SEPTIC SYSTEM**

**BUILDING PERMIT SIGNED AND RETURNED** 5/29/2002  
B00136534 DECK

4-1-2001

NOT TO SCALE

TO OLD  
FRED.  
ROAD

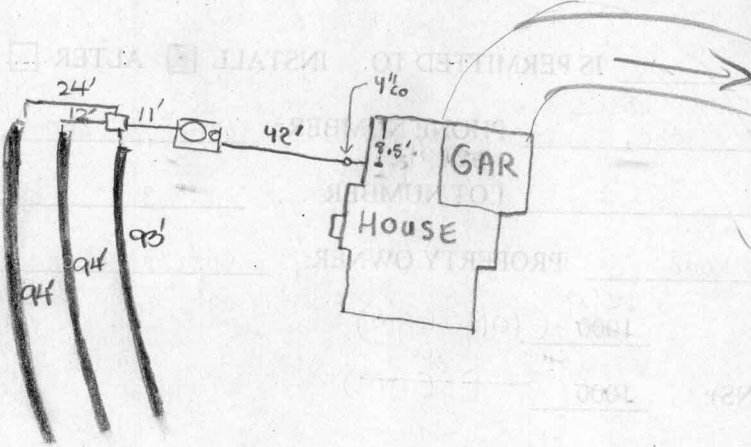

**TRENCH DATA**

TRENCH WIDTH 3  
 TRENCH INLET DEPTH 3  
 TRENCH BOTTOM DEPTH 5  
 DEPTH OF STONE 2  
 NUMBER OF TRENCHES 3  
 TOTAL TRENCH LENGTH 280+  
 ABSORBENT AREA 740  
 DISTRIBUTION BOX LEVEL   
 BAFFLE IN DISTRIBUTION BOX

**SEPTIC TANK DATA**

SEPTIC TANK 1250 TS GALLONS  
 MANHOLE RISER   
 6 INCH INSPECTION PORT

**PUMP CHAMBER DATA**

~~PUMP CHAMBER GALLONS \_\_\_\_\_  
 MANHOLE RISER \_\_\_\_\_  
 ALARM \_\_\_\_\_  
 PUMP PERFORMANCE TEST \_\_\_\_\_~~

PRE-CONSTRUCTION INSPECTION: 6/29/01 - INSTALL PER APPROVED BP PLAN - (SRU)

INSPECTION COMMENTS: 7/2/01 FINAL INSP - OK TO COVER ALL SEPTIC WORK DKC

INSPECTOR [Signature]

DATE SYSTEM APPROVED [Signature]

BUILDING PERMIT SIGNED

AND RETURNED