

SHANABERGER & LANE
 8726 TOWN & COUNTRY BLVD.
 SUITE 201
 ELLICOTT CITY, MD. 21043
 PHONE: 410-461-9563
 FAX: 410-461-9693

Total linear feet of trench required 280 feet

Width of trench(es) 3.0 feet

Depth of trench(es) 6.0 feet

Depth of stone required below distribution pipe 2.0 feet


Approved septic system plan
 Howard County Health Department

Amy McNeil 7/26/00
 Signature Date

INV. AT HOUSE 597.0
 SEPTIC TANK
 EX. GRADE 597.4
 FIN. GRADE 598.3
 INV. IN 596.6
 INV. OUT 596.3

DISTRIBUTION BOX
 EX. GRADE 597.3
 FIN. GRADE 597.8
 INV. IN 595.4
 INV. OUT 593.4

TRENCHES	#1	#2	#3
EX. GRADE	597.3	596.6	596.6
FIN. GRADE	597.2	596.6	596.6
INV. IN	595.3	594.6	594.6
BOTTOM	593.3	592.6	592.6
LENGTH	55	85	60

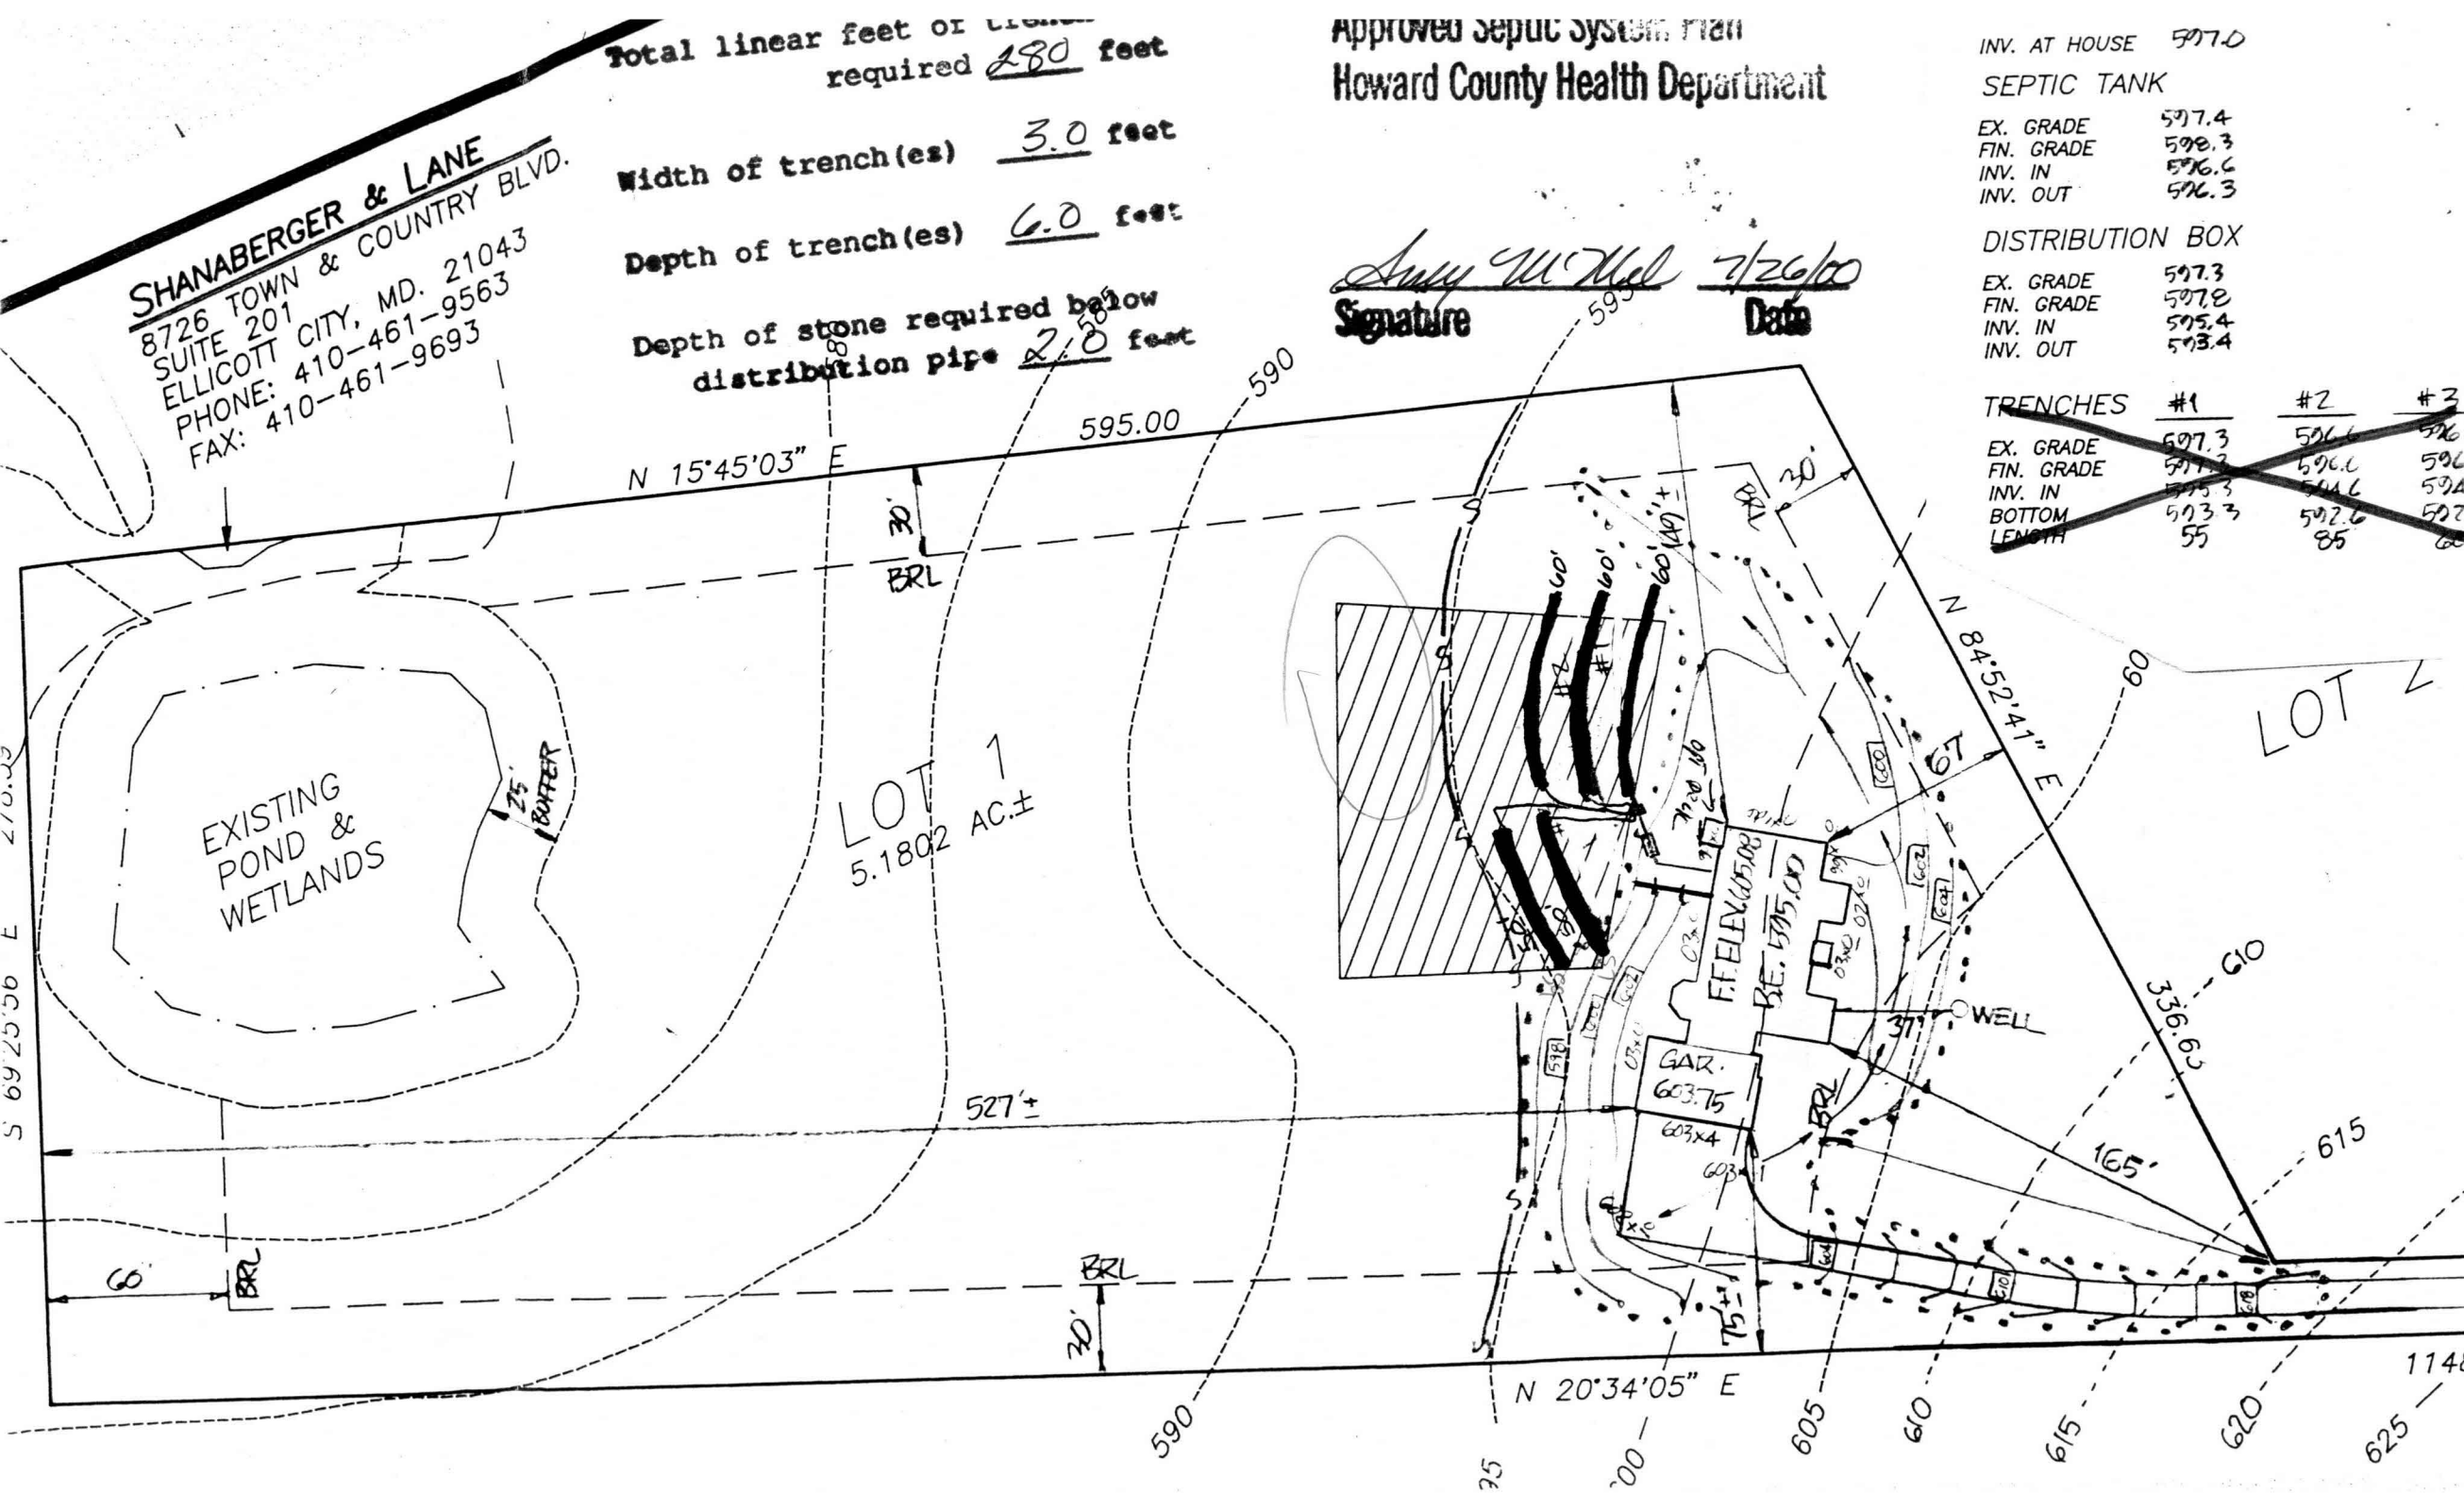

S 69°25'56" E 270.00

LOT 2

1148