

1-9-90
10am

APPLICATION

PERCOLATION TESTING

A 45331
P _____

HOWARD COUNTY HEALTH DEPARTMENT
BUREAU OF ENVIRONMENTAL HEALTH
P.O. BOX 476 ELLICOTT CITY, MARYLAND 21043
TELEPHONE 461-9933

DISTRICT _____
DATE 12/12/89

TO: THE COUNTY HEALTH OFFICER
ELLICOTT CITY, MARYLAND

I, HEREBY, APPLY FOR THE NECESSARY TEST IN ORDER TO CONSTRUCT (OR RECONSTRUCT) A SEWAGE DISPOSAL SYSTEM.

PROPERTY OWNER SARAH STOUT

ADDRESS 15802 OLD FREDERICK ROAD WOODBINE, MD 21797 PHONE (301) 489-4836

PROSPECTIVE BUYER N/A

ADDRESS _____ PHONE _____

PROPERTY LOCATION:

SUBDIVISION STOUT PROPERTY LOTS 1-3 LOT NO. 1

ROAD AND DESCRIPTION NORTH SIDE OF OLD FREDERICK ROAD 1300' EAST OF ROUTE 94

TAX MAP 7 PARCEL # 99

SIZE OF LOT 4.78 Acres TYPE BLDG SINGLE
(SINGLE FAMILY DWELLING OR COMMERCIAL)

THE SYSTEM INSTALLED UNDER THIS APPLICATION IS ACCEPTABLE ONLY UNTIL PUBLIC FACILITIES BECOME AVAILABLE. I FULLY UNDERSTAND THE FEE CONNECTED WITH THE FILING OF THIS PERC TEST APPLICATION IS NON-REFUNDABLE UNDER ANY CIRCUMSTANCES. I ALSO AGREE TO COMPLY WITH ALL M.O.S.H.A. REQUIREMENTS IN TESTING THIS LOT.

* Sarah Stout
(SIGNATURE OF APPLICANT)

APPROVED BY _____ FOR _____ DATE _____

REJECTED BY _____ FOR _____ DATE _____

HOLD PENDING FURTHER TESTS _____ DATE _____

REASONS FOR REJECTION OR HOLDING PERC OK - HOLD FOR PLAT MR 1/12/90

HD-216

THIS IS NOT A PERMIT


145331

LOT II

ALL HOLES

SOIL PROFILE

0 to 3'
 clay LOAM
 3'
 0 to 9
 tan
 0 to 14
 sandy silt
 loam
 10-12 1/2
 10% frags

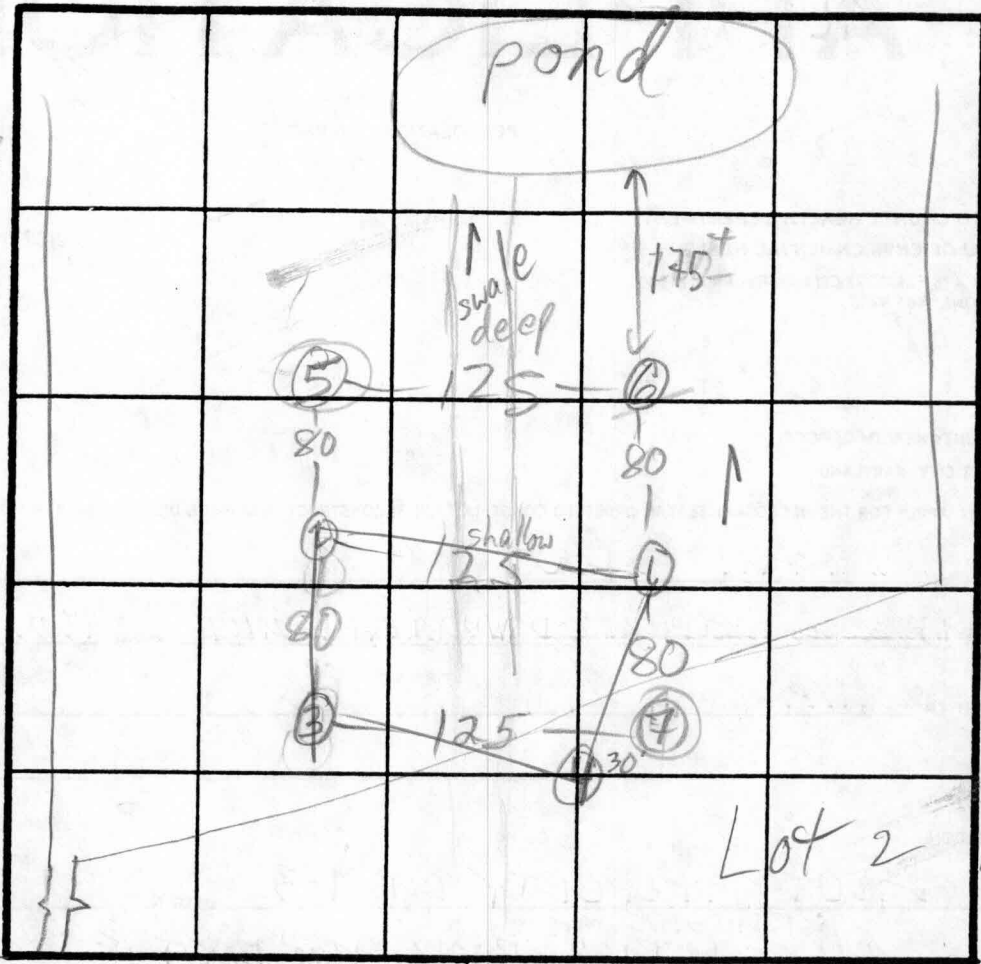

③ ④ H1
 ① ② L0

$\bar{x} = 13$
 210 BR
 Inlet 4'
 Bottom 6'

INDICATE NORTH - NAME ADJOINING ROADWAY AS BASE LINE.

OLD FRED ROAD

DATE	TEST NO.	DEPTH	PRE-WET		TEST - 1" DROP		TIME
			START	STOP	START	STOP	
1/10/90	1 S	4'	2:13	2:18	2:18	2:29	11 ✓
	1 V	11 1/2'	see profile				
	2 S	5'	2:16	2:17	2:17	2:19	2 ✓
	2 V	12 1/2'	see profile				
	3 S	4 1/2'	2:22	2:27	2:27	3:00	33 EST ✓
	3 M	7 1/2'	2:22	2:26	2:26	2:30	4 ✓
	3 V	11'	see profile				
	4 V	10'	see profile		25%	saprolite frags	
	5	WATER AT 12 1/2'			FAIL		
	5 1/2	NOT TESTED					
	7	6 1/2' ROCKY	25-30%		NOT TESTED		


REMARKS HOLES ① ② ⑤ ⑥ NUG PER PLAT; SHALLOW ONLY - USE ① - ④

TYPE OF SOIL

TESTED BY M. Riffkin

ALSO PRESENT
 1/10/90
 5 C.B. Ketterman

Signed
Per Cent

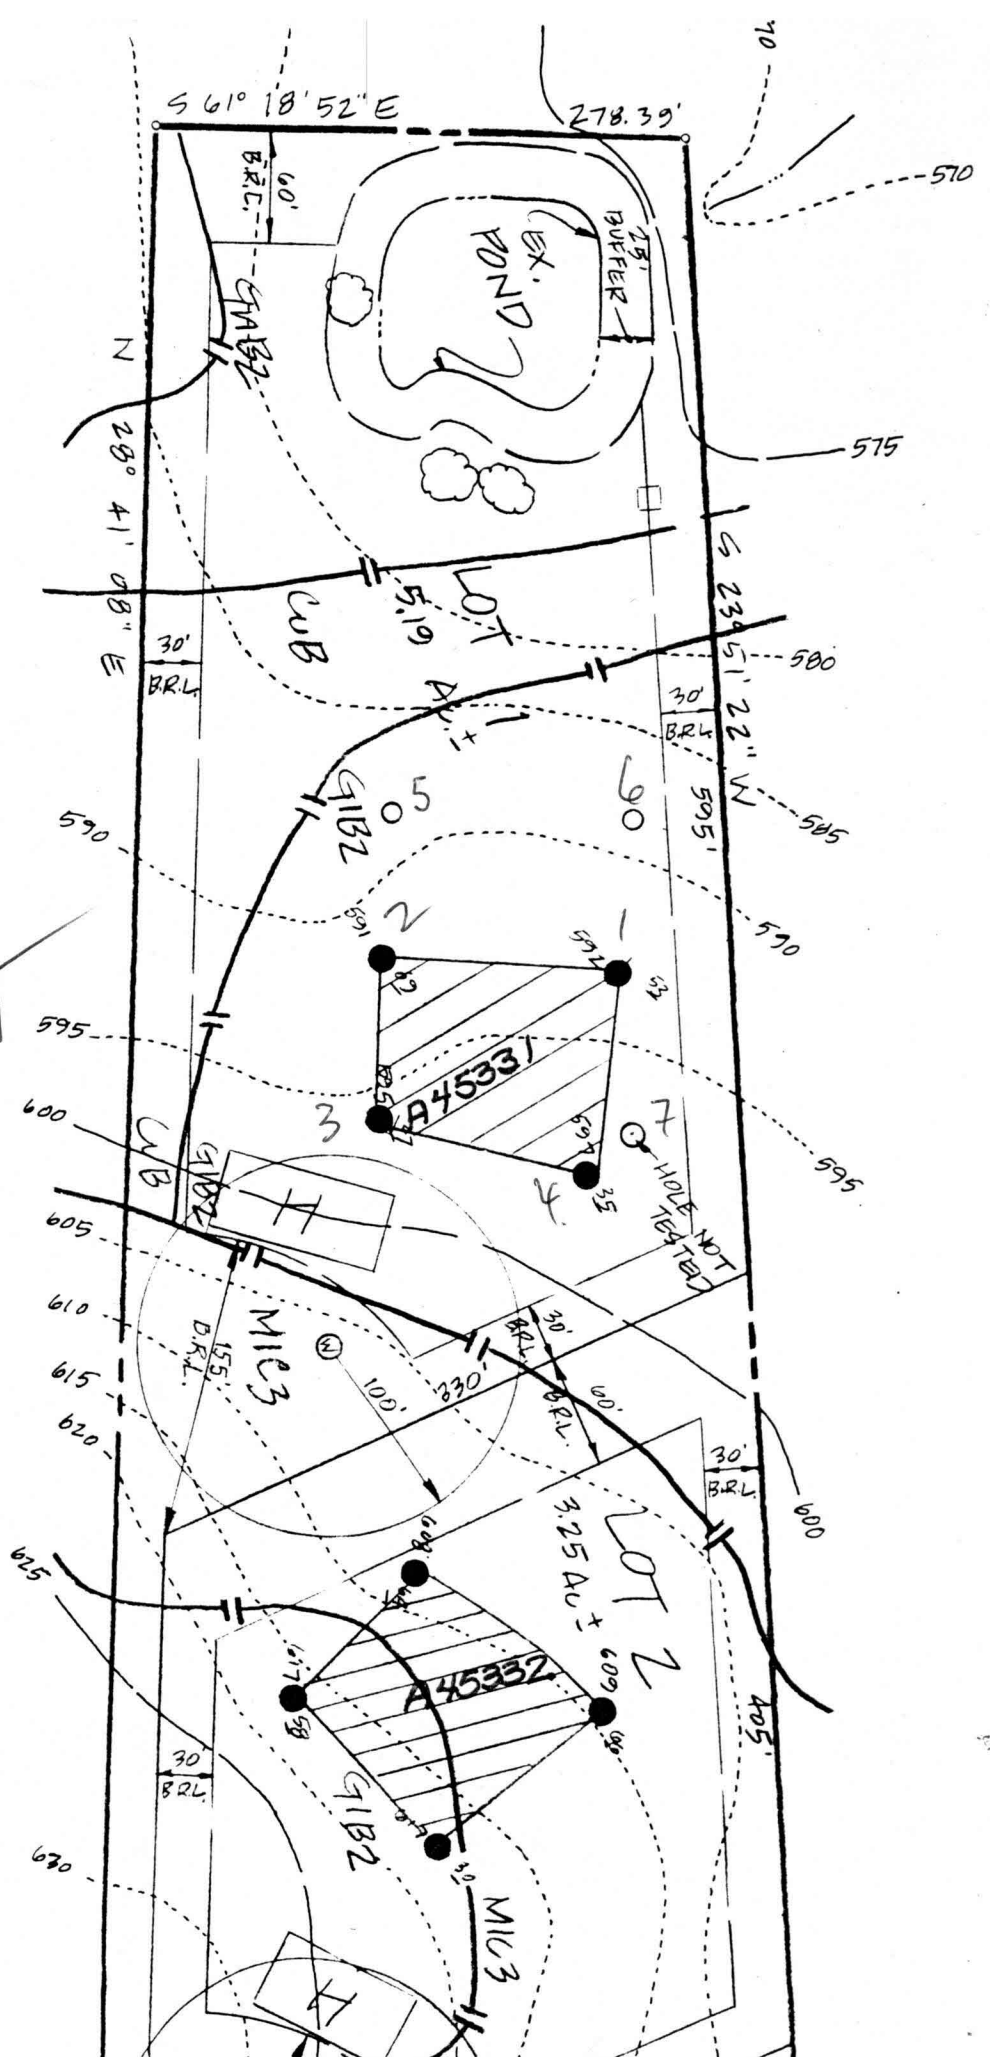

CLEARING, GRADING OR CONSTRUCTION PERMITTED WITHIN WETLAND BUFFER"


174	552630.00	781749.00
173	551190.484	781346.512
220	551101.504	
221	551175.173	
73		

MANARELLI
856/251

202	204	N 71° 00' 00" W
204	205	S 66° 44' 44" E
205	206	S 30° 44' 44" E
206	193	

E 782.00'

ZONED R

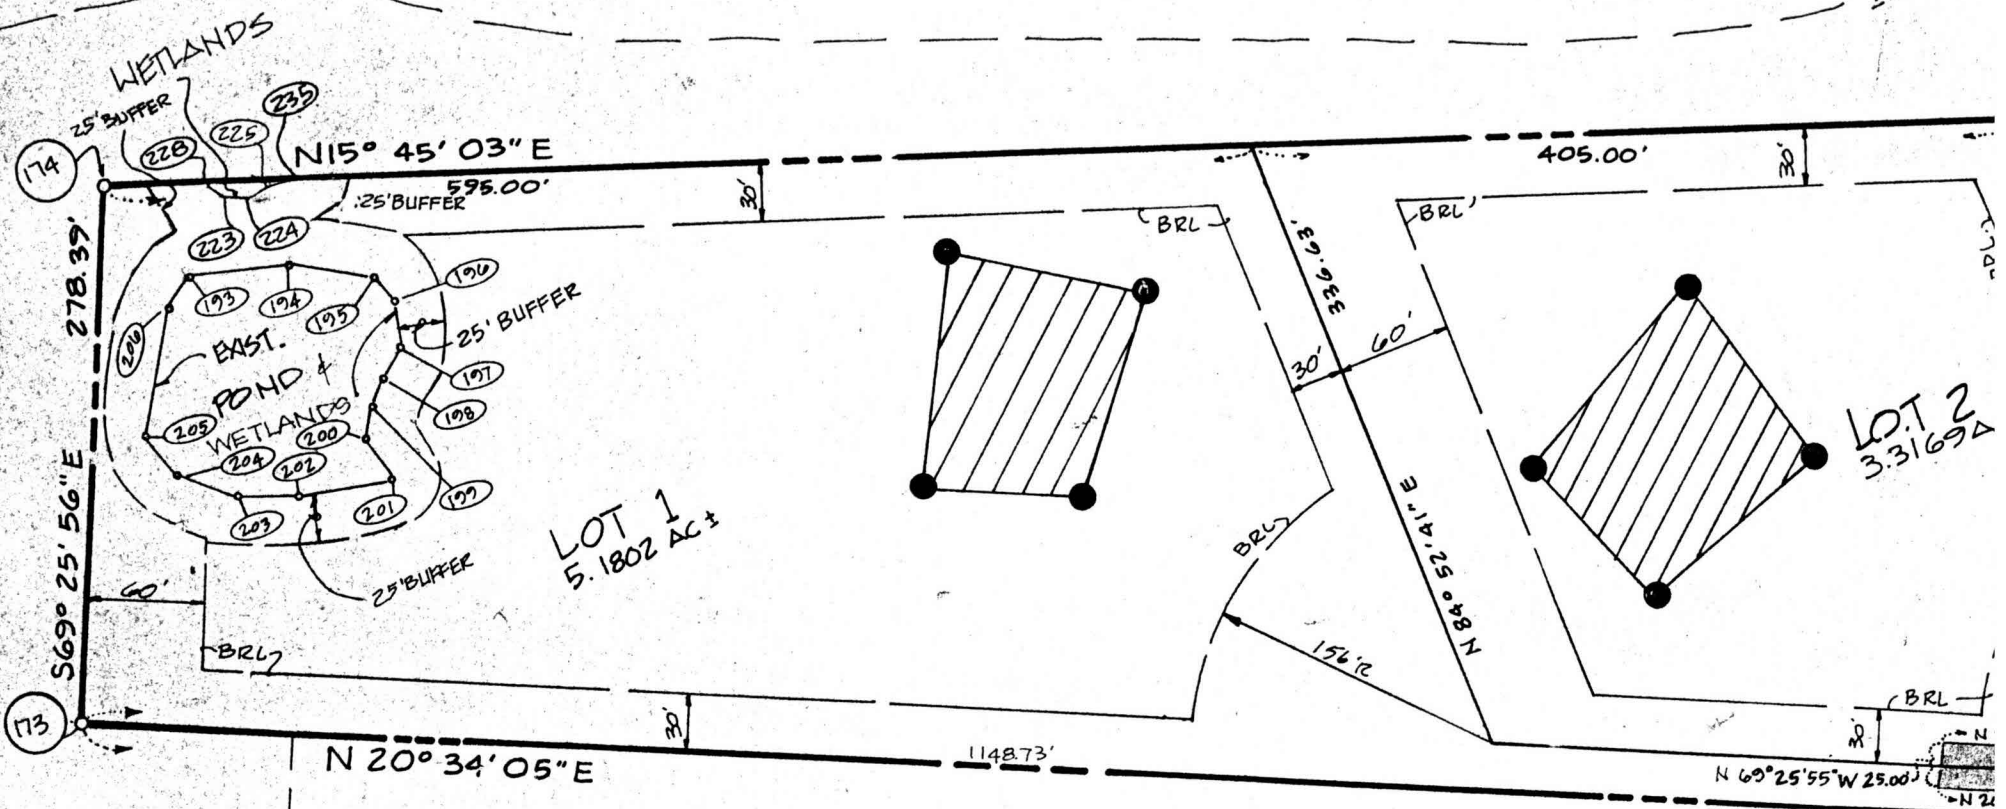

McDOUGALL
PARCEL 'C'
4890

McDOUGALL
PARCEL 82

MINIMUM LOT AREA CALCULATIONS

LOT NO.	GROSS LOT AREA	SLOPE/FLOOD PLAIN AREA	NET LOT AREA	PIPE STEM AREA	MIN. LOT AREA
1	5.1802 AC±	0.0066 AC±	5.1736 AC±	0.4591 AC±	4.7145 AC±
			3.3169 AC±	0.2239 AC±	3.0930 AC±
			3.4649 AC±	0	3.4649 AC±

