

10/5/01 LAJona
1-2 PM
10/9/01 - Follow up AM

ISSUE DATE: 10/5/2001

APPROVAL DATE: 11/7/01

PERMIT

P 516056

A 511334

INDEXED

ON-SITE SEWAGE DISPOSAL SYSTEM HOWARD COUNTY HEALTH DEPARTMENT BUREAU OF ENVIRONMENTAL HEALTH

04-364783

Union Paving IS PERMITTED TO INSTALL ALTER

ADDRESS: 5977 Sandy Ridge Road, Elkridge PHONE NUMBER: 410-379-6463

SUBDIVISION: Stirn Property LOT NUMBER: 2

ADDRESS: 17120 Old Frederick Road PROPERTY OWNER: Altieri Enterprises

SEPTIC TANK CAPACITY (GALLONS): 1250

PUMP CHAMBER CAPACITY (GALLONS): ~~1250~~ 1250

NUMBER OF BEDROOMS: 4

SQUARE FEET PER BEDROOM: 210

LINEAR FEET OF TRENCH REQUIRED: 280

TRENCHES:	Trench to be 3.0 feet wide. Inlet 4.0 feet below original grade. Bottom maximum depth 6.0 feet below original grade. Effective area begins at 4.0 feet below original grade. 2.0 feet of stone below distribution pipe.
LOCATION:	As seen from Old Frederick Road, place the distribution box 100' from the left lot line and 95' from the front lot line. Run (4) trenches on contour in either direction.
NOTES:	


PLANS APPROVED: MER 10/5/01 OK BB DATE: 8/8/01

- NOTE: PERMIT VOID AFTER 2 YEARS
- NOTE: CONTRACTOR RESPONSIBLE FOR SCHEDULING A PRE-CONSTRUCTION INSPECTION FOR ALL INSTALLATIONS
- NOTE: WATERTIGHT SEPTIC TANKS REQUIRED
- NOTE: ALL PARTS OF SEPTIC SYSTEM SHALL BE 100 FEET FROM ANY WATER WELL
- NOTE: MANHOLE RISERS REQUIRED ON ALL SEPTIC TANKS AND PUMP CHAMBERS

NEITHER THE HOWARD COUNTY COUNCIL NOR THE HEALTH DEPARTMENT IS RESPONSIBLE FOR THE SUCCESSFUL OPERATION OF ANY SYSTEM PERMITTEE RESPONSIBLE FOR OBTAINING FINAL APPROVAL ON THIS PERMIT CALL 410-313-2640 FOR INSPECTION OF SEPTIC SYSTEM

1516056

NOT TO SCALE

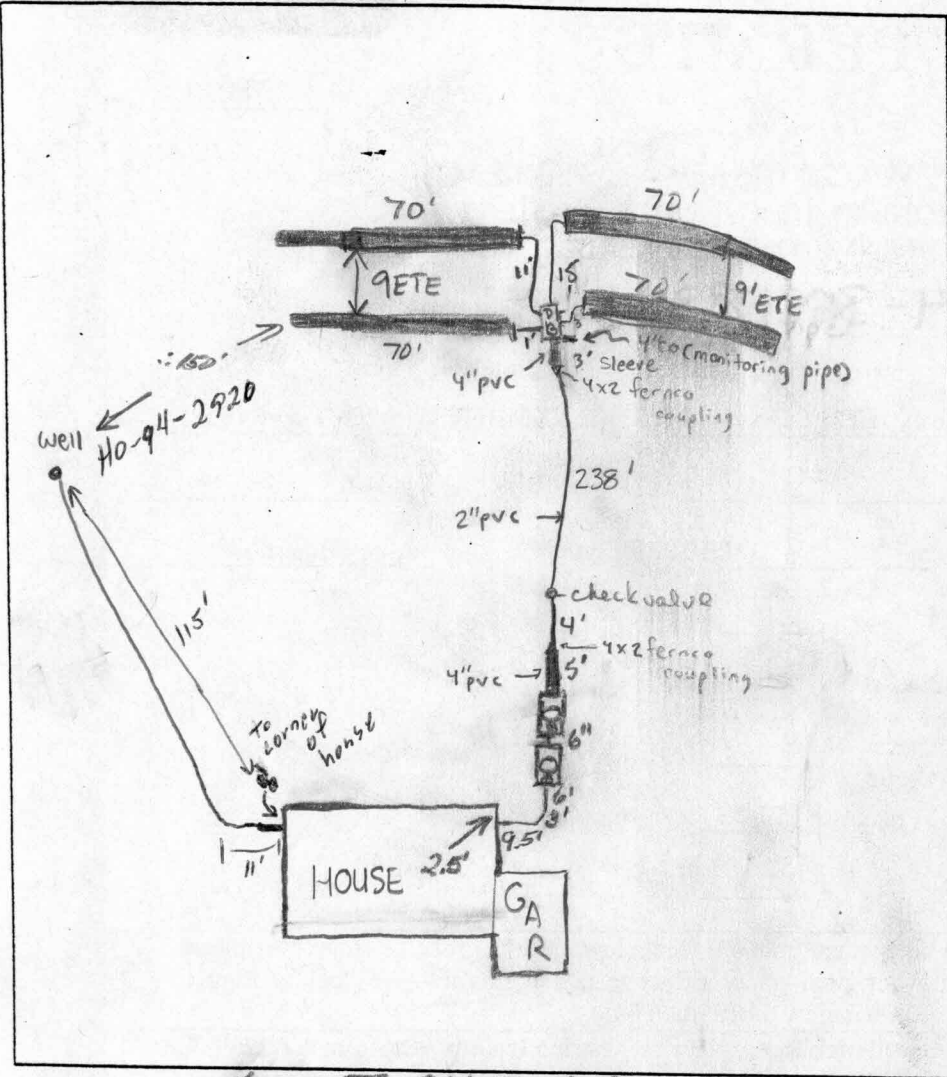

TRENCH DATA	
TRENCH WIDTH	3'
TRENCH INLET DEPTH	4'
TRENCH BOTTOM DEPTH	6'
DEPTH OF STONE	2'
NUMBER OF TRENCHES	4'
TOTAL TRENCH LENGTH	280'
ABSORBENT AREA	840 SF
DISTRIBUTION BOX LEVEL	yes
BAFFLE IN DISTRIBUTION BOX	yes

SEPTIC TANK DATA	
SEPTIC TANK	1250TS GALLONS
MANHOLE RISER	on center
6 INCH INSPECTION PORT	on front
PUMP CHAMBER DATA	
PUMP CHAMBER GALLONS	1250TS
MANHOLE RISER	on center
ALARM	OPERATIONAL
PUMP PERFORMANCE TEST	<input checked="" type="checkbox"/>

← To Old Frederick Road
 PRE-CONSTRUCTION INSPECTION: 10/5/01 To install as per B.P. plan. (BB)

INSPECTION COMMENTS: 10/5/01 Tanks set O.K. to backfill. Need house connection (BB) 10/9/01 SYSTEM complete pending house conn, pump & alarm test (KG/SK) 11/7/01 - HOUSE CONN. MADE, PUMP & ALARM OPERATIONAL (SRK/KG)

INSPECTOR Steven R. Krieg DATE SYSTEM APPROVED 11/7/01

