

APPLICATION

PERCOLATION TESTING

A _____

P _____

HOWARD COUNTY HEALTH DEPARTMENT
BUREAU OF ENVIRONMENTAL HEALTH
3525-H ELLICOTT MILLS DRIVE/ELLICOTT CITY, MARYLAND 21043
TELEPHONE: 313-2640

DISTRICT _____

DATE _____

TO: THE COUNTY HEALTH OFFICER
ELLICOTT CITY, MARYLAND

I HEREBY APPLY FOR THE NECESSARY TEST PRIOR TO APPLICATION FOR PERMIT TO CONSTRUCT (OR RECONSTRUCT) A SEWAGE DISPOSAL SYSTEM.

PROPERTY OWNER MARSHALL W. NICHOLS

ADDRESS 2937 JENNINGS CHAPEL ROAD
WOODBRINE, MD 21797 PHONE _____

AGENT OR PROSPECTIVE BUYER DAVID E. WILKINSON @ MACRO LTD. REAL ESTATE SERVICES

ADDRESS 5301 BUCKEYSTOWN PIKE, SUITE 300
FREDERICK, MD 21704 PHONE (301) 698-9696


PROPERTY LOCATION:

DIVISION NICHOLS' PROPERTY LOT NO. _____

ROAD AND DESCRIPTION JENNINGS CHAPEL ROAD, HOWARD COUNTY

TAX MAP 13 PARCEL # P/O 46

SIZE OF LOT 40,000 - 60,000 sq. ft. TYPE BLDG. SINGLE FAMILY DWELLING
(SINGLE FAMILY DWELLING OR COMMERCIAL)

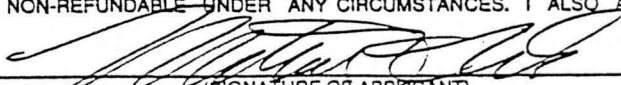THE SYSTEM INSTALLED UNDER THIS APPLICATION IS ACCEPTABLE ONLY UNTIL PUBLIC FACILITIES BECOME AVAILABLE. I FULLY UNDERSTAND THE FEE CONNECTED WITH THE FILING OF THIS PERC TEST APPLICATION IS NON-REFUNDABLE UNDER ANY CIRCUMSTANCES. I ALSO AGREE TO COMPLY WITH ALL M.O.S.H.A. REQUIREMENTS IN TESTING THIS LOT. 
(SIGNATURE OF APPLICANT)

APPROVED BY _____ FOR _____ DATE _____

DISAPPROVED BY _____ FOR _____ DATE _____

HOLD PENDING FURTHER TESTS _____

REASONS FOR REJECTION OR HOLDING _____

PERCOLATION TEST PLAT/PRELIMINARY PLAT - TITLE OR I.D. # _____ DATE _____

SITE DEVELOPMENT PLAN/FINAL PLAT - TITLE OR I.D. # _____ DATE _____


THIS IS NOT A PERMIT

MICHACS SUBD.


A 59946

COUNTY #


SOIL PROFILE 17B

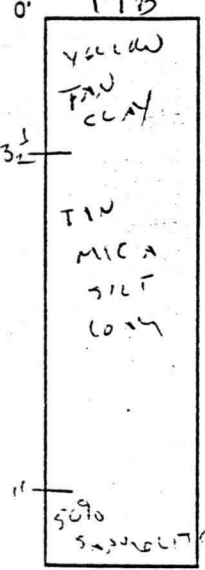



17C/18B + 18C/19B

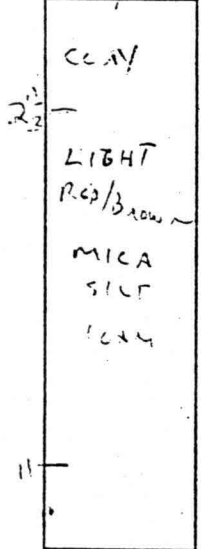

17C/20A

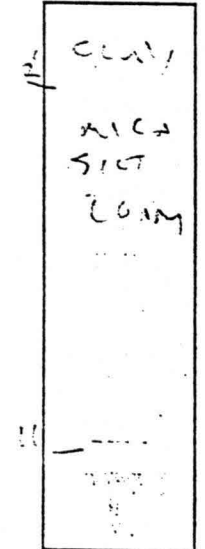

SOIL PROFILE 200/21A

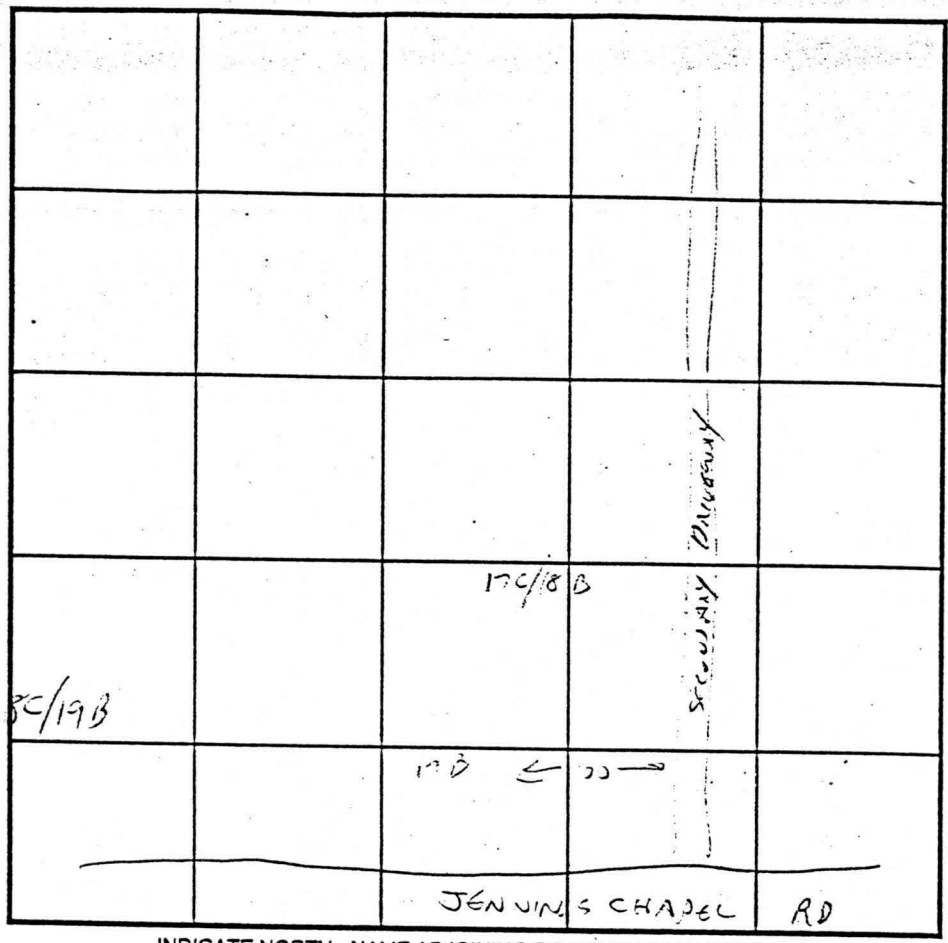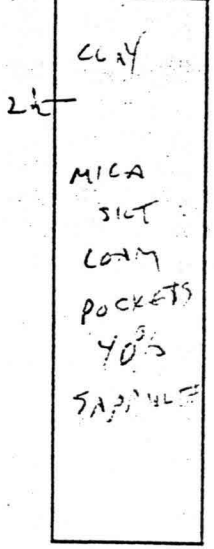

DATE	TEST NO.	DEPTH	PRE-WET		TEST - 1" DROP		TIME
			START	STOP	START	STOP	
4/16/98	17B	3 1/2	4:00	4:03	4:03	4:07	4 MIN
	17C/18B	3 1/2	4:03	4:06	4:06	4:11	5 MIN
	18C/19B	3 1/2	4:04	4:06	4:06	4:09	3 MIN
	19C/20A	3 1/2	4:13	4:15	4:15	4:18	3 MIN
	200/21A	3 1/2	4:11	4:14	4:14	4:18	4 MIN

REMARKS _____

TYPE OF SOIL _____


TESTED BY C. Williams ALSO PRESENT SHARP

TRENCH DESIGN DATA: AVERAGE PERCOLATION TIME _____ TRENCH WIDTH _____

INLET DEPTH _____ MAXIMUM BOTTOM DEPTH _____ SQ. FT./BEDROOM _____

✓

✓

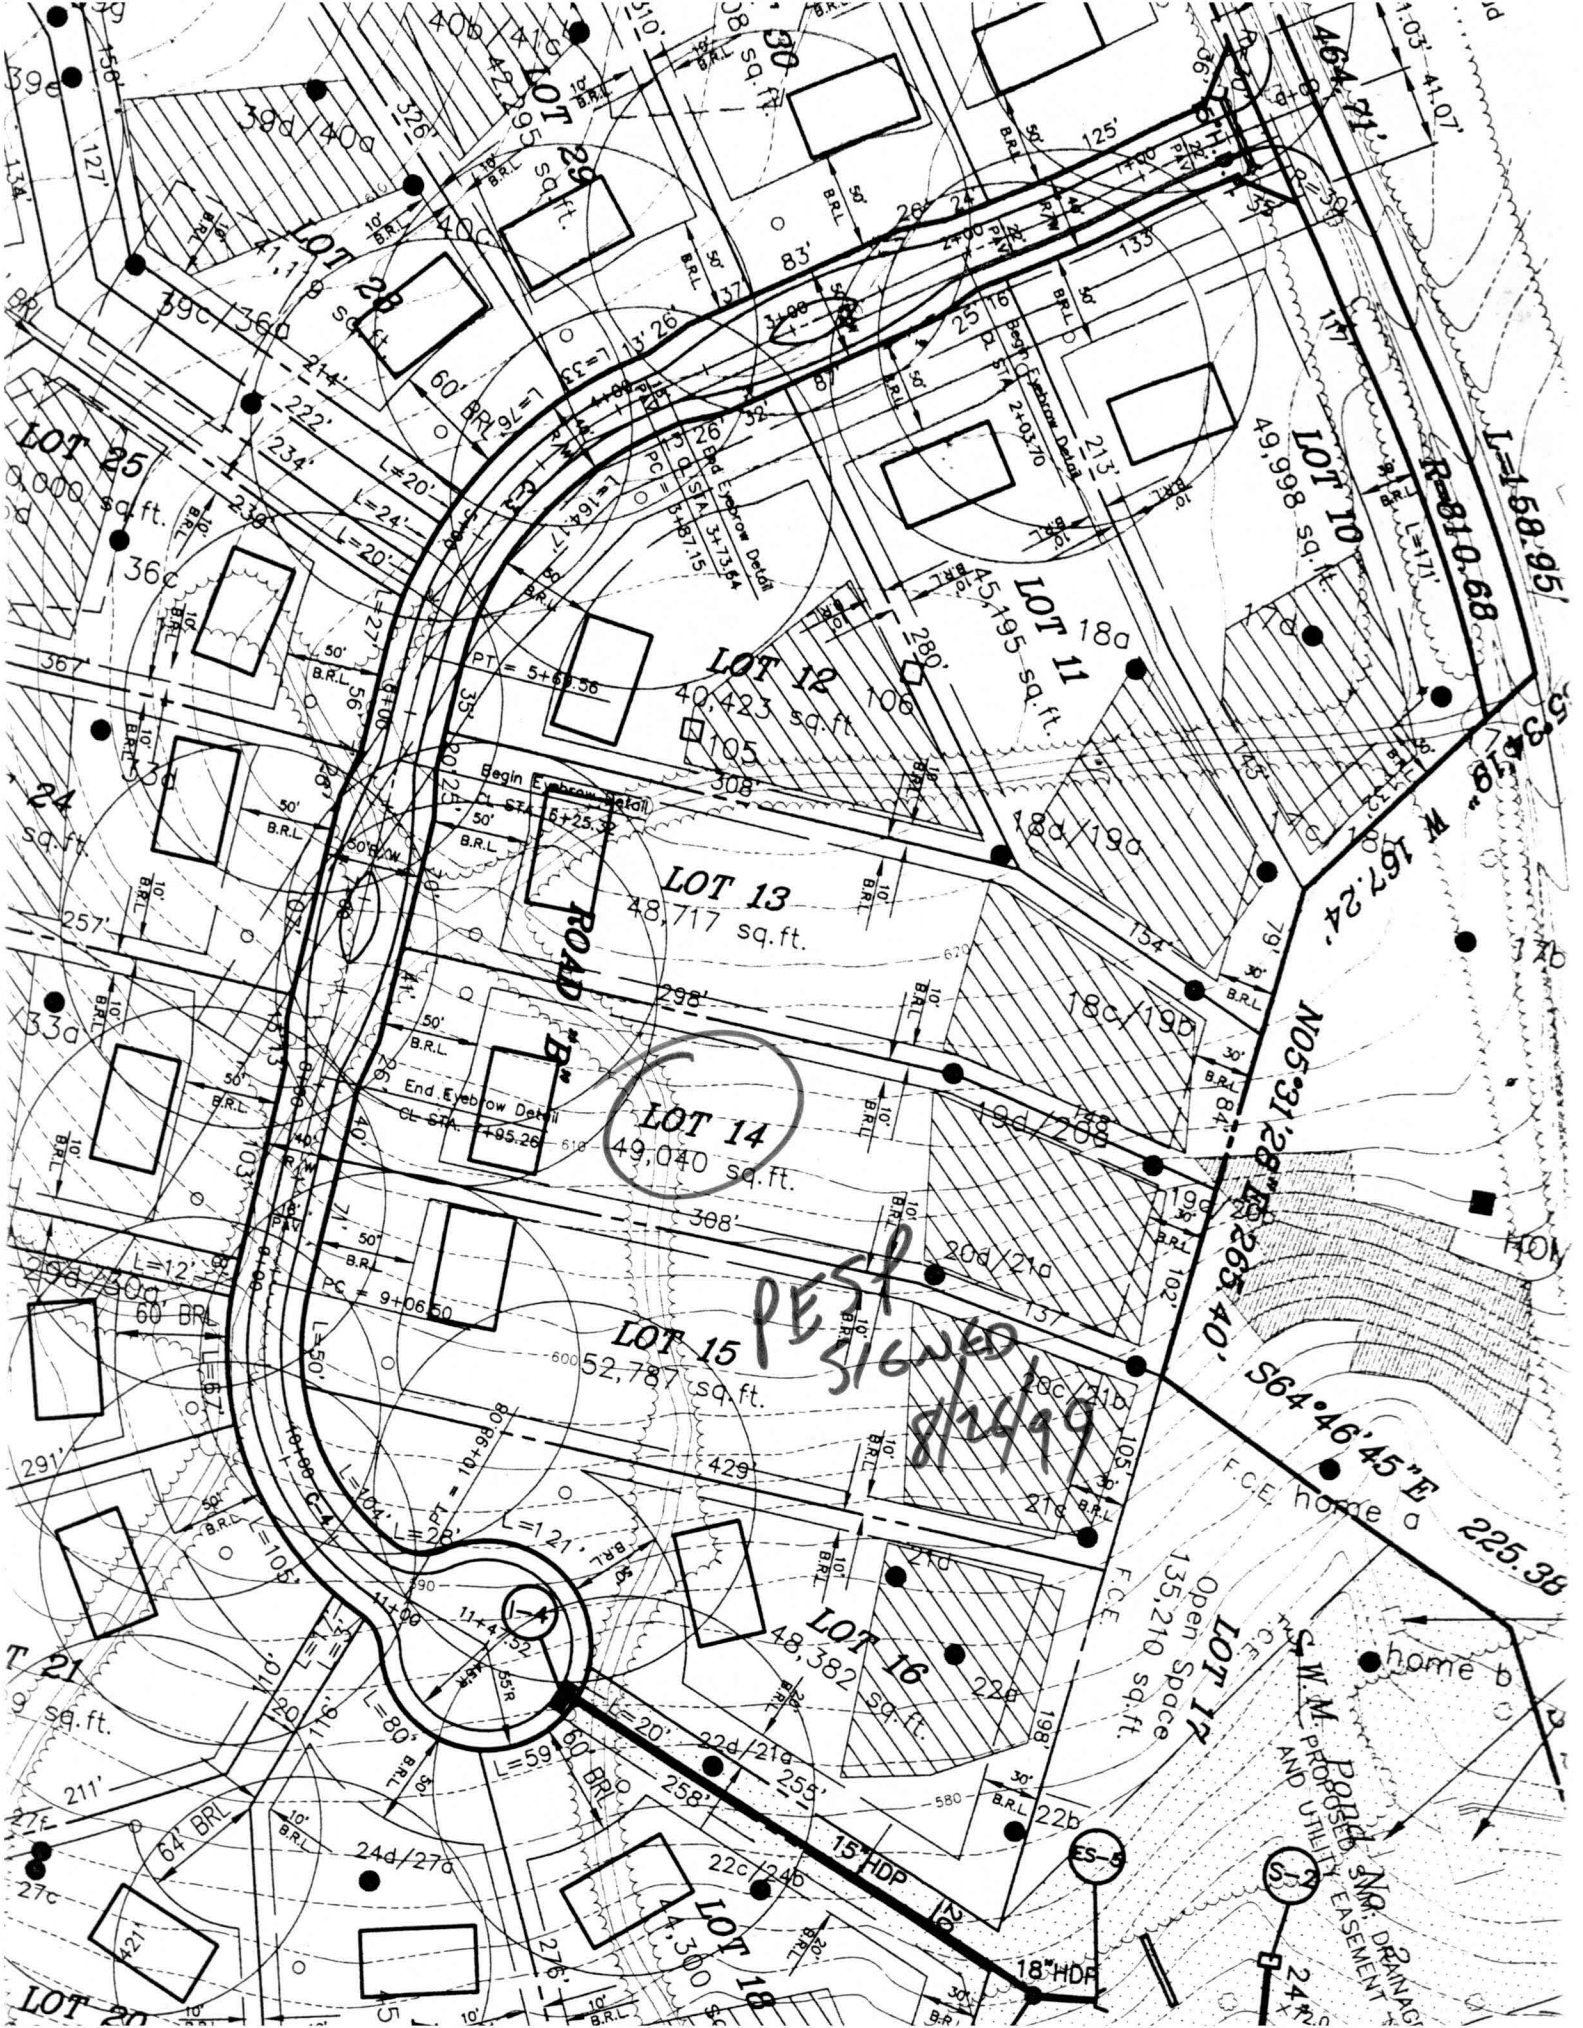

LOT 12
40,423 sq. ft.

LOT 13
48,717 sq. ft.

LOT 14
49,040 sq. ft.

LOT 15
52,787 sq. ft.

*PEST
SIGNED
8/24/99*

LOT 16
48,382 sq. ft.

LOT 18
43,300 sq. ft.

LOT 25
9,000 sq. ft.

LOT 24
59 sq. ft.

LOT 21
9 sq. ft.

LOT 20


LOT 28
60 sq. ft.

LOT 29
60 sq. ft.

LOT 18a
45,195 sq. ft.


LOT 10
49,698 sq. ft.


LOT 17
135,210 sq. ft.

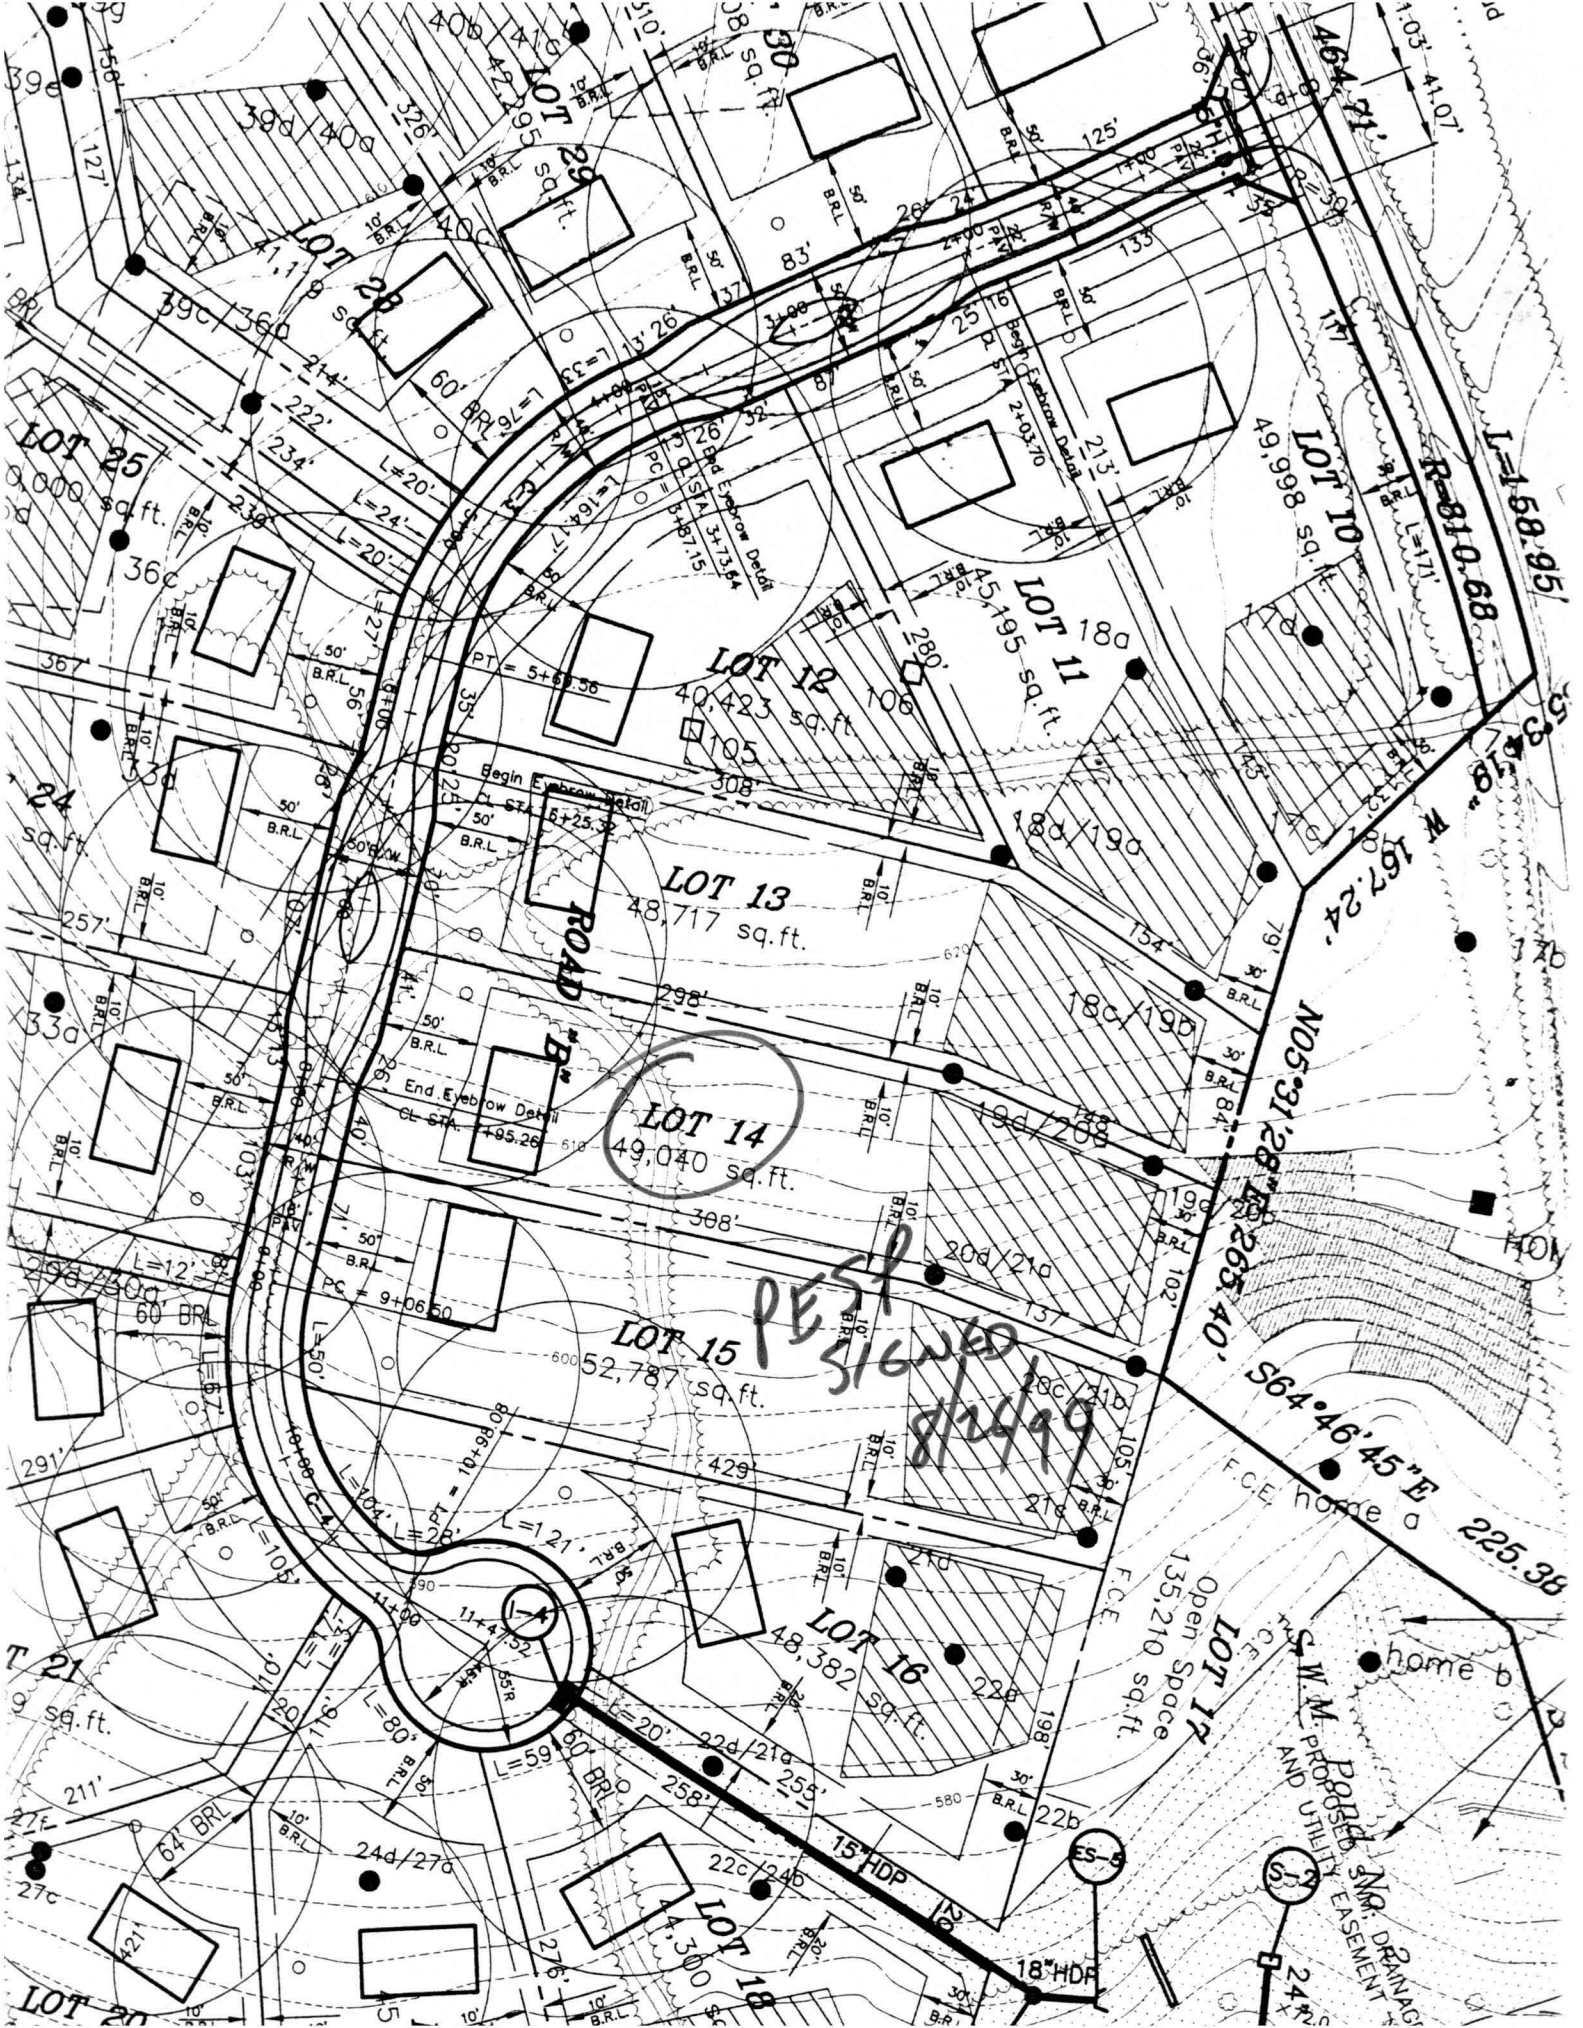

home a
home b

S.W.M. PROPOSED AND UTILITY EASEMENT
DRAINAGE

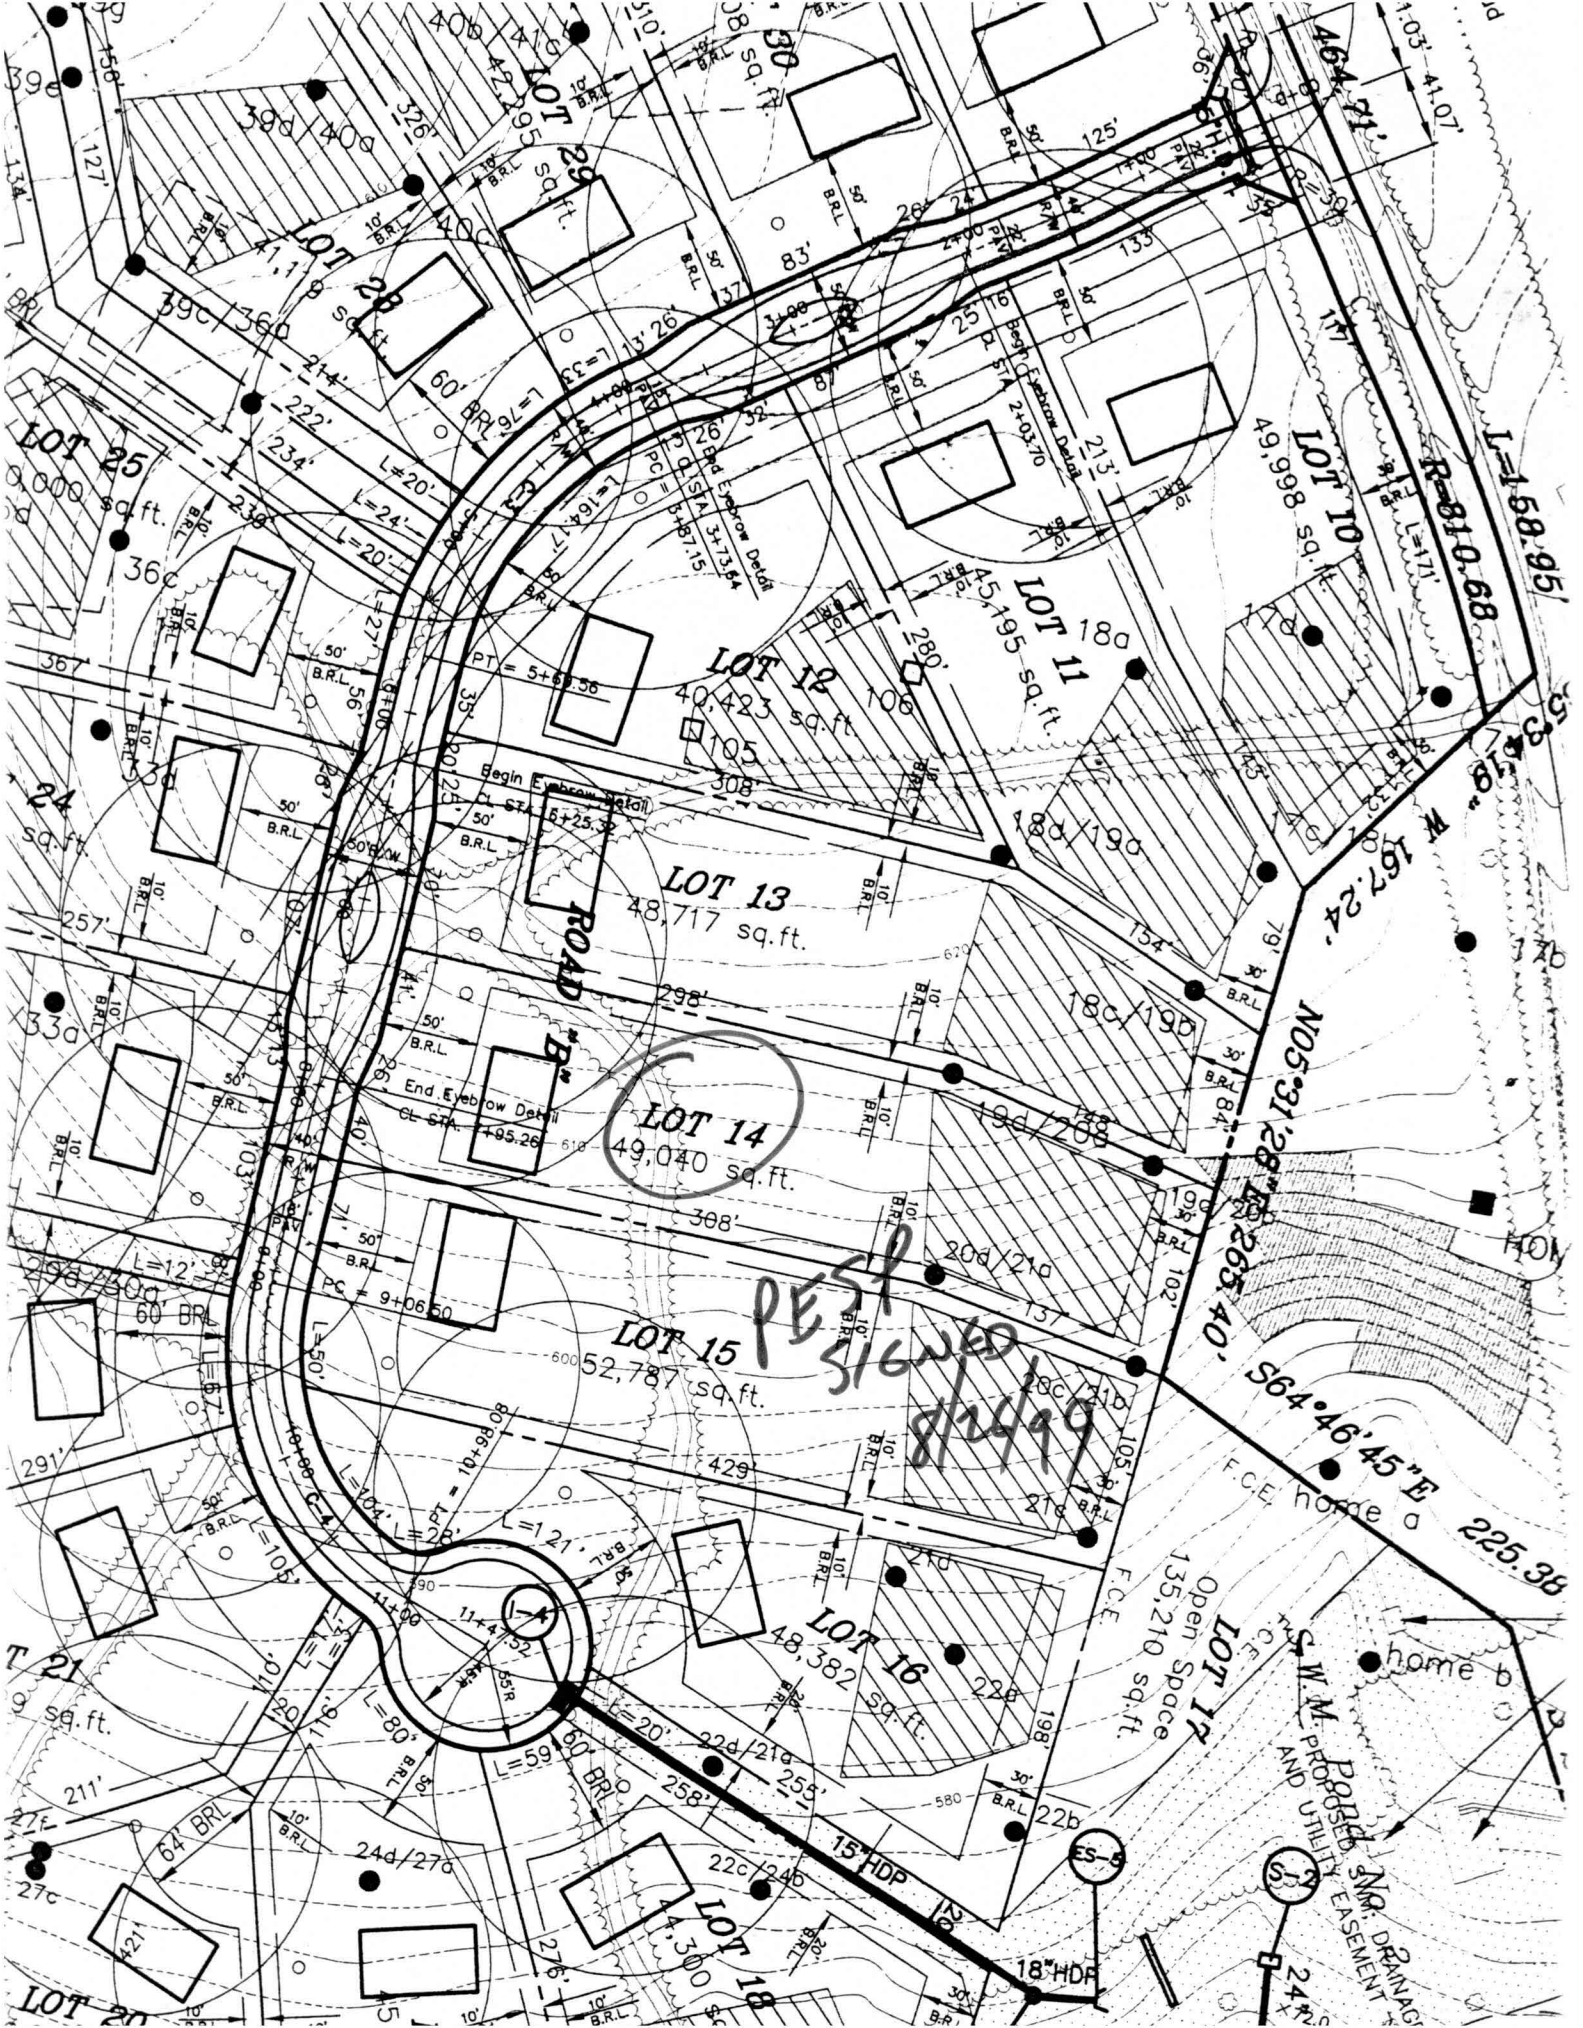

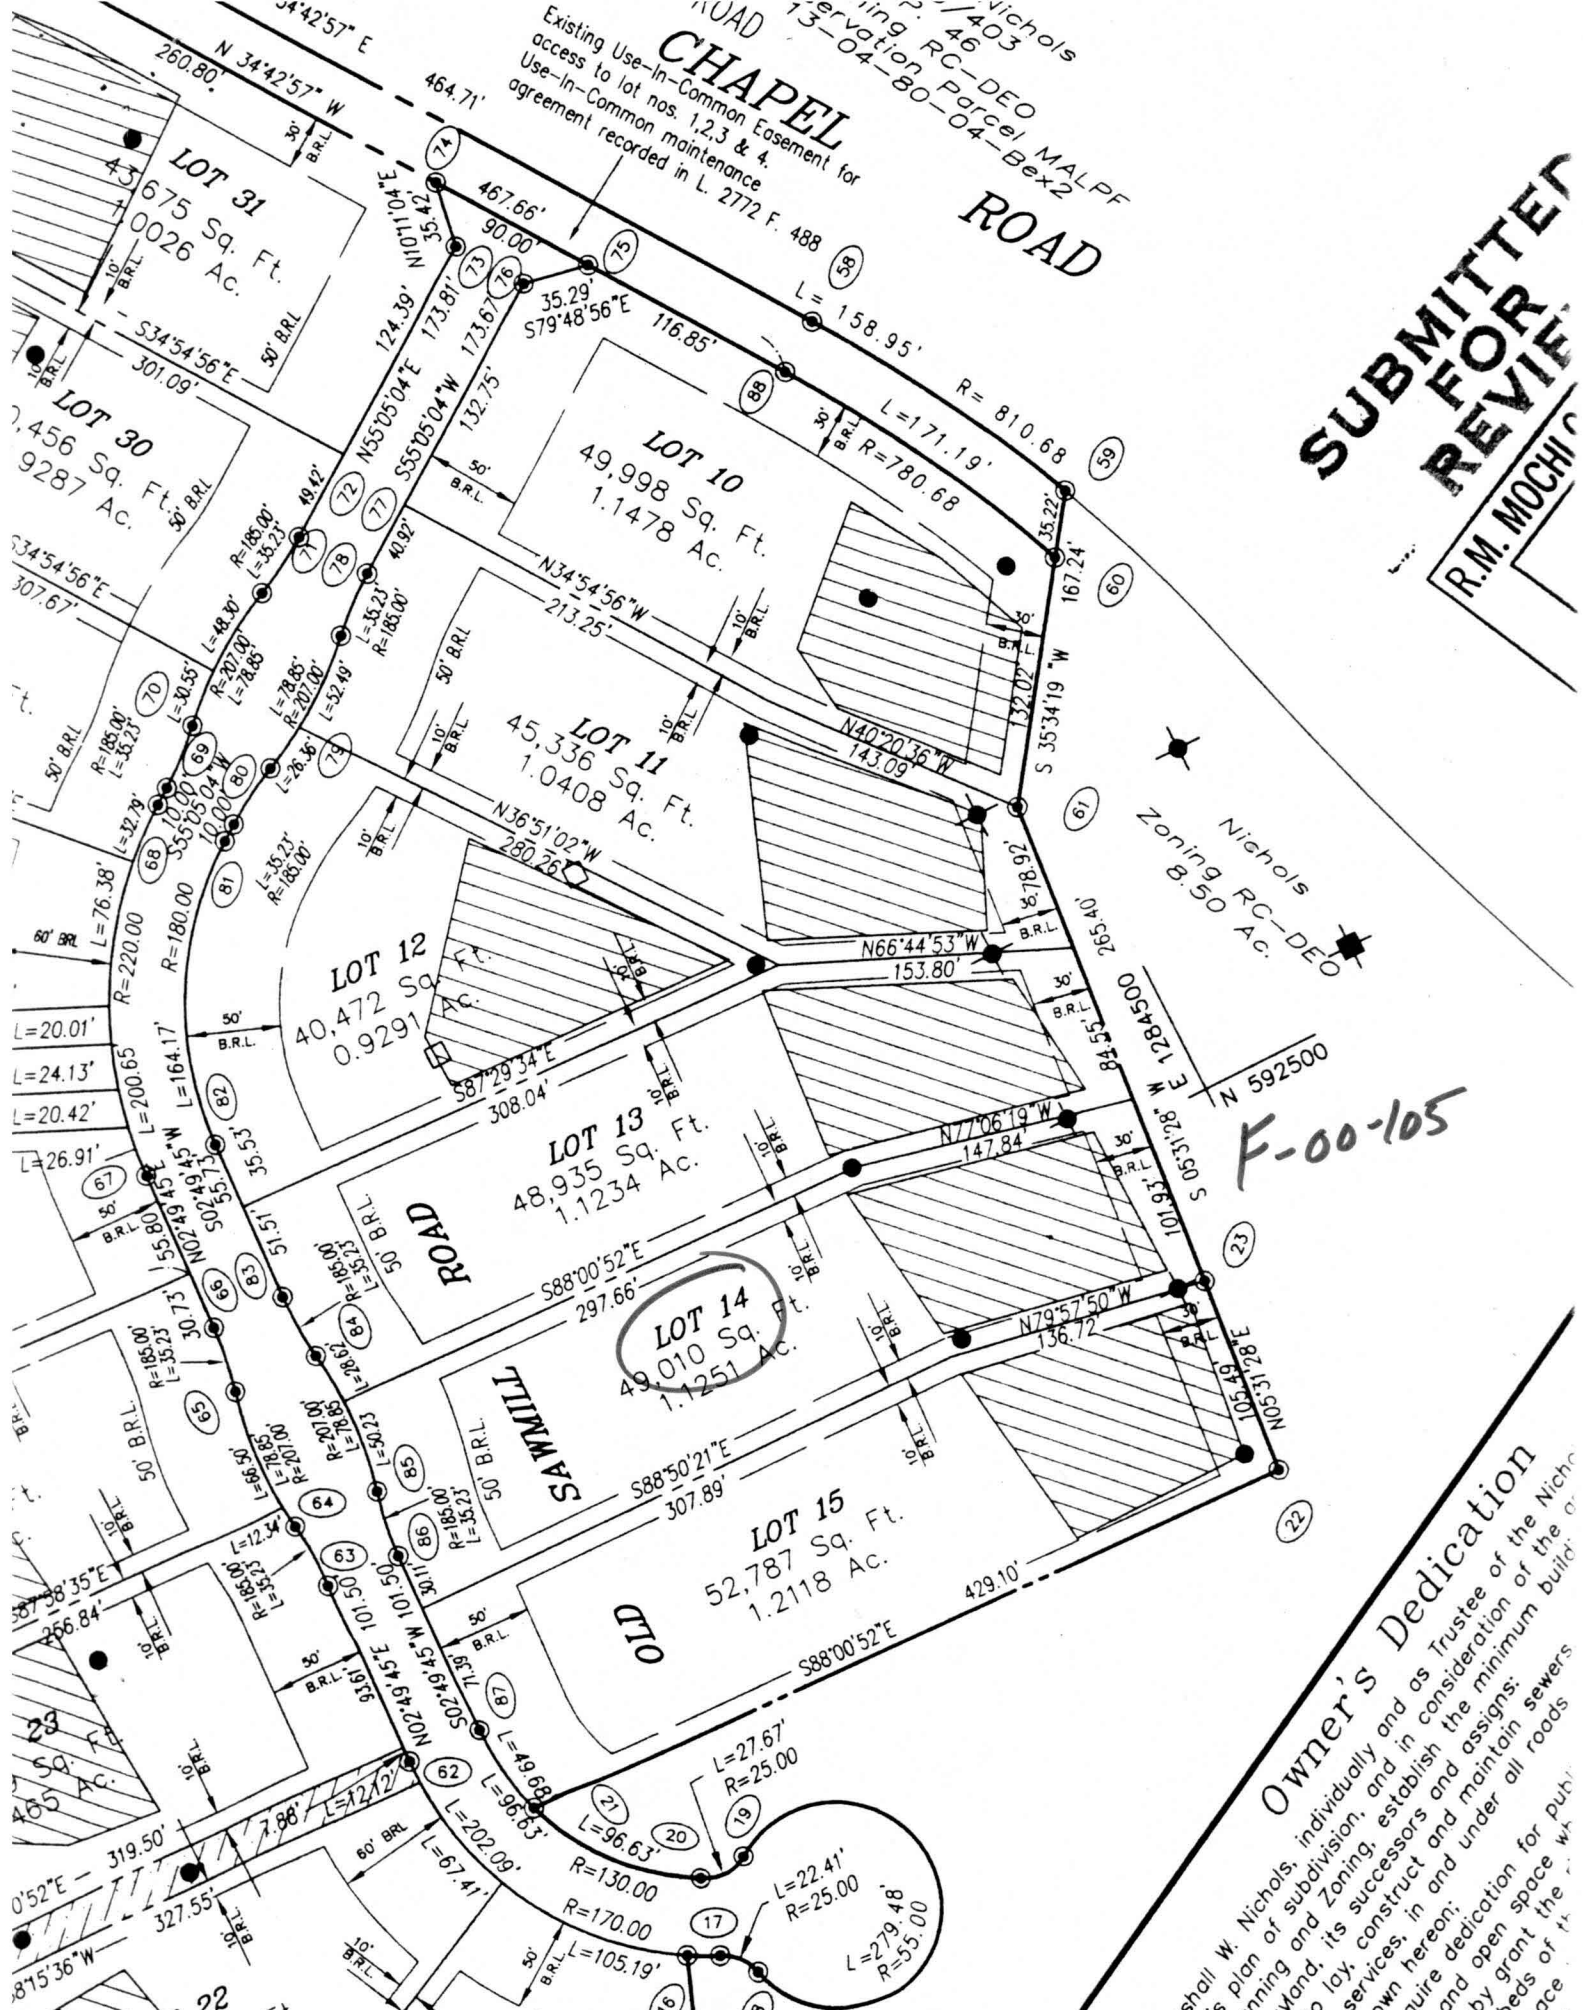

Existing Use-In-Common Easement for access to lot nos. 1,2,3 & 4. Use-In-Common maintenance agreement recorded in L. 2772 F. 488

Nichols
 2-1/403
 ing RC-DEO MALPF
 13-04-80-04-Bex2
ROAD

SUBMITTED FOR REVIEW
 R.M. MOCHIC

Nichols
 Zoning RC-DEO
 8.50 Ac.

F-00-105

Owner's Dedication
 Marshall W. Nichols, individually and as Trustee of the Nichols
 this plan of subdivision, and in consideration of the
 planning and Zoning, establish the minimum build-
 aryland, its successors and assigns;
 to lay, construct and maintain sewers;
 shown hereon;
 require dedication for pub-
 and open space wh-
 reby grant space wh-
 beds of th-
 space wh-

LOT 31
 675 Sq. Ft.
 0.026 Ac.

LOT 30
 456 Sq. Ft.
 0.0287 Ac.

LOT 10
 49,998 Sq. Ft.
 1.1478 Ac.

LOT 11
 45,336 Sq. Ft.
 1.0408 Ac.

LOT 12
 40,472 Sq. Ft.
 0.9291 Ac.

LOT 13
 48,935 Sq. Ft.
 1.1234 Ac.

LOT 14
 49,010 Sq. Ft.
 1.1251 Ac.

LOT 15
 52,787 Sq. Ft.
 1.2118 Ac.

