

12/18/01
Layout
AM

1/4/02 - Final

ISSUE DATE: 10/23/2001

P 516089

APPROVAL DATE: 1/4/02

A 59946-N

PERMIT
INDEXED

ON-SITE SEWAGE DISPOSAL SYSTEM
HOWARD COUNTY HEALTH DEPARTMENT
BUREAU OF ENVIRONMENTAL HEALTH

04-365690

Miller Excavating Co., Inc. IS PERMITTED TO INSTALL ALTER

ADDRESS: 18115 Sellman Rd., 20842 PHONE NUMBER: 301-349-4400

SUBDIVISION: Westwoods at Cherry Grove LOT NUMBER: 18

ADDRESS: 16917 Old Sawmill Road PROPERTY OWNER: D R Horton, Inc

SEPTIC TANK CAPACITY (GALLONS): 1250

PUMP CHAMBER CAPACITY (GALLONS): N/A

NUMBER OF BEDROOMS: 4

SQUARE FEET PER BEDROOM: 180

LINEAR FEET OF TRENCH REQUIRED: ~~240~~ 235

TRENCHES:	Trench to be 3.0 feet wide. Inlet 3.0 feet below original grade. Bottom maximum depth 5.0 feet below original grade. Effective area begins at 3.0 feet below original grade. 2.0 feet of stone below distribution pipe.
LOCATION:	Starting from the intersection of the 295.86' and 137.84' lot lines, place the distribution box 25' up the 295.86' lot line and 35' off this same lot line. Run (3) trenches on contour to rear of lot as shown on plan.
NOTES:	

PLANS APPROVED: MER DATE: 9/7/01

- NOTE: PERMIT VOID AFTER 2 YEARS
- NOTE: CONTRACTOR RESPONSIBLE FOR SCHEDULING A PRE-CONSTRUCTION INSPECTION FOR ALL INSTALLATIONS
- NOTE: WATERTIGHT SEPTIC TANKS REQUIRED
- NOTE: ALL PARTS OF SEPTIC SYSTEM SHALL BE 100 FEET FROM ANY WATER WELL
- NOTE: MANHOLE RISERS REQUIRED ON ALL SEPTIC TANKS AND PUMP CHAMBERS


NEITHER THE HOWARD COUNTY COUNCIL NOR THE HEALTH DEPARTMENT IS RESPONSIBLE FOR THE SUCCESSFUL OPERATION OF ANY SYSTEM PERMITTEE RESPONSIBLE FOR OBTAINING FINAL APPROVAL ON THIS PERMIT CALL 410-313-2640 FOR INSPECTION OF SEPTIC SYSTEM

BUILDING PERMIT SIGNED AND RETURNED 73-02
B00137306-DECK
B00138814-FINISH Basement 10/9/02

2/25/02
BPO0134429
1000gal propane tank

P516089

NOT TO SCALE

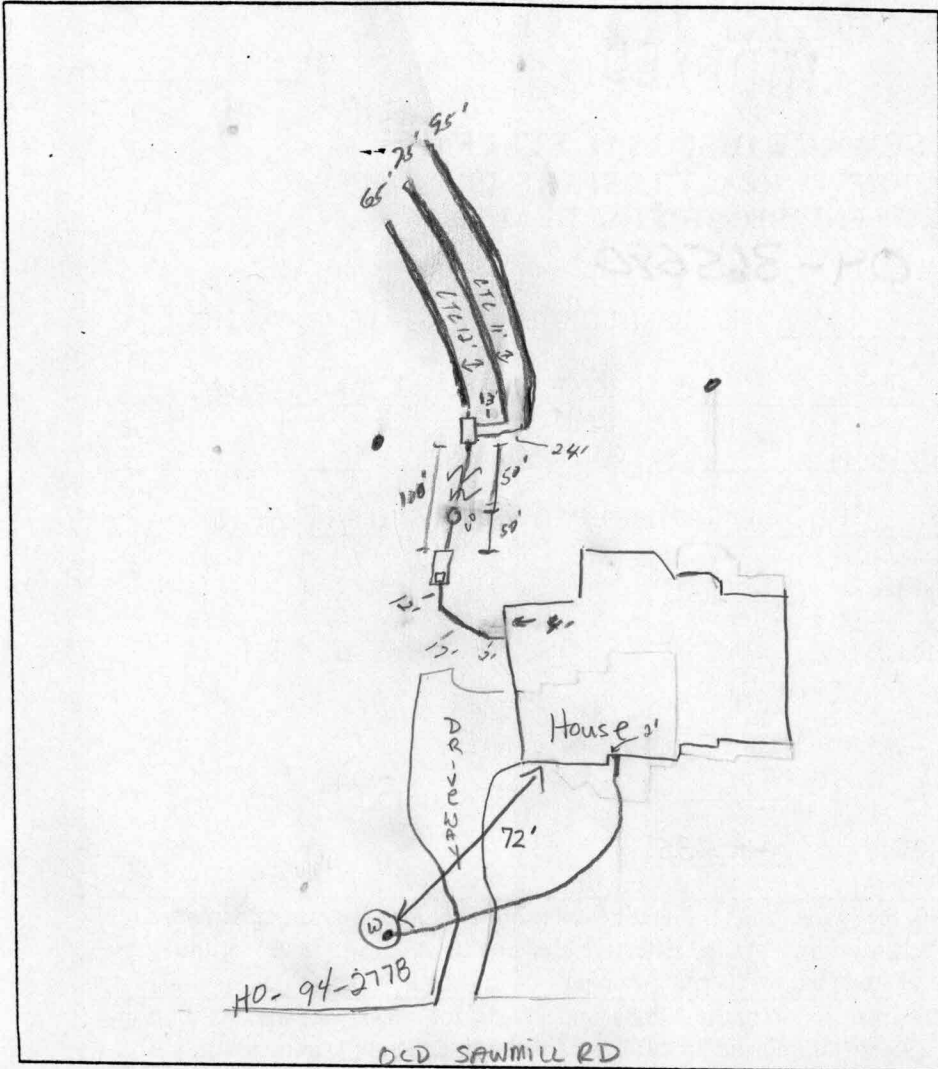

TRENCH DATA

TRENCH WIDTH 3'
 TRENCH INLET DEPTH 3'
 TRENCH BOTTOM DEPTH 5'
 DEPTH OF STONE 2'
 NUMBER OF TRENCHES 3'
 TOTAL TRENCH LENGTH _____
 ABSORBENT AREA _____
 DISTRIBUTION BOX LEVEL 1/2 in of level
 BAFFLE IN DISTRIBUTION BOX yes

SEPTIC TANK DATA

SEPTIC TANK 1500 GALLONS
 MANHOLE RISER Front - 1'
 6 INCH INSPECTION PORT None

PUMP CHAMBER DATA

PUMP CHAMBER GALLONS _____
 MANHOLE RISER _____
 ALARM _____
 PUMP PERFORMANCE TEST _____

PRE-CONSTRUCTION INSPECTION: 12/18/01 OK TO START PER PLAN 12'CTC Contour close
 TO MAINTAIN STABILITY FOR PIPES TO ST., Stone will be added (due to fill). Area staked. (K6)

INSPECTION COMMENTS: 1/4/02 Stone under line from house conn. to house OK to cover all work (SC)

INSPECTOR [Signature]

DATE SYSTEM APPROVED 1/10/02

BUILDING PERMIT SIGNED AND RETURNED