

PERMIT

SEWAGE DISPOSAL SYSTEM

MARYLAND STATE DEPARTMENT OF HEALTH

HOWARD COUNTY

ELLICOTT CITY

DISTRICT 5th

DATE 5/23/73

INDEXED

App. 5-29-73
18517
A 15756

Jack Fyock IS PERMITTED TO INSTALL ALTER

ADDRESS Ten Oaks Road, Glenelg, Maryland PHONE 286-2939

A SEWAGE DISPOSAL SYSTEM LOCATED AT _____

SUBDIVISION Linden Chapel Hills ROAD 13504 Orion Drive LOT 8, Blk. A, Sec. 2

PROPERTY OWNER Frank F. & Linda Willson, et. al. Ervin D. & Darlene Summerfield

ADDRESS Ashton, Maryland 20702

SPECIFICATIONS 4 bedrooms

DRAIN FIELD _____ DEPTH _____ FEET, BOTTOM AREA _____ SQ. FT.

SEEPAGE PITS _____ ABSORBENT SIDE-WALL AREA _____ SQ. FT.

SEPTIC TANK CAPACITY 1250 GALLONS

FOR GARBAGE GRINDER, INCREASE DISPOSAL AREA 22% & TANK CAPACITY 50%.

OTHER DRY WELL - To be 100 sq. ft. of absorbent sidewall area below the inlet pipe per bedroom. Inlet to begin 4 ft. below original grade. Maximum depth of dry well to be 12 ft. below original grade. Locate dry well 45 ft. from front lot line and 75 ft. from left lot line as seen when facing lot from the front. Drinking well to be approximately 35 ft. behind house.

NOTE: ALL PIPE FROM HOUSE TO DRY WELL MUST BE CAST IRON.

PERMIT VOID AFTER THREE YEARS.

NOTE: INSTALL STAND PIPE ON SEPTIC TANK AND DRY WELL.

PLANS APPROVED BY J. T. Wright & D. W. Monaghan DATE 4/21/71

FILL SEPTIC TANK AND DISTRIBUTION BOX WITH WATER BEFORE CALLING FOR AN INSPECTION. COVER NO WORK UNTIL INSPECTED AND APPROVED.


NEITHER THE HOWARD COUNTY COMMISSIONERS NOR THE HEALTH DEPARTMENT IS RESPONSIBLE FOR THE SUCCESSFUL OPERATION OF ANY SYSTEM.

BLDG. PERMIT SIGNED AND RETURNED 5/16/73
Serial # 54026
Storage/garage

BLDG. PERMIT SIGNED AND RETURNED 6/4/73
Serial # 12330
new main & dist.

A15756

REVISIONS

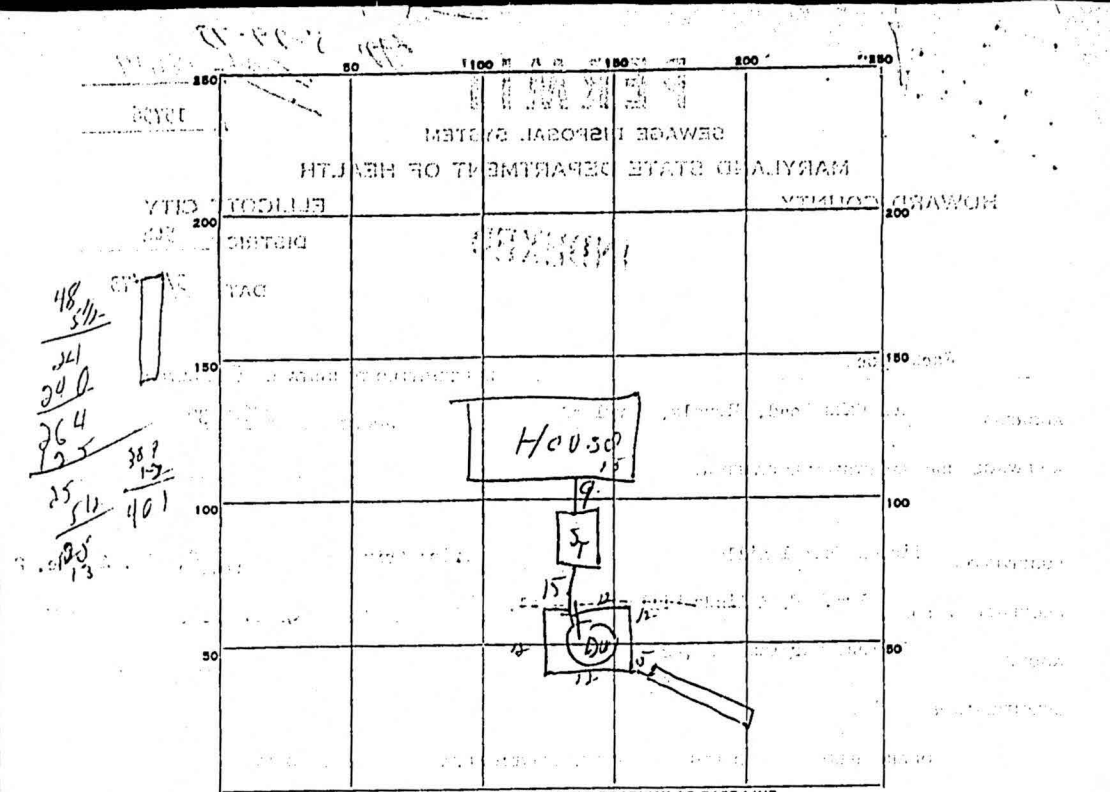

INDICATE NORTH - NAME ADJOINING ROADWAY AS BASE LINE.

Chris D... ..

PERMIT CARD _____

SEPTIC TANK, LEVEL 0 2 CLEANOUTS OK

DISTRIBUTION BOX, LEVEL _____

TILE FIELD, DEPTH _____ FT. TRENCH WIDTH _____ FT.

GRAVEL DEPTH _____ IN. TOTAL LENGTH _____ FT.

NUMBER OF TRENCHES _____ TOTAL BOTTOM AREA _____

SEEPAGE PITS, INSIDE DIAMETER 48 FT. DEPTH BELOW INLET 5 1/2 FT.

ABSORBENT AREA 264 SQ. FT. 402 sq. ft.

REMARKS brick septic 138

DATE SYSTEM APPROVED 5/29/73 INSPECTOR DW. M... ..