

9/30/01 - 1000
5/31/01 - LAYOUT
11-1 pm
6/1/01
PM
05-421772

PERMIT

SEWAGE DISPOSAL SYSTEM
HOWARD COUNTY HEALTH DEPARTMENT
BUREAU OF ENVIRONMENTAL HEALTH
410-313-2640

P 515 258-A
A 49412

ISSUE DATE 5/23/2001
APPROVAL DATE 7/10/01

INDEXED

Fogles Septic Clean, Inc IS PERMITTED TO INSTALL X ALTER

ADDRESS 580 Obrecht Road, Sykesville, MD 21784 PHONE 410-795-5670

UBDIVISION Paternal Gift Farm LOT NUMBER 11 ADDRESS 13517 Paternal Gift Drive

PROPERTY OWNER Mark Norwicz PROPERTY OWNER'S ADDRESS 7308 Woodrush Court 21075

SEPTIC TANK CAPACITY 1250 GALLONS * **TOP SEAMED SEPTIC TANK REQUIRED ***

PUMP CHAMBER CAPACITY N/A GALLONS

NUMBER OF BEDROOMS 4 ** **INSTALL TRENCHES 10' APART CENTER-TO-CENTER TO LEAVE ADEQUATE REPAIR CAPACITY ****

SQUARE FEET PER BEDROOM 180 **(MR) SRK**

LINEAR FEET OF TRENCH REQUIRED 240

TRENCHES: Trenches to be 3 feet wide. Inlet 4 feet below original grade. Bottom maximum depth 6 feet below original grade. 2 feet of stone below distribution box pipe

LOCATION: Place the distribution box 45' from the front lot line and 60' from the right lot line. Run trenches on contour to right side of lot.

Required layout: 40', 70', 70', 70'

PLANS APPROVED Mark Rifkin, R.S. OK SRK 2/2/01 DATE 1/24/2001


PERMIT VOID AFTER 2 YEARS

- NOTE: CONTRACTOR RESPONSIBLE FOR SCHEDULING A PRE-CONSTRUCTION INSPECTION FOR ALL INSTALLATIONS
- NOTE: TOP OF SEPTIC TANKS ARE TO BE NO DEEPER THAN 3.0 FEET BELOW FINISH GRADE
- NOTE: WATERTIGHT SEPTIC TANKS REQUIRED
- NOTE: CLEANOUT REQUIRED EVERY 70 FEET OF SEWER LINE AND/OR AT 90° SWEEPS IN LINES FROM HOUSE TO DRAIN FIELDS, 90° ELBOWS ARE NOT ACCEPTABLE
- NOTE: ALL PARTS OF SEPTIC SYSTEMS (I.E. TANK, DISTRIBUTION BOX, DRAINFIELDS) TO BE 100 FEET FROM ANY WATER WELL UNLESS OTHERWISE SPECIFICALLY AUTHORIZED
- NOTE: NO ABSORPTION TRENCH TO EXCEED 100 FEET IN LENGTH UNLESS SPECIFICALLY AUTHORIZED
- NOTE: ALL PIPE FROM HOUSE TO SEPTIC TANK MUST BE CAST IRON OR SCHEDULE 35/40 PVC OR ABS
- NOTE: MANHOLE RISERS REQUIRED ON ALL SEPTIC TANKS AND PUMP CHAMBERS
- NOTE: DISTRIBUTION BOXES MUST HAVE BAFFLES
- NOTE: IF PUMPED SEPTIC SYSTEM REQUIRED, (1) SEPTIC PUMP DETAIL TO BE PROVIDED BY INSTALLER PRIOR TO ISSUANCE OF SEPTIC PERMIT (2) PUMP PERFORMANCE TEST IS NECESSARY PRIOR TO HEALTH DEPARTMENT APPROVAL OF SEPTIC PERMIT

NEITHER THE HOWARD COUNTY COUNCIL NOR THE HEALTH DEPARTMENT IS RESPONSIBLE FOR THE SUCCESSFUL OPERATION OF ANY SYSTEM
PERMITTEE RESPONSIBLE FOR OBTAINING FINAL APPROVAL ON THIS PERMIT
CALL 410-313-2640 FOR INSPECTION OF SEPTIC SYSTEM

1515258-A

NOT TO SCALE

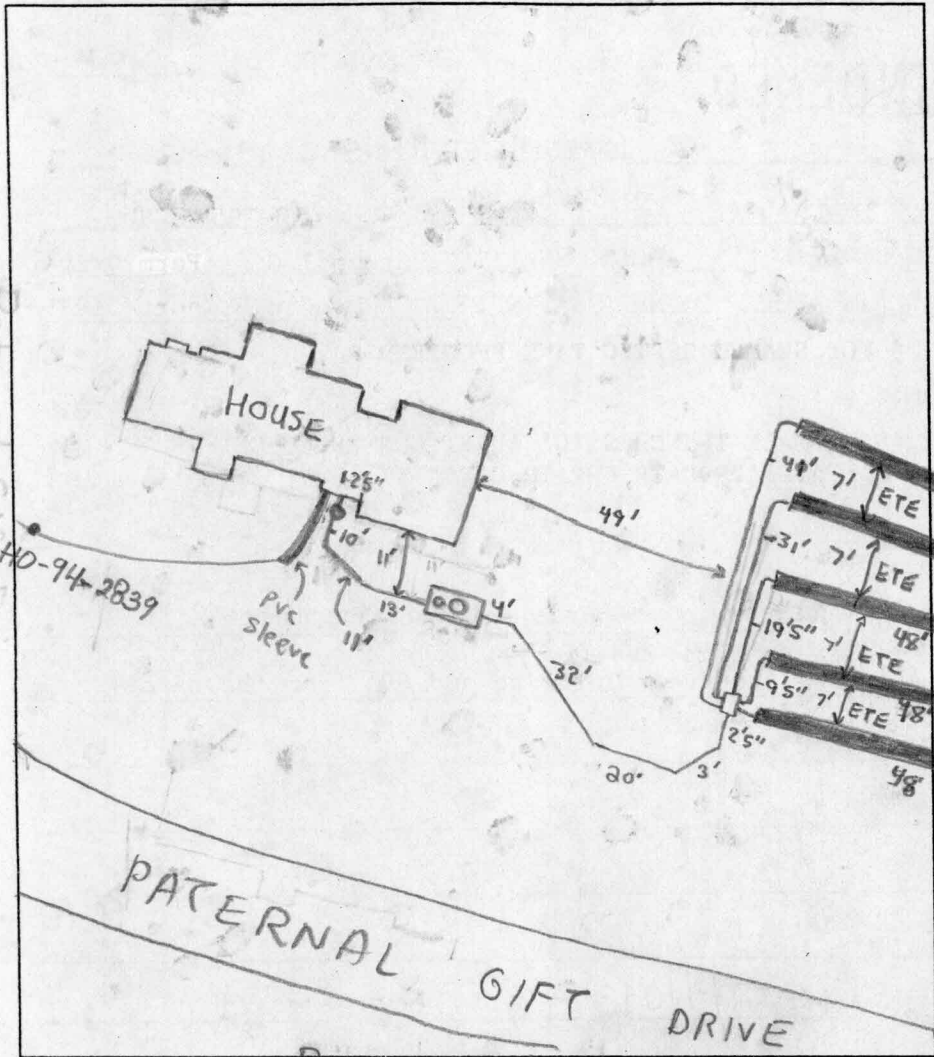

TRENCH DATA

TRENCH WIDTH 3'
 TRENCH INLET DEPTH 3'
 TRENCH BOTTOM DEPTH 6'
 DEPTH OF STONE 3'
 NUMBER OF TRENCHES 5
 TOTAL TRENCH LENGTH 240'
 ABSORBENT AREA 720 ft²
 DISTRIBUTION BOX LEVEL
 BAFFLE IN DISTRIBUTION BOX

SEPTIC TANK DATA

SEPTIC TANK 1250 TS GALLONS
 BAFFLES IN MANHOLE RISER on center
 6 INCH INSPECTION PORT on front

PUMP CHAMBER DATA

PUMP CHAMBER GALLONS NA
 MANHOLE RISER NA
 ALARM NA
 PUMP PERFORMANCE TEST NA

Paternal Gift Drive

PRE-CONSTRUCTION INSPECTION: 5/30/01 - LAYOUT CANCELLED - AREA NOT STAKED - (SRK)

5/31/01 Contour different than on plan. To install 5-48' trenches at highest part of easement. (RB)

INSPECTION COMMENTS: 6/1/01 - ON TO COVER ALL WORK, HOUSE CONN. STILL NEEDED

(SRK) 7/10/01 - HOUSE CONN. MADE - (SRK)

INSPECTOR Steven R. Krieg

DATE SYSTEM APPROVED 7/10/01