

6/13/01
ASAP
Layout

PERMIT

P 515282

SEWAGE DISPOSAL SYSTEM
HOWARD COUNTY HEALTH DEPARTMENT
BUREAU OF ENVIRONMENTAL HEALTH
410-313-2640

A 49398

ISSUE DATE 6-20-01

APPROVAL DATE 6-13-01

INDEXED

05-421721

C & C Utility Service

IS PERMITTED TO INSTALL ALTER

ADDRESS 7398 Gaither Road, Sykesville, MD 21784 PHONE 410-984-4851

SUBDIVISION Paternal Gift Farm LOT NUMBER 7 ADDRESS 13537 Paternal Gift Drive

PROPERTY OWNER John & Donna Triscoli PROPERTY OWNER'S ADDRESS 8818 Heron's Flight
N. Laurel, MD 20723

SEPTIC TANK CAPACITY 1250 GALLONS

PUMP CHAMBER CAPACITY _____ GALLONS *** TOP SEAMED SEPTIC TANK REQUIRED ***

NUMBER OF BEDROOMS 4

SQUARE FEET PER BEDROOM 180

LINEAR FEET OF TRENCH REQUIRED 240

TRENCHES: Trenches to be 3 feet wide. Inlet 3 feet below original grade. Bottom maximum depth
5 feet below original grade. 2 feet of stone below distribution ~~box~~ pipe.

LOCATION: Place the distribution box 95 feet off the right (245.24') lot line and
95 feet from the rear (193.20') lot line as viewed from Paternal Gift Drive. Install
trenches on contour toward ~~left~~ lot line. *OK 6/22/00 DC*

*Set Septic Tank So That It Is Not In Proposed Patio
Area - Suggest That Pipe Under Patio Be Sleeved*

PLANS APPROVED Mark Rifkin DATE 6/5/2000

PERMIT VOID AFTER 2 YEARS

NOTE: CONTRACTOR RESPONSIBLE FOR SCHEDULING A PRE-CONSTRUCTION INSPECTION FOR ALL INSTALLATIONS

NOTE: TOP OF SEPTIC TANKS ARE TO BE NO DEEPER THAN 3.0 FEET BELOW FINISH GRADE

NOTE: WATERTIGHT SEPTIC TANKS REQUIRED

NOTE: CLEANOUT REQUIRED EVERY 70 FEET OF SEWER LINE AND/OR AT 90° SWEEPS IN LINES FROM HOUSE TO DRAIN FIELDS, 90° ELBOWS
ARE NOT ACCEPTABLE

NOTE: ALL PARTS OF SEPTIC SYSTEMS (I.E. TANK, DISTRIBUTION BOX, DRAINFIELDS) TO BE 100 FEET FROM ANY WATER WELL UNLESS
OTHERWISE SPECIFICALLY AUTHORIZED

NOTE: NO ABSORPTION TRENCH TO EXCEED 100 FEET IN LENGTH UNLESS SPECIFICALLY AUTHORIZED

NOTE: ALL PIPE FROM HOUSE TO SEPTIC TANK MUST BE CAST IRON OR SCHEDULE 35/40 PVC OR ABS

NOTE: MANHOLE RISERS REQUIRED ON ALL SEPTIC TANKS AND PUMP CHAMBERS

NOTE: DISTRIBUTION BOXES MUST HAVE BAFFLES


NOTE: IF PUMPED SEPTIC SYSTEM REQUIRED, (1) SEPTIC PUMP DETAIL TO BE PROVIDED BY INSTALLER PRIOR TO ISSUANCE OF SEPTIC
PERMIT (2) PUMP PERFORMANCE TEST IS NECESSARY PRIOR TO HEALTH DEPARTMENT APPROVAL OF SEPTIC PERMIT

NEITHER THE HOWARD COUNTY COUNCIL NOR THE HEALTH DEPARTMENT IS RESPONSIBLE FOR THE
SUCCESSFUL OPERATION OF ANY SYSTEM
PERMITTEE RESPONSIBLE FOR OBTAINING FINAL APPROVAL ON THIS PERMIT
CALL 410-313-2640 FOR INSPECTION OF SEPTIC SYSTEM

P 515282

NOT TO SCALE

INDEXED

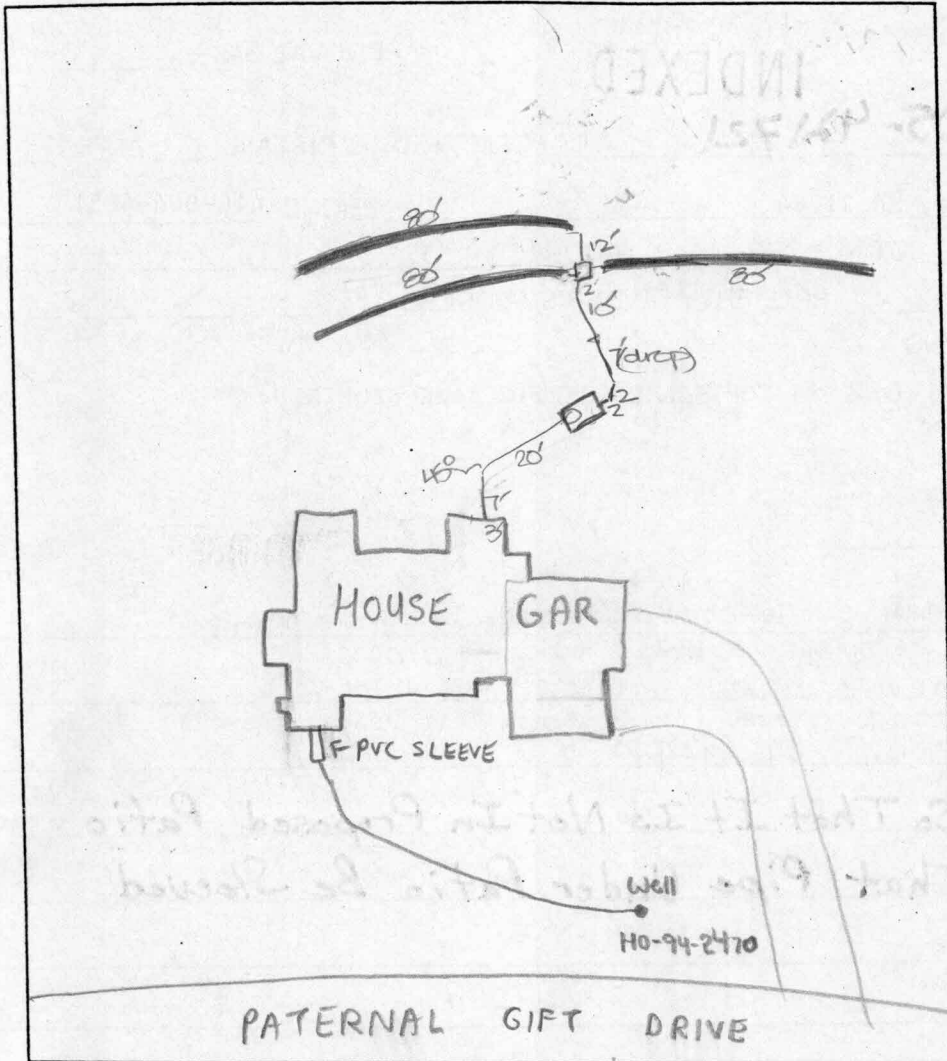

TRENCH DATA

TRENCH WIDTH 3

TRENCH INLET DEPTH 3

TRENCH BOTTOM DEPTH 5

DEPTH OF STONE 2

NUMBER OF TRENCHES 3

TOTAL TRENCH LENGTH 180

ABSORBENT AREA 540

DISTRIBUTION BOX LEVEL

BAFFLE IN DISTRIBUTION BOX

SEPTIC TANK DATA

SEPTIC TANK 1500 GALLONS

MANHOLE RISER N/A

6 INCH INSPECTION PORT

PUMP CHAMBER DATA

PUMP CHAMBER GALLONS _____

MANHOLE RISER _____

ALARM _____

PUMP PERFORMANCE TEST _____

PRE-CONSTRUCTION INSPECTION: 4/13/01 layout confirmed - SDA staked - septic tank set - OK to run trenches in both directions to best utilize SDA. DIC

INSPECTION COMMENTS: 4/13/01 P.M. FINAL INSP - OK to cover all septic work. DIC

INSPECTOR Diana K. Clark DATE SYSTEM APPROVED 4/13/01