

2/3/74 file copy
10/12

PERMIT

P 21058

SEWAGE DISPOSAL SYSTEM

A _____

MARYLAND STATE DEPARTMENT OF HEALTH

Visual hole for s/d
X 44150

HOWARD COUNTY

ELLICOTT CITY

INDEXED

DISTRICT 3rd

DATE 12/30/74

Jack Fyock

IS PERMITTED TO INSTALL ALTER X

ADDRESS Ten Oaks Road, Glenelg, Maryland PHONE 286-2939

A SEWAGE DISPOSAL SYSTEM LOCATED AT _____

SUBDIVISION _____ ROAD 3080 Pfefferkorn Road LOT _____

PROPERTY OWNER Mr. Miller Jan & Debra Paper

ADDRESS 3080 Pfefferkorn Road, West Friendship, Md.

SPECIFICATIONS

DRAIN FIELD _____ DEPTH _____ FEET. BOTTOM AREA _____ SQ. FT.

SEEPAGE PITS _____ ADSORBENT SIDE-WALL AREA _____ SQ. FT.

SEPTIC TANK CAPACITY _____ GALLONS

FOR GARBAGE GRINDER, INCREASE DISPOSAL AREA 25% & TANK CAPACITY 50%.


OTHER REPAIR - Call for inspection when ground is opened up and Sanitarian will recommend repair system.

PLANS APPROVED BY Palmer P. Wine DATE 12/30/74

FILL SEPTIC TANK AND DISTRIBUTION BOX WITH WATER BEFORE CALLING FOR AN INSPECTION. COVER NO WORK UNTIL INSPECTED AND APPROVED.

NEITHER THE HOWARD COUNTY COMMISSIONERS NOR THE HEALTH DEPARTMENT IS RESPONSIBLE FOR THE SUCCESSFUL OPERATION OF ANY SYSTEM.

PERMIT SIGNED
DATE 1/9/75
SEAL # 50314
Richard Ketchum
Seal

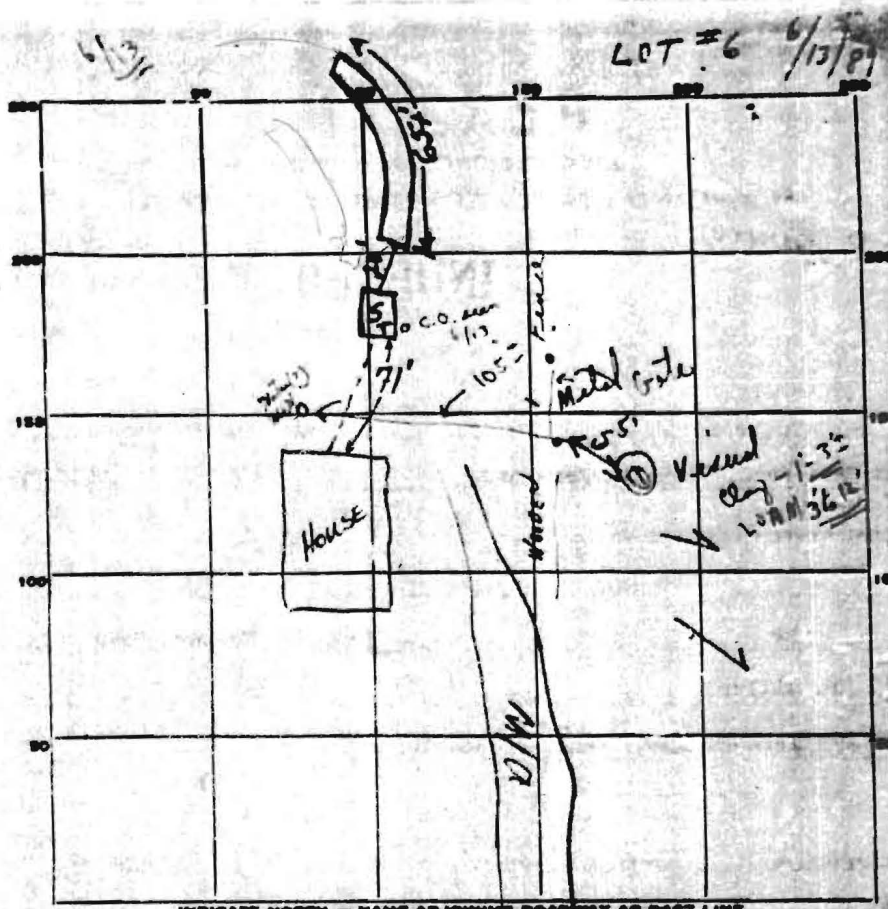

6/13 2.00-2.15
 3 180°
 4
 60 120 H 2
 - 423
 29 752
 50
 ~ 300 ft

INDICATE NORTH - NAME ADJOINING ROADWAY AS BASE LINE.

← OK PFEFFERDORN RD → N

PERMIT CARD OK

SEPTIC TANK LEVEL New 1000 gal ST CLEANOUTS

DISTRIBUTION BOX LEVEL _____

TILE FIELD, DEPTH _____ FT. TRENCH WIDTH 2 1/2 FT.

GRAVEL DEPTH 6 1/2 FT. TOTAL LENGTH 65 FT.

NUMBER OF TRENCHES 1 TOTAL SIDEWALL 423 BOTTOM AREA

SEEPAGE PITS, INSIDE DIAMETER _____ FT. DEPTH BELOW INLET _____ FT.

ABSORBENT AREA _____ SQ. FT.

REMARKS 12/31/74 New ST installed because old metal ST had allegedly caved in. ~ 6 1/2' gravel was pipe in trench.

DATE SYSTEM APPROVED 12/31/74 INSPECTOR William H. Zapp