

# APPLICATION

SEWAGE DISPOSAL TESTING

STATE OF MARYLAND - DEPARTMENT OF HEALTH AND MENTAL HYGIENE

A 30982  
P \_\_\_\_\_

HOWARD COUNTY HEALTH DEPARTMENT  
ENVIRONMENTAL HEALTH SERVICES

P.O. BOX 476 ELLICOTT, MARYLAND 21043  
TELEPHONE: 992-2330

~~10/23/80~~  
9:30 A.M.

DISTRICT 6th  
DATE 10/14/80

10/24/80 p.m.  
1:30 ENGINEERS:

DEVELOPMENT CONSULTANTS GROUP, INC  
12408 MD. RT. 108  
CLARKSVILLE, MD.  
301-596-9080 c/o LEE SUTHERLAND

TO: THE COUNTY HEALTH OFFICER  
ELLICOTT CITY, MARYLAND

I, HEREBY, APPLY FOR THE NECESSARY TEST IN ORDER TO CONSTRUCT (OR RECONSTRUCT) A SEWAGE DISPOSAL SYSTEM.

"CONTRACT"  
PROPERTY OWNER ROBERT A. DAPPER

ADDRESS 8494 RESERVOIR RD. PHONE 792-7690  
FULTON, MD. 20759

PROPERTY LOCATION

SUBDIVISION TAX MAP 42 PARCEL # 29  
LOT NO.

ROAD AND DESCRIPTION PROPERTY IS LOCATED ON N.E. CORNER OF BERGER  
RD AND PROPOSED RELOCATED MD. RTE. 32

SIZE OF LOT APPROX. ONE-HALF (1/2) ACRE TYPE BLDG. WAREHOUSE

THE SYSTEM INSTALLED UNDER THIS APPLICATION IS ACCEPTABLE ONLY UNTIL PUBLIC FACILITIES BECOME AVAILABLE.

I FULLY UNDERSTAND THE FEE CONNECTED WITH THE FILING OF THIS PERC TEST APPLICATION IS NON-REFUNDABLE UNDER

ANY CIRCUMSTANCES.

SIGNATURE OF APPLICANT William H. Harden, Jr. (AGENT - DCG, INC)

APPROVED BY \_\_\_\_\_ FOR \_\_\_\_\_ DATE \_\_\_\_\_

REJECTED BY C.B. Stecker FOR any type of DATE 10/24/80  
system in area  
of tests

HOLD PENDING FURTHER TESTS \_\_\_\_\_ DATE \_\_\_\_\_


REASONS FOR REJECTION OR ~~REJECTION~~ Water + clay in areas of tests  
C.B.S.

# THIS IS NOT A PERMIT

PARCEL # 29

SOIL PROFILE

SEE EACH HOLE BELOW

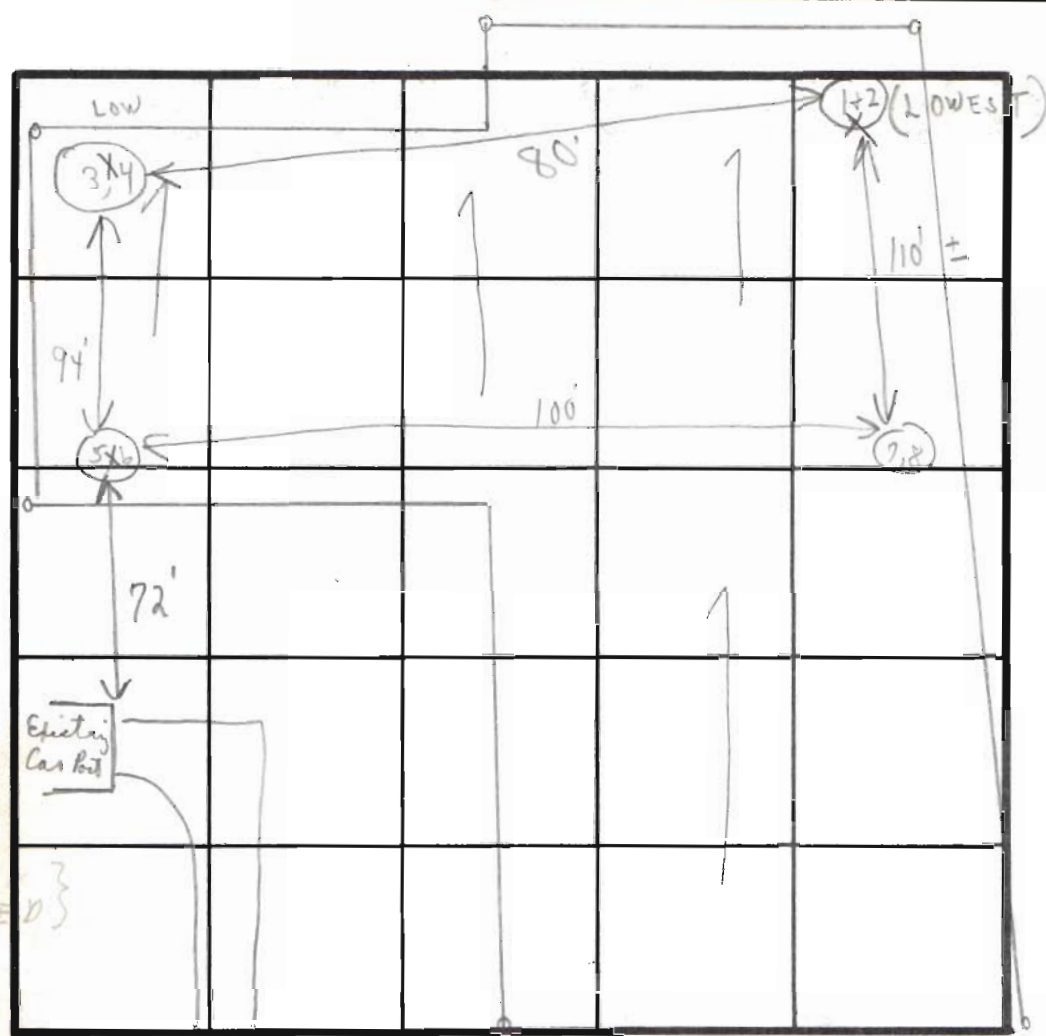

PROPOSED RELOCATED MD. RT. 32

FIELD SHEET HOLES STAKED

INDICATE NORTH - NAME ADJOINING ROADWAY AS BASE LINE.  
BERGER ROAD

SOIL PROFILE

DATE	TEST NO.	DEPTH	PRE-WET		TEST - 1" DROP		TIME
			START	STOP	START	STOP	
10/24/80	① px.	3 1/2'	2:14		@ 2:44	No perc	X
	②	13'	@ 12'	-13'		Water out of sidewalk	WATER
	③	4'	3:07		@ 3:37 1/2"	little perc	XX
	④	12 1/2'	@ 8'	appears	@ 9 1/2"	Water out of sidewalk	XX
	⑤ px	4 1/2'	2:58		3:28	NO PERC	XX
	⑥	14'			Water @ 13'		XX
	⑦	4'	3:33		@ 4:03 1/8"	little perc	XX
	⑧	13'	X:X		Water @ 12'		XX

failures

REMARKS

(PLAT 9-1980) { REJECT IN AREA OF TESTS }  
C.B.S.


TYPE OF SOIL

TESTED BY

C.B.S.

ALSO PRESENT

O. KETTERMAN  
+ O. RANDSON  
BILL WARDEN  
OF SURVEYOR

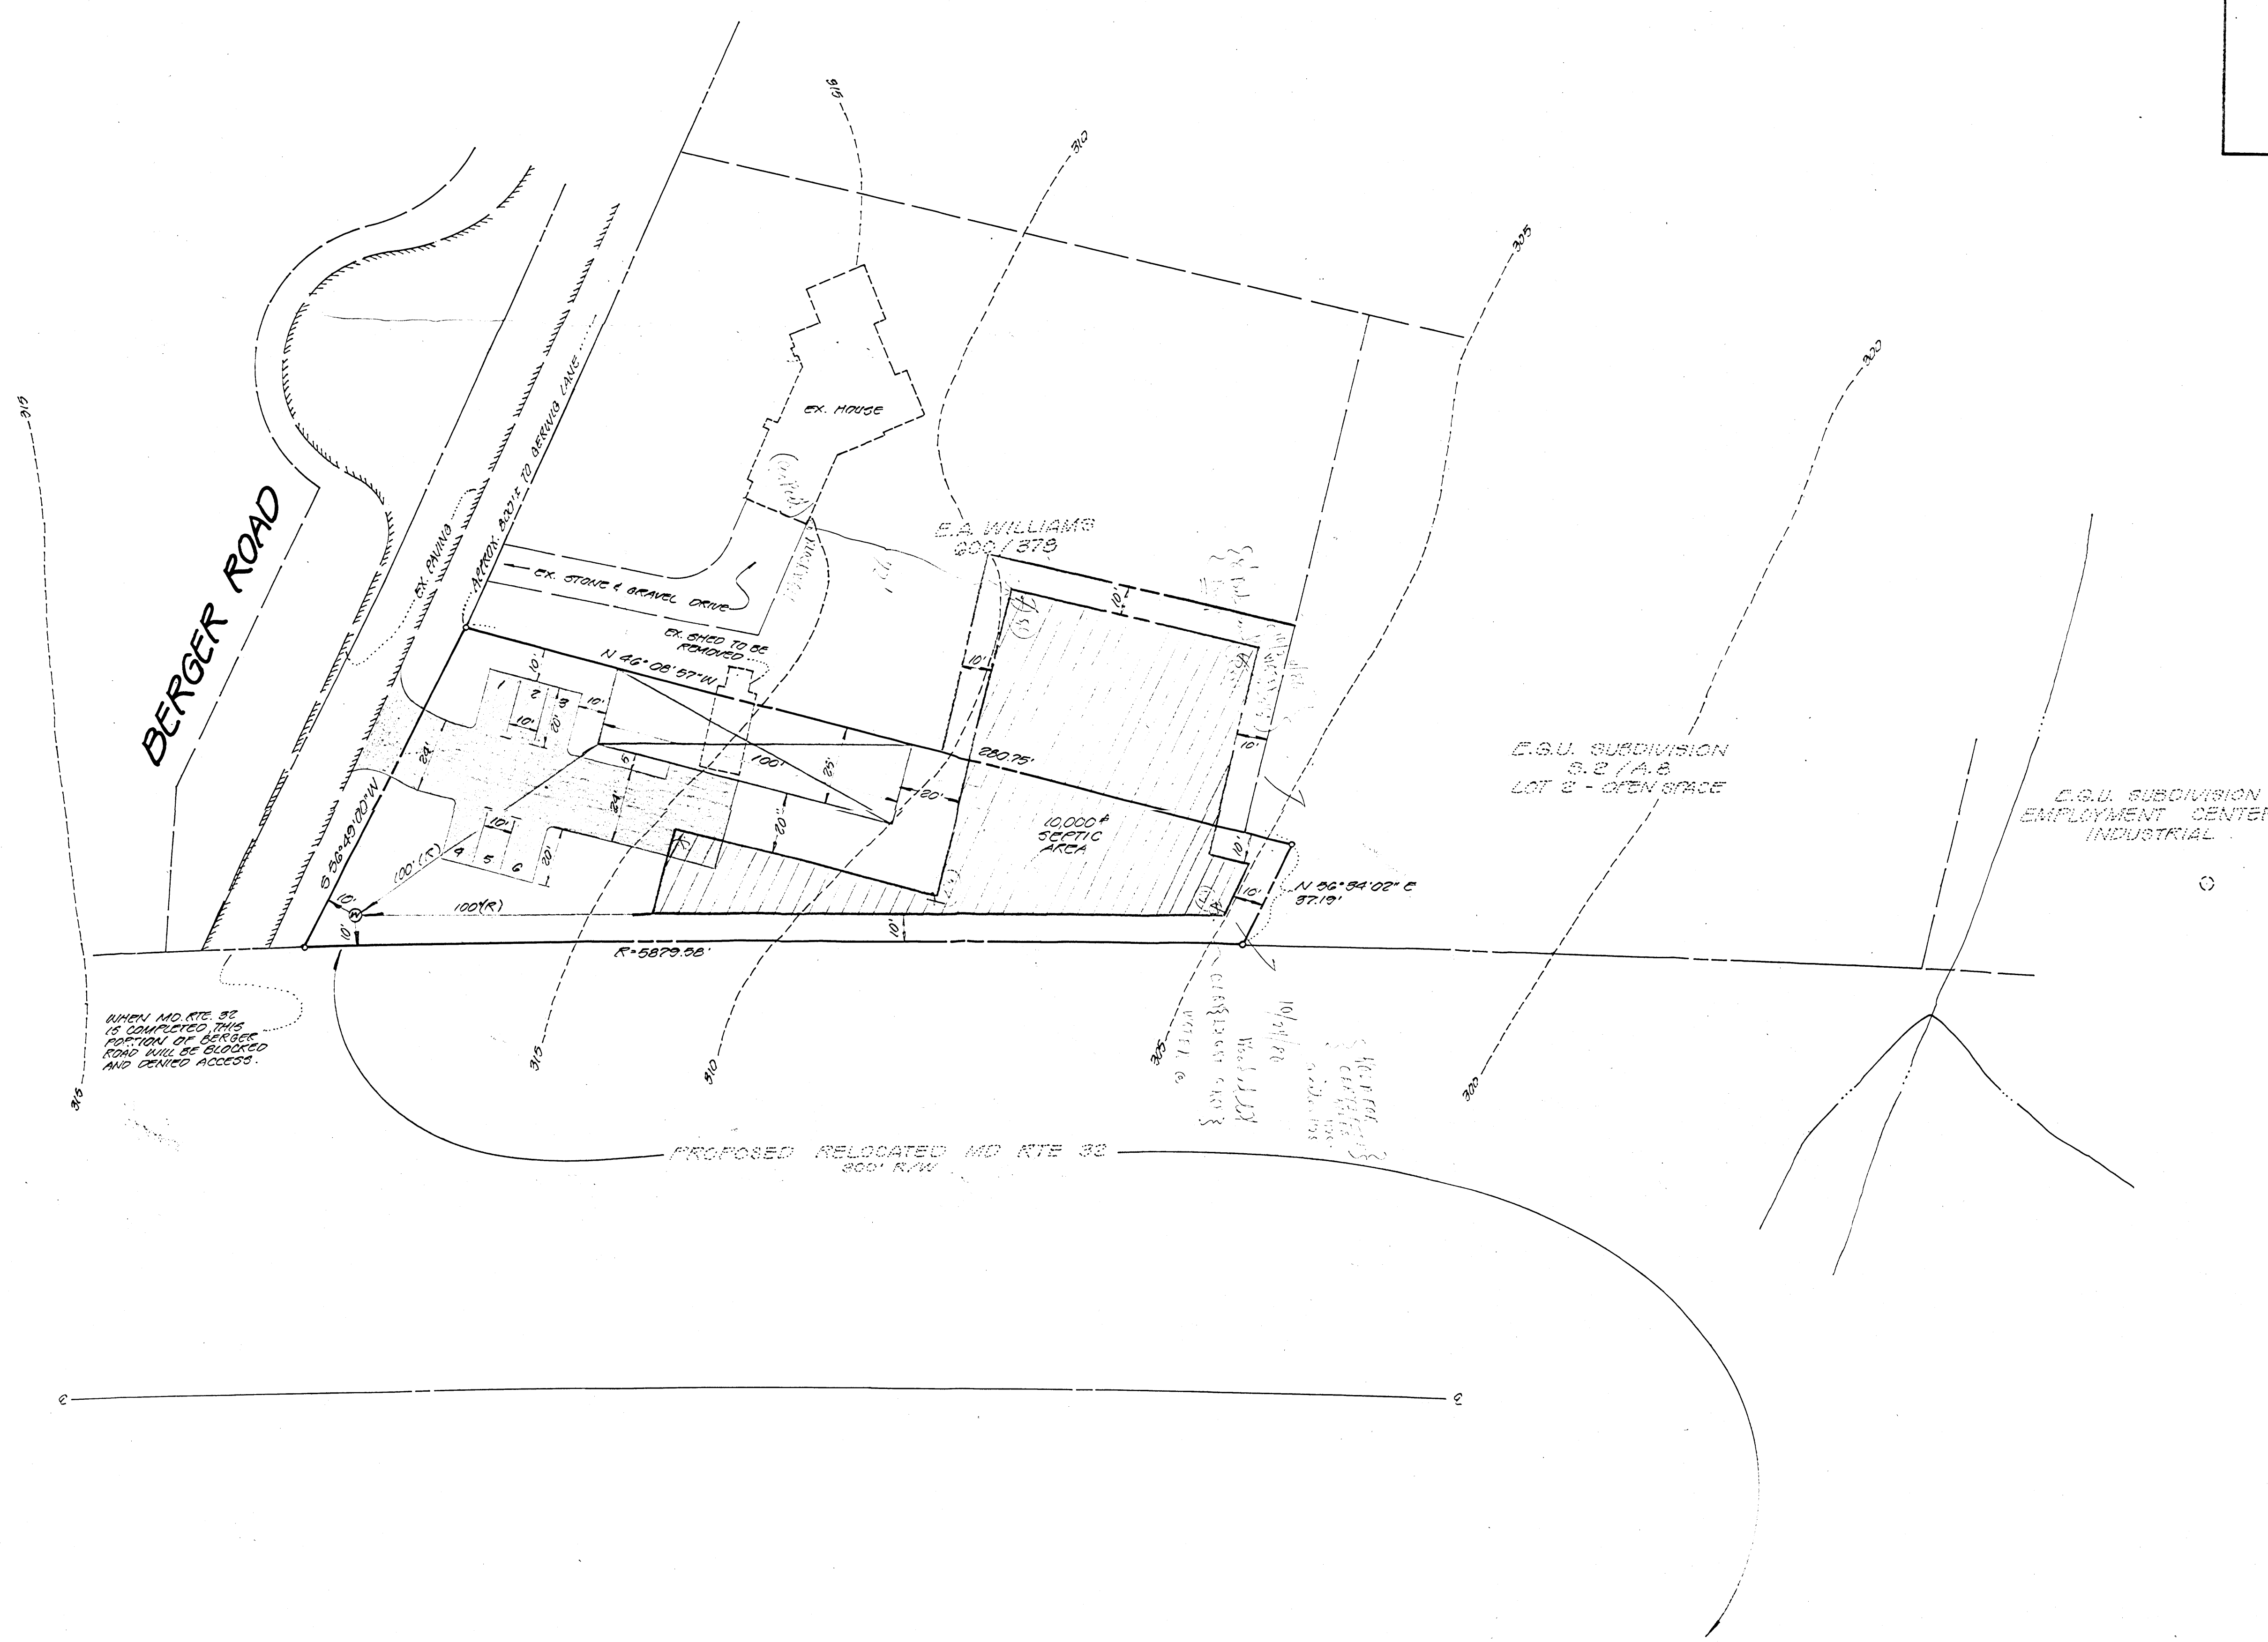

Owner:	NO.	REVISIONS	DATE
ROBERTS ORGANIC % ROBERT A. DARTNER			
FULTON, MD. 20759 301-296-2600 (BALTIMORE) 202-528-5005 (WASHINGTON)			



**DEVELOPMENT  
CONSULTANTS  
GROUP, INC.**

PROPOSED WAREHOUSE SITE  
"PARCEL 29"  
6<sup>TH</sup> ELECTION DISTRICT - TAX MAP 02  
HOWARD COUNTY, MARYLAND

DATE	Sheet
08/11/00	/
DRAWN	of /
SLW/GO	
CHECKED	PROJECT NO.
MLL	21-00
SCALE	
1" = 50'	

October 27, 1980

Mr. Bill Harden  
Development Consultants Group, Inc.  
12408 Route 108  
Clarksville, Maryland 21039

RE: Parcel #99 - Berger Road  
½ acre

Dear Mr. Harden:

Please be advised that the percolation tests conducted by the Howard County Health Department on the above referenced property failed for any type of in ground sewage disposal system. Enclosed is a copy of the field percolation test sheet.

If there are any questions concerning the above property, please call the health department at 992-2330 and/or visit the office at 3716 Court Place, Ellicott City between 8:30 to 4:30 Monday thru Friday.

Very truly yours,

Charles B. Streaker, Sanitarian  
Water and Sewerage Program

C.B.S.  
CBS:hs



DEVELOPMENT  
CONSULTANTS  
GROUP, INC.

~~Suite 235~~  
~~Long Reach Village Center~~  
~~Columbia, Md., 21045~~  
~~301-596-3811~~

TRANSMITTAL

Project "P. 29" BERGER RD.

Project # 21-00

~~Suite 204~~  
~~431 North Frederick Ave.~~  
~~Cathersburg, Md., 20760~~  
~~301-924-2353~~

To: HEALTH DEPT

Date: 10/10/80

Subject: PARCEL 29  
BERGER RD.

Attn: FRANK SKINNER

Transmitted: Herewith  Under Separate cover  Via:

No. of  
Copies

Description

No. of Copies	Description
<u>3</u>	<u>SITE LOCATION W/ SEPTIC AREA &amp; WATER WELL SITE PROPOSALS FOR PERCOLATION TESTS</u>

Submitted:  At your request  For your review  For your file  
 For your approval  For your action  For your information

General Remarks:

ADDRESS OF ENGINEERS: 12408 MD. RT. 108  
CLARKSVILLE, MD.  
301-596-9080

Enclosure:

Copies to:

By:

Bill Hand  
596-9080



DEVELOPMENT  
CONSULTANTS  
GROUP, INC.

BILL "SLUGGO" HARDEN

SEND COPY TO ↑

12408 ROUTE 108  
CLARKSVILLE, MD, 21029

TELEPHONE  
301-596-9080  
301-988-9830