

APPLICATION

PERCOLATION TESTING

A 517422-A

P _____

HOWARD COUNTY HEALTH DEPARTMENT
BUREAU OF ENVIRONMENTAL HEALTH
3525-H ELLICOTT MILLS DRIVE/ELLICOTT CITY, MARYLAND 21043
TELEPHONE: 410-313-2640

DISTRICT _____
DATE _____

TO: THE COUNTY HEALTH OFFICER
ELLICOTT CITY, MARYLAND

I HEREBY APPLY FOR THE NECESSARY TEST PRIOR TO APPLICATION FOR PERMIT TO CONSTRUCT (OR RECONSTRUCT) A SEWAGE DISPOSAL SYSTEM.

PROPERTY OWNER Frank J. DeFrancis Revocable Trust, Joseph A. DeFrancis, Trustee

ADDRESS 5192 Sheppard Lane, Clarksville, MD 21039 PHONE _____

AGENT OR PROSPECTIVE BUYER Heritage Land Development

ADDRESS 3060 Washington Rd., Suite 220, Glenwood, MD 21738 PHONE 410-489-7900

PROPERTY LOCATION:

SUBDIVISION WALNUT GROVE LOT NO. 52

ROAD AND DESCRIPTION _____
5192 Sheppard Lane, Clarksville, MD 21039

TAX MAP NO. 28 PARCEL # 74

SIZE OF LOT 1 Acre TYPE OF BLDG. SFD
(SINGLE FAMILY DWELLING OR COMMERCIAL)

THE SYSTEM INSTALLED UNDER THIS APPLICATION IS ACCEPTABLE ONLY UNTIL PUBLIC FACILITIES BECOME AVAILABLE. I FULLY UNDERSTAND THE FEE CONNECTED WITH THE FILING OF THIS PERC TEST APPLICATION IS NON-REFUNDABLE UNDER ANY CIRCUMSTANCES. I ALSO AGREE TO COMPLY WITH ALL M.O.S.H.A. REQUIREMENTS IN TESTING THIS LOT.

(SIGNATURE OF APPLICANT)

APPROVED BY _____ FOR _____ DATE _____

DISAPPROVED BY _____ FOR _____ DATE _____

HOLD PENDING FURTHER TESTS _____

REASONS FOR REJECTION OR HOLDING _____

PERCOLATION TEST PLAT/PRELIMINARY PLAT - TITLE OR I.D. # _____ DATE _____

SITE DEVELOPMENT PLAN/FINAL PLAT - TITLE OR I.D. # _____ DATE _____

THIS IS NOT A PERMIT

517422-A


COUNTY #

SOIL PROFILE

0' (1227)
 Red Or Br Heavy Loams 4'-6'
 Red Br Sa Loam
 With Large Boulders ~30% Rock and Saprolite 8'
 >50% Rock Hard Bottom 10'

(1228)
 Red Or Br Heavy Loam 5'
 Or Br Loam
 With Several Large Boulders
 Hard Bottom 6.5'

(1231)
 Red Or Br Heavy Loam 5'
 Red Br and Or Br Loams ~10% Rock 7.5'
 Beige Sa Loam ~15% Rock and Saprolite 13'

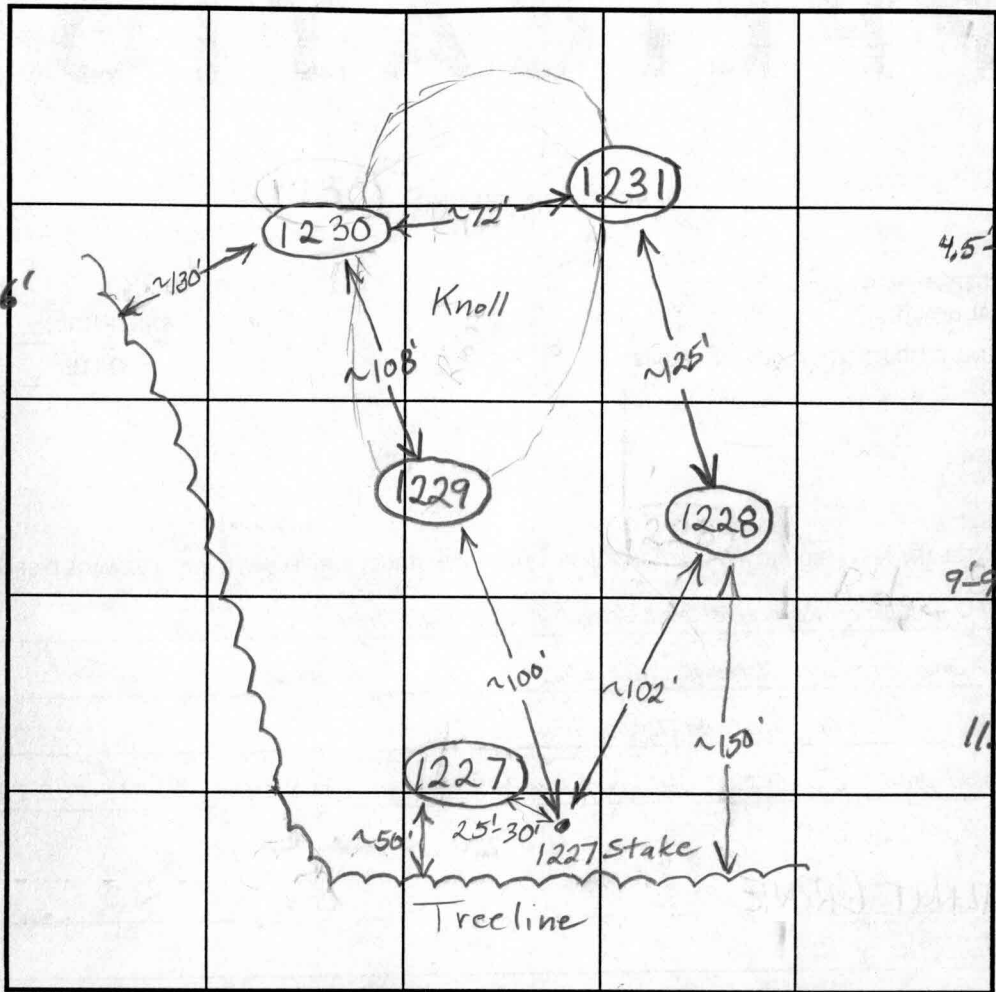

SOIL PROFILE

0' (1230)
 Red Br Heavy Loam 4.5'-5'
 Or Br Loam Less Than 10% Rock No Obvious Mottling Caving at 8.5'
 Beige and Light Br Sa Loam ~15% Saprolite Water 11.5'

INDICATE NORTH - NAME ADJOINING ROADWAY AS BASE LINE.

DATE	TEST NO.	DEPTH	PRE-WET		TEST - 1" DROP		TIME	
			START	STOP	START	STOP		
11/25/02	1227	4' / 10' v	9:54	No Movement in 10 minutes			(F)	
	1228	6.5' v		Hard Bottom			(F)	
	1231	4' / 13' v	10:10	10:32	Little Movement in 15 Minutes		Slow W.S.	
			Retest in Wet Season if Usable					
	1230	11.5' v					(F)	

REMARKS 1229 Not Dug, 1227 Not Dug at Stake
 TYPE OF SOIL _____
 TESTED BY B. Baker / S. Oster ALSO PRESENT _____
 TRENCH DESIGN DATA: AVG. PERCOLATION TIME _____ TRENCH WIDTH _____
 INLET DEPTH _____ MAXIMUM BOTTOM DEPTH _____ SQ. FT./BEDROOM _____