



APPLICATION

FOR PERCOLATION TESTING AND SITE EVALUATION

TEST DATE(S) _____ TEST TIME _____

APR 532587

AGENCY REVIEW: _____

DATE 4/6/10

DO NOT WRITE ABOVE THIS LINE

I HEREBY APPLY FOR THE NECESSARY TESTING/EVALUATION PRIOR TO ISSUANCE OF SEWAGE DISPOSAL SYSTEM PERMIT(S) TO:

CHECK AS NEEDED:

CHECK AS NEEDED:

- CONSTRUCT NEW SEPTIC SYSTEM(S)
- REPAIR/ADD TO AN EXISTING SEPTIC SYSTEM
- REPLACE AN EXISTING SEPTIC SYSTEM

- NEW STRUCTURE(S)
- ADDITION TO AN EXISTING STRUCTURE
- REPLACE AN EXISTING STRUCTURE

CHECK ONE:

IS THE PROPERTY WITHIN 2500' OF ANY RESERVOIR?

- CREATE NEW LOT(S)
- BUILD ON AN EXISTING LOT IN A SUBDIVISION
- BUILD ON AN EXISTING PARCEL OF RECORD

- YES
- NO

THE TYPE OF STRUCTURE IS:

- RESIDENTIAL WITH 6 PROPOSED BEDROOMS IN THE COMPLETED STRUCTURE (NOTE **UNKNOWN** IF APPROPRIATE)
- COMMERCIAL (PROVIDE DETAIL OF NUMBERS AND TYPES OF EMPLOYEES/ CUSTOMERS ON ACCOMPANYING PLAN)
- INSTITUTIONAL/GOVERNMENT (PROVIDE DETAIL OF NUMBERS AND TYPES OF EMPLOYEES/USERS ON ACCOMPANYING PLAN)

PROPERTY OWNER(S) Noon-Hwa Chen

JAYTIME PHONE _____ CELL _____ FAX _____

MAILING ADDRESS 8364 Reservoir Rd Fulton MD
STREET CITY/TOWN STATE ZIP

APPLICANT J.M. Contracting LLC / Rennie Heaps

JAYTIME PHONE 443-277-7526 CELL SAME FAX 410 552 5815

MAILING ADDRESS 425 O'Brecht Rd Sykesville MD 21784
STREET CITY/TOWN STATE ZIP

APPLICANT'S ROLE: DEVELOPER BUILDER BUYER RELATIVE/FRIEND REALTOR CONSULTANT

PROPERTY LOCATION SUBDIVISION/PROPERTY NAME _____ LOT NO. _____

PROPERTY ADDRESS 8364 Reservoir Rd Fulton MD
STREET TOWN/POST OFFICE

AX MAP PAGE(S) _____ GRID _____ PARCEL(S) _____ PROPOSED LOT SIZE _____



AS APPLICANT, I UNDERSTAND THE FOLLOWING: THE SYSTEM INSTALLED SUBSEQUENT TO THIS APPLICATION IS ACCEPTABLE ONLY UNTIL PUBLIC SEWERAGE IS AVAILABLE. THIS APPLICATION IS COMPLETE WHEN ALL APPLICABLE FEES AND A SUITABLE SITE PLAN HAVE BEEN RECEIVED. I ACCEPT THE RESPONSIBILITY FOR COMPLIANCE WITH ALL M.O.S.H.A. AND "MISS UTILITY" REQUIREMENTS. APPROVAL IS BASED UPON SATISFACTORY REVIEW OF A PERC CERTIFICATION PLAN.

TEST RESULTS WILL BE MAILED TO APPLICANT. R. E. M.
SIGNATURE OF APPLICANT

HOWARD COUNTY HEALTH DEPARTMENT, BUREAU OF ENVIRONMENTAL HEALTH, WELL AND SEPTIC PROGRAM
7178 COLUMBIA GATEWAY DRIVE COLUMBIA, MARYLAND 21046 (410) 313-1771 FAX (410) 313-2648
TDD (410) 313-2323 TOLL FREE 1-877-4MD-DHMH

Reservoir Rd

A/P

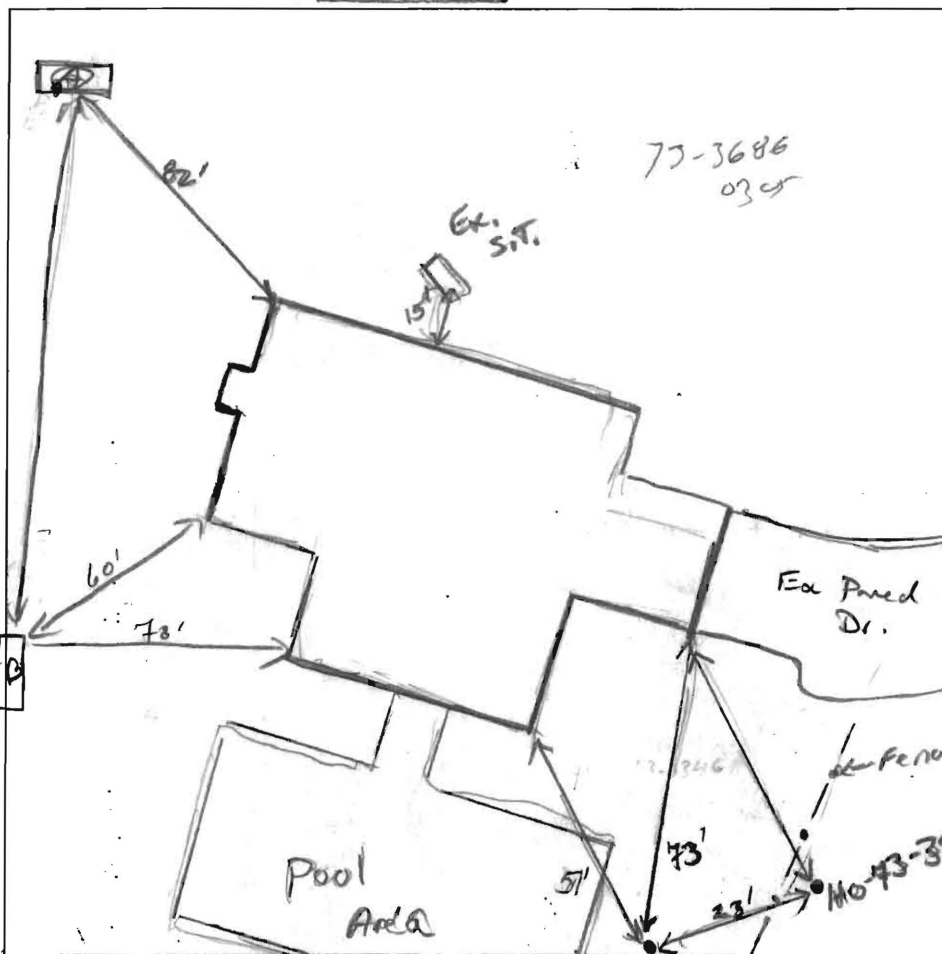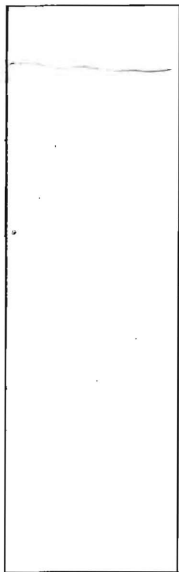

(A)

6" Top soil SBK many roots

3' Br/Red CL, CW, coarse SBK common mica, many roots

5' Br/Red/orange loam w/ thick platy 5% mica schist Frabb

Br/orange SL, Friable medium platy structure throughout Dense, CR Highly micaceous

16'

(B)

8" Top soil, SBK many roots

10YR 4/4 SCL, mSBK, Friable, Dry CW, highly micaceous

5.6' Br/Red yellow SL, Friable many fine roots, many mica

medium fine but w/ platy structure from 5% shwd chnd very friable, highly micaceous

16.5'

DATE	TEST #	DEPTH	START	BREAK 1" DROP	STOP 2" DROP	TIME OF 2nd INCH	P/F/H
4/14/10	(A)	5'4" / 16'	11:23	11:40	pulled. moment	3/4"	
		8.5'	11:50	pulled. in 20 mins	2" moment		
	(B)	6' / 15.5"	12:56	1:01	1:07	6	(P)

Ex. well not being utilized must be sealed.

REMARKS Hole (A) failed in low area of yard.

SANITARIAN H. Wolf BACKHOE Ronnie Hays OTHERS Home owner / weekly.

TEST HOLES USED IN SDA 1 AVG. PERC TIME 6 SQ. FT/BR

TRENCH WIDTH 2 INLET DEPTH Shallow as possible MAX. BOT DEPTH 11 EFFECTIVE SW 4'

$$150(6) = \frac{900}{40} = 100 \div 2 = 430(.40) = 180 \text{ LF}$$

FOGLES WELL DRILLING, LLC
P.O. BOX 202
WOODBINE, MD 21797
(443)609-4195

April 16, 2010

Howard County Health Department
7178 Columbia Gateway Dr.
Columbia, Md. 21046

Re: 8364 Reservoir Rd.
Fulton, Md. 20759

To whom it may concern:

Please be advised that Fogles Well Drilling, LLC did not abandon the well located at 8364 Reservoir Rd. in Fulton Maryland. Fogles did however do a site visit and after measuring down 6' from the top of the well casing we hit concrete. Fogles feel this well has been abandon.

If Fogles can be of any further assistance, please do not hesitate to contact the office.

Sincerely,



Allen Compton
AJC/tlm

APR 16 2010