

9/18/00 Repair
9/18/00 9:30 Uncover
Covered
Work

INDEXED

PERMIT
SEWAGE DISPOSAL SYSTEM
HOWARD COUNTY HEALTH DEPARTMENT
BUREAU OF ENVIRONMENTAL HEALTH
410-313-2640

P 514238
A REPAIR
ISSUE DATE 9/8/00
APPROVAL DATE 9/18/00

Jenkins Brothers IS PERMITTED TO INSTALL ALTER

ADDRESS 7670 Smith's Private Road, Sykesville, MD 21784 PHONE 410-461-9282

SUBDIVISION _____ LOT NUMBER _____ ADDRESS 12118 Frederick Road

PROPERTY OWNER Shifflet-Deitz PROPERTY OWNER'S ADDRESS 12118 Frederick Road

SEPTIC TANK CAPACITY 1000-1250 GALLONS

PUMP CHAMBER CAPACITY — GALLONS

NUMBER OF BEDROOMS 2 3 BR Add'n pending

SQUARE FEET PER BEDROOM 125

LINEAR FEET OF TRENCH REQUIRED 125

TRENCHES: Trenches to be 2 feet wide. Inlet 3 feet below original grade. Bottom maximum depth

8 feet below original grade. 5 feet of stone below distribution box.

LOCATION: _____

REPAIR - PURPOSE - Existing septic system has failed.

Call for inspection when ground is opened so sanitarian can recommend repair. 01-24-2000
OK/MR

PLANS APPROVED _____ DATE _____

PERMIT VOID AFTER 2 YEARS

NOTE: CONTRACTOR RESPONSIBLE FOR SCHEDULING A PRE-CONSTRUCTION INSPECTION FOR ALL INSTALLATIONS

NOTE: TOP OF SEPTIC TANKS ARE TO BE NO DEEPER THAN 3.0 FEET BELOW FINISH GRADE

NOTE: WATERTIGHT SEPTIC TANKS REQUIRED

NOTE: CLEANOUT REQUIRED EVERY 70 FEET OF SEWER LINE AND/OR AT 90° SWEEPS IN LINES FROM HOUSE TO DRAIN FIELDS, 90° ELBOWS ARE NOT ACCEPTABLE

NOTE: ALL PARTS OF SEPTIC SYSTEMS (I.E. TANK, DISTRIBUTION BOX, DRAINFIELDS) TO BE 100 FEET FROM ANY WATER WELL UNLESS OTHERWISE SPECIFICALLY AUTHORIZED

NOTE: NO ABSORPTION TRENCH TO EXCEED 100 FEET IN LENGTH UNLESS SPECIFICALLY AUTHORIZED

NOTE: ALL PIPE FROM HOUSE TO SEPTIC TANK MUST BE CAST IRON OR SCHEDULE 35/40 PVC OR ABS

NOTE: MANHOLE RISERS REQUIRED ON ALL SEPTIC TANKS AND PUMP CHAMBERS


NOTE: DISTRIBUTION BOXES MUST HAVE BAFFLES

NOTE: IF PUMPED SEPTIC SYSTEM REQUIRED, (1) SEPTIC PUMP DETAIL TO BE PROVIDED BY INSTALLER PRIOR TO ISSUANCE OF SEPTIC PERMIT (2) PUMP PERFORMANCE TEST IS NECESSARY PRIOR TO HEALTH DEPARTMENT APPROVAL OF SEPTIC PERMIT

NEITHER THE HOWARD COUNTY COUNCIL NOR THE HEALTH DEPARTMENT IS RESPONSIBLE FOR THE SUCCESSFUL OPERATION OF ANY SYSTEM
PERMITTEE RESPONSIBLE FOR OBTAINING FINAL APPROVAL ON THIS PERMIT
CALL 410-313-2640 FOR INSPECTION OF SEPTIC SYSTEM

P 514238

NOT TO SCALE

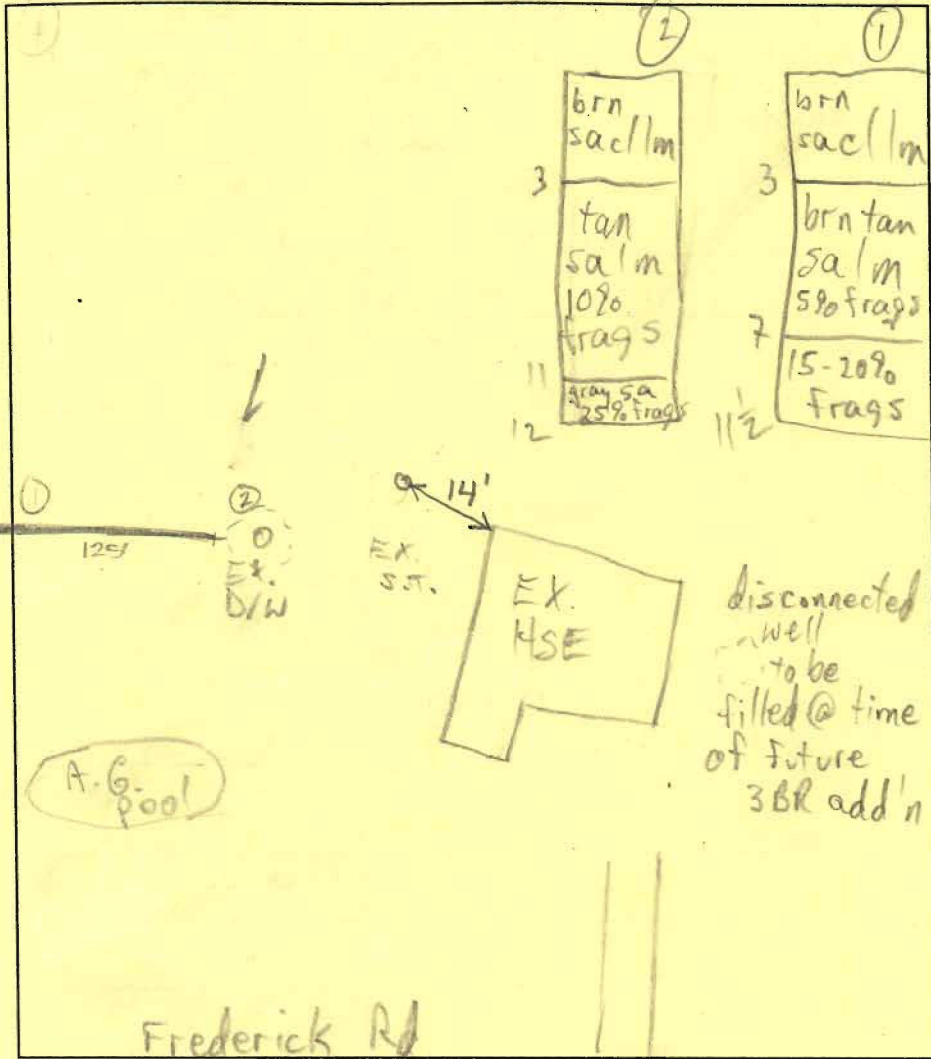

TRENCH DATA

TRENCH WIDTH 2

TRENCH INLET DEPTH 3

TRENCH BOTTOM DEPTH 8

DEPTH OF STONE 9

NUMBER OF TRENCHES 1

TOTAL TRENCH LENGTH 125

ABSORBENT AREA 625

DISTRIBUTION BOX LEVEL N/A

BAFFLE IN DISTRIBUTION BOX N/A

SEPTIC TANK DATA

SEPTIC TANK existing GALLONS

MANHOLE RISER _____

6 INCH INSPECTION PORT _____

PUMP CHAMBER DATA

PUMP CHAMBER GALLONS _____

MANHOLE RISER _____

ALARM _____

PUMP PERFORMANCE TEST _____

PRE-CONSTRUCTION INSPECTION: 9/8/00 #1 OK TO START

INSPECTION COMMENTS: 9/8/00 4:20± SYSTEM COVERED; JENKINS REPORTS #0E MAN (RONNIE) WAS TO LEAVE SYSTEM OPEN; I ADVISED JENKINS SYSTEM NOT APPROVED UNTIL FURTHER NOTICE & SYS. EXCAVATED; HE AGREED (MP)

9/18/00 contractor opened ends of trench - reports installing above specified trench. OK to cover. DIC

INSPECTOR DIC DATE SYSTEM APPROVED COVERED 9/18/00