

10/9/01 Move Septic Tank 1PM  
Abandon Part of Trenches  
Dig Test Hole Closer to House

ISSUE DATE: 8/22/01

# PERMIT

P 515996-C

APPROVAL DATE: 10/9/01

A REPAIR

INDEXED

## ON-SITE SEWAGE DISPOSAL SYSTEM HOWARD COUNTY HEALTH DEPARTMENT BUREAU OF ENVIRONMENTAL HEALTH

**05-413079**

Jack Fyock Septic Service IS PERMITTED TO INSTALL  ALTER

ADDRESS: P.O. Box 89, Glenelg, MD 21737 PHONE NUMBER: 410-988-9270

SUBDIVISION: St. Louis Park LOT NUMBER: 1

ADDRESS: 12620 Route 108 PROPERTY OWNER: Kirit Parmar

SEPTIC TANK CAPACITY (GALLONS): 1500

PUMP CHAMBER CAPACITY (GALLONS): N/A

NUMBER OF BEDROOMS: 3

SQUARE FEET PER BEDROOM: \_\_\_\_\_

LINEAR FEET OF TRENCH REQUIRED: \_\_\_\_\_

TRENCHES:	Trench to be _____ feet wide. Inlet _____ feet below original grade. Bottom maximum depth _____ feet below original grade. Effective area begins at _____ feet below original grade. _____ feet of stone below distribution pipe.
LOCATION:	
PURPOSE:	Proposed addition requires relocation of existing septic tank and partial abandonment of existing trenches. <u>One percolation test hole is to be dug closer to house to further verify that there is remaining repair area before any work is started.</u>

PLANS APPROVED: Brian Baker DATE: 9/27/01

- NOTE: PERMIT VOID AFTER 2 YEARS
- NOTE: CONTRACTOR RESPONSIBLE FOR SCHEDULING A PRE-CONSTRUCTION INSPECTION FOR ALL INSTALLATIONS
- NOTE: WATERTIGHT SEPTIC TANKS REQUIRED
- NOTE: ALL PARTS OF SEPTIC SYSTEM SHALL BE 100 FEET FROM ANY WATER WELL
- NOTE: MANHOLE RISERS REQUIRED ON ALL SEPTIC TANKS AND PUMP CHAMBERS

**NEITHER THE HOWARD COUNTY COUNCIL NOR THE HEALTH DEPARTMENT IS RESPONSIBLE FOR THE SUCCESSFUL OPERATION OF ANY SYSTEM PERMITTEE RESPONSIBLE FOR OBTAINING FINAL APPROVAL ON THIS PERMIT CALL 410-313-2640 FOR INSPECTION OF SEPTIC SYSTEM**


~~SEE PERMIT NUMBER~~  
~~AND REVISIONS~~ 2/11/2002  
800133759  
GARAGE - NEW KITCHEN  
5-2704 BOD14861 - 3 DENTAL CHAIRS - permit cancelled  
9-14-05 BOD156069 - EXPAND WAITING AREA check Rumba

P 515996-C

①

4' Red Br CI  
Loam  
10.5' Light Br  
Sd Loam  
~10% Rock  
12' Pockets of  
~40% Rock  
Getting Rocks

NOT TO SCALE

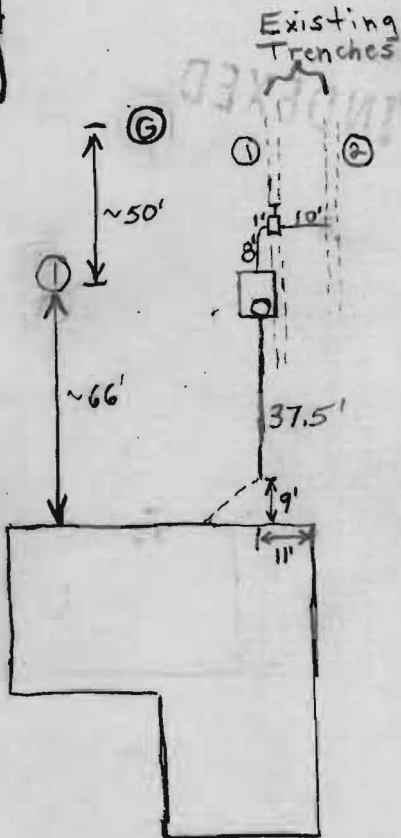

HO-88-2044

Rt. 108

PRE-CONSTRUCTION INSPECTION:

TRENCH DATA

Existing

TRENCH WIDTH \_\_\_\_\_  
 TRENCH INLET DEPTH \_\_\_\_\_  
 TRENCH BOTTOM DEPTH \_\_\_\_\_  
 DEPTH OF STONE \_\_\_\_\_  
 NUMBER OF TRENCHES 2  
 TOTAL TRENCH LENGTH \_\_\_\_\_  
 ABSORBENT AREA \_\_\_\_\_  
 DISTRIBUTION BOX LEVEL Yes  
 BAFFLE IN DISTRIBUTION BOX \_\_\_\_\_

SEPTIC TANK DATA

SEPTIC TANK 1500 TS GALLONS  
 MANHOLE RISER Yes  
 6 INCH INSPECTION PORT No

PUMP CHAMBER DATA

N/A

~~PUMP CHAMBER GALLONS \_\_\_\_\_  
 MANHOLE RISER \_\_\_\_\_  
 ALARM \_\_\_\_\_  
 PUMP PERFORMANCE TEST \_\_\_\_\_~~

INSPECTION COMMENTS: 10/9/01 Approximately 30' abandoned on trench ①. Approximately 15' abandoned on trench ②. So around 150' of trench should be remaining. Which leaves enough for a 3 bedroom house considering that there is reported to be 3'-4' of stone in existing trenches. There is sufficient space remaining for 1 repair in area of pipe test holes ① and ②. (BB)

INSPECTOR B. Baker

DATE SYSTEM APPROVED 10/9/01