

7178 Columbia Gateway Drive, Columbia, MD 21046
(410) 313-1771 Fax (410) 313-2648
TDD (410) 313-2323 Toll Free 1-866-313-6300
website: www.hchealth.org

Penny E. Borenstein, M.D., M.P.H., Health Officer

August 21, 2008

Dorsey Family Homes
10717-B Brimingham Way
Woodstock, MD 21163

SENT VIA FACSIMILE 410-465-0488

RE: Frederick Overlook, Lot 1
12118 Frederick Road
Ellicott City, MD 21042
BP# B07001933
PUBLIC WATER

Dear Sir/Madam:

This is to advise you that the septic system for the above referenced property has been installed and inspected. **Final approval of the septic system was granted on 08/19/2006.**

The property is served by public water and is therefore exempt from the Health Department water sampling requirements.

By issuance of this letter, this office recommends release of the Use and Occupancy permit for the referenced property.

Approving Authority,

Stuart F. Oster, R. S.
Well & Septic Program

cc: Building Inspector's Office
File

MARYLAND DEPARTMENT OF THE ENVIRONMENT, WATER MANAGEMENT ADMINISTRATION
1800 Washington Blvd., Baltimore, Maryland 21230 (410) 537-3784

WATER WELL ABANDONMENT-SEALING REPORT FORM

SUBMIT COPIES OF COMPLETED FORM TO:

- COUNTY ENVIRONMENT AGENCY (contact MDE, WMA if address needed)
- WELL OWNER
- MDE, WATER MANAGEMENT ADMINISTRATION, WELL PROGRAM

DATE WELL ABANDONED: Aug 15 2007 (month/day/year)

PERMIT NUMBER OF ABANDONED WELL (if any) N/A


PERMIT NUMBER OF REPLACEMENT WELL N/A

PERSON ABANDONING WELL: Ralph E. Maynes

WELL DRILLERS LICENSE NUMBER: 117
CIRCLE: MWD (MSD) MGD

OWNER'S NAME: DORSEY FAMILY HOMES

WELL LOCATION:
 COUNTY: Howard
 NEAREST TOWN: WEST FRIENDSHIP
 TAX MAP: _____ BLOCK _____ PARCEL _____
 SUBDIVISION: FREDERICK OWEN COOK
 SECTION: _____ LOT: I
 NEAREST ROAD: MD Rt. 144

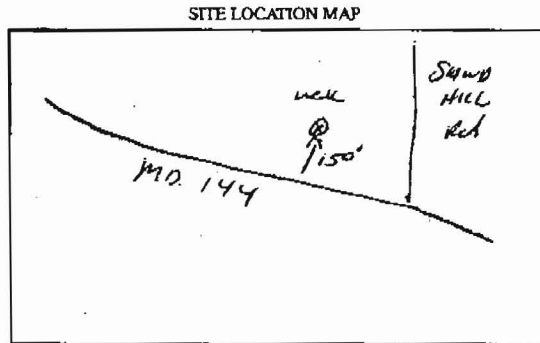

TYPE OF WELL BEING ABANDONED:

- DRILLED
- BORED/AUGERED
- OTHER (specify) _____
- JETTED
- HAND DUG

USE CODE:

- DOMESTIC
- IRRIGATION
- TEST/OBSERVATION
- MUNICIPAL/PUBLIC
- INDUSTRIAL
- GEOTHERMAL

TYPE OF CASING:

- STEEL
- CONCRETE
- PLASTIC
- OTHER (specify) _____

SIZE OF CASING: 6" INCHES IN DIAMETER

DEPTH OF WELL: 90 FEET DEEP

WAS ANY CASING REMOVED? YES NO
If yes, length removed, in feet: _____

WAS CASING RIPPED OR PERFORATED? YES NO

LOG OF SEALING MATERIAL

MATERIAL	FEET	
	FROM	TO
Cement	90	3
Top Soil	3	0
VOLUME OF MATERIAL USED		
20 Bags		