

APPLICATION

A 17835

P _____

SEWAGE DISPOSAL TESTING

STATE OF MARYLAND - DEPARTMENT OF HEALTH AND MENTAL HYGIENE

HOWARD COUNTY HEALTH DEPARTMENT
ENVIRONMENTAL HEALTH SERVICES

P. O. BOX 476, ELLICOTT CITY, MARYLAND 21043
TELEPHONE: 465-5000, EXT. 356

Septic Tank - 3 bedrooms
1000961
DISTRICT 4th
-1250961
DATE 12/29/72

Dry Well - 100 sq ft of absorbent sidewall area per bedroom to begin below the first 6ft of non porous soil. Maximum depth permitted for dry well is 13 ft. Locate dry well 20 ft from front property line and 12 ft from left side line as seen from Rt. 108.

TO: THE COUNTY HEALTH OFFICER
ELLICOTT CITY, MARYLAND

I, HEREBY, APPLY FOR THE NECESSARY TEST IN ORDER TO CONSTRUCT (OR RECONSTRUCT) A SEWAGE DISPOSAL SYSTEM.

PROPERTY OWNER John T. Swann

ADDRESS Route 108, Box 13015, Highland, Md. 20777 PHONE 286-3545

PROPERTY LOCATION:

SUBDIVISION _____ LOT NO. _____

ROAD AND DESCRIPTION Route 108 - 1 mile north of Highland - east side of Route 108

SIZE OF LOT 74.22 acres TYPE BLDG. 3 or 4 bedrooms
NUMBER OF BEDROOMS

IF NOT SINGLE RESIDENCE DESCRIBE _____

THE SYSTEM INSTALLED UNDER THIS APPLICATION IS ACCEPTABLE ONLY UNTIL PUBLIC FACILITIES BECOME AVAILABLE.

SIGNATURE OF APPLICANT /s/ William L. Swann


APPROVED BY Robert V. Toner FOR Dry Well DATE 1/29/73
(KIND OF SYSTEM)

REJECTED BY _____ FOR _____ DATE _____
(KIND OF SYSTEM)

HOLD PENDING FURTHER TESTS _____ DATE _____

REASONS FOR REJECTION OR HOLDING _____

THIS IS NOT A PERMIT

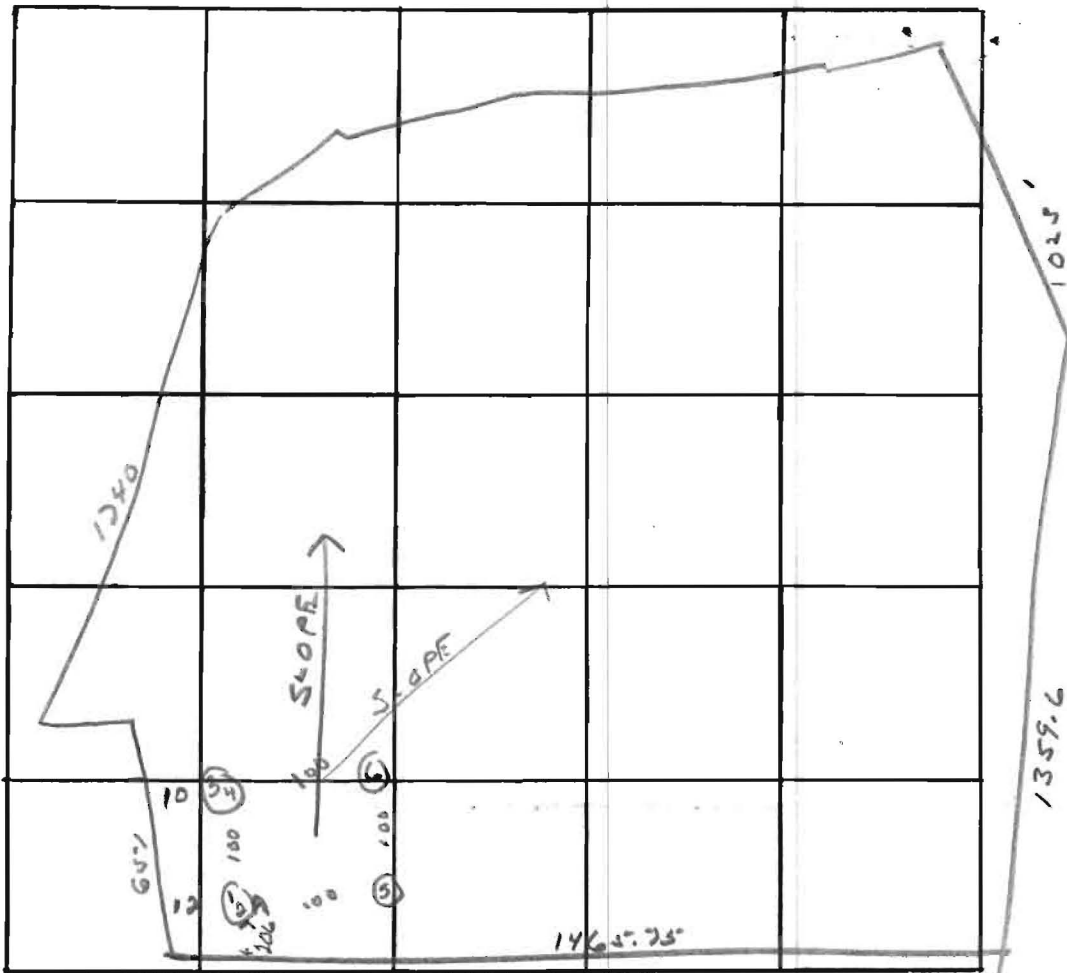

INDICATE NORTH. - NAME ADJOINING ROADWAY AS BASE LINE.
HIGHLAND Rd.

DATE	TEST NO.	DEPTH	PRE-WET		TEST - 1" DROP		TIME
			START	STOP	START	STOP	
1/26/73	1	12 ft.	9 ⁴¹	9 ⁴³	9 ⁴³	9 ⁴⁶	3 min
	2	4 ft.	9 ⁴²	Slow Pen			
	3	11 1/2 ft.	9 ⁵⁰	9 ⁵²	9 ⁵²	9 ⁵⁶	4 min
	4	4 ft.	9 ⁵³	Slow Pen			
	5	13 ft.	Saturated - clay pen		5 1/2 ft.		
	6	11 1/2 ft.	Water Table - hard soil pen		4 1/2 ft.		
	2A	6 1/2 ft.	10 ⁰⁷	10 ¹³	10 ¹³	10 ²⁴	11 min
	4A	6 1/2 ft.	10 ¹⁶	10 ²³	10 ²³	10 ³²	9 min

REMARKS System in 142 sealed at 6 ft.

TYPE OF SOIL _____

TESTED BY R. Torre ALSO PRESENT: _____

