

later called
lot 2 ("")
"D" 1.000 owned
Riley house

Photofile


~~Plot~~ see attached plat for location of plots

DATE	TEST NO.	DEPTH	PRE-WET		TEST - 1" GSC		TIME
			START	STOP	START	STOP	
7/18/74	1	13 1/2	247	250	250	256	6
	2	6 1/2	249	250	250	251	1
	3	7	257	258	258	307	2
	4	13	NOT TESTED				
			SOFT SAND				
	5	7 1/2	303	314	314	327	13
	6	11	TOP 8 FT CLAY MID 7 FT SAND		BOT 1 FT ROCK DRY		
	7	5	312	316	316	320	4
	8	9	TOP 8 FT SANDY		BOT 1 FT ROCK DRY		
	9	7	330	331	331	334	3
	10	14	331	356	1st and 2nd 250mm		

Riley

REMARKS _____
TYPE OF SOIL sandy loam

20307

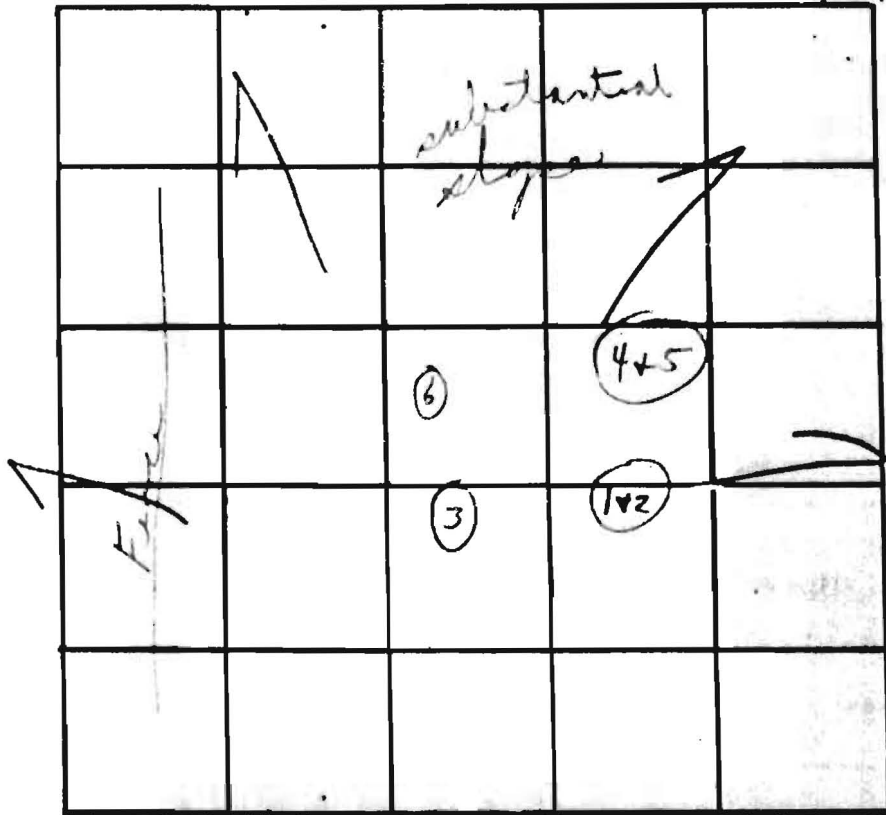

INDICATE NORTH - NAME ADJACENT ROADWAY AS BASE LINE.

20108

DATE	TEST NO.	DEPTH	PRE-WET		TEST - 1" DROP		TIME	
			START	STOP	START	STOP		
6/1/73	1	3'	11:02	11:05	11:05	11:07	4 min	
	2	10'	11:02	11:04	11:04	11:08	4 min	
	3	9'	Visual similar to 1+2					
	4	2'	11:10	11:13	11:13	11:18	5 min	
	5	11'	11:10	11:12	11:12	11:15	3 min	
	6	8'	Visual similar to 4+5					
						4:16	4 min	

Some work 4 min

REMARKS Hold certain holes + lots
 TYPE OF SOIL Moss Holes placed in open field
& High grass