

4/14/72
9:30

4/14/72
Final OK
R. Town

File

INDEXED

PERMIT

P 16914

SEWAGE DISPOSAL SYSTEM

A

MARYLAND STATE DEPARTMENT OF HEALTH

HOWARD COUNTY

ELLICOTT CITY

DISTRICT 5

DATE 4/14/72

Jack Fyock IS PERMITTED TO INSTALL ALTER X

ADDRESS Ten Oaks Road, Glenside, Md. PHONE 286-2939

A SEWAGE DISPOSAL SYSTEM LOCATED AT

SUBDIVISION ROAD 12045 Route 216 - 2nd LOT Par- 316
Map- 41

PROPERTY OWNER Edward Mullinix house past Pindell School Road going toward Highland

ADDRESS

SPECIFICATIONS

DRAIN FIELD DEPTH FEET, BOTTOM AREA SQ. FT.

SEEPAGE PITS ABSORBENT SIDE-WALL AREA SQ. FT.

SEPTIC TANK CAPACITY GALLONS

FOR GARDAGE GRINDER, INCREASE DISPOSAL AREA 22% & TANK CAPACITY 80%

OTHER REPAIR - Call for inspection when ground is opened up and Sanitarian will recommend repair system.


LOG PERMIT SIGNED
AND RETURNED 1/15/90
BPT 3500
3529/100
104/100

PLANS APPROVED BY Palmer E. Wine DATE 4/14/72

FILL SEPTIC TANK AND DISTRIBUTION BOX WITH WATER BEFORE CALLING FOR A.I. INSPECTION. COVER NO WORK UNTIL INSPECTED AND APPROVED.

NEITHER THE HOWARD COUNTY COMMISSIONERS NOR THE HEALTH DEPARTMENT IS RESPONSIBLE FOR THE SUCCESSFUL OPERATION OF ANY SYSTEM.

1691

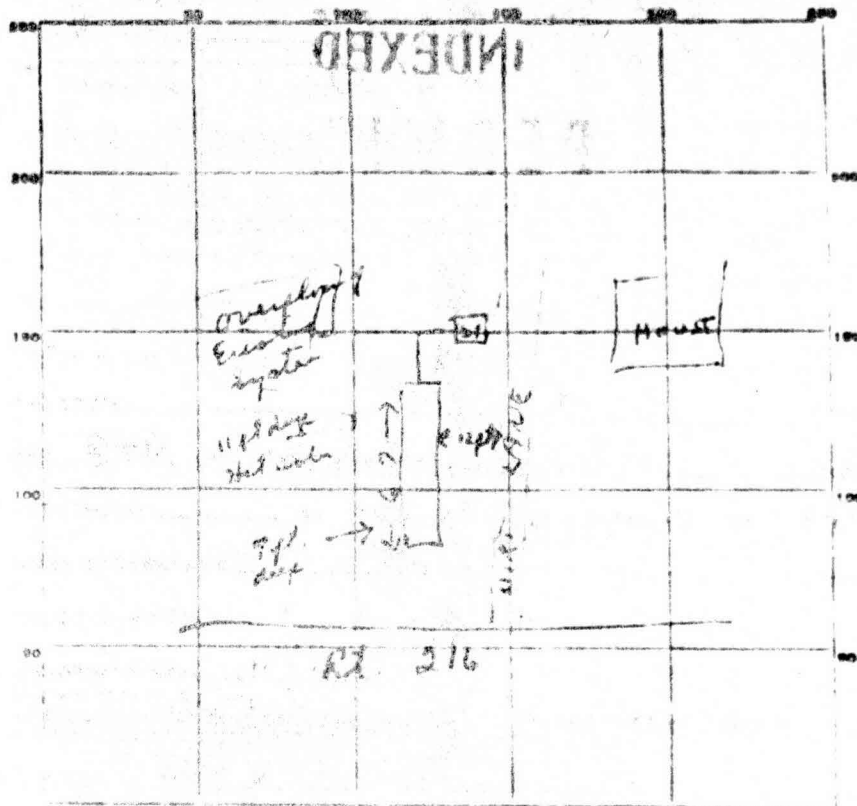

67 1/2
 184
 32
 127
 167
 334

PERMIT CARD _____

SEPTIC TANK, LEVEL _____

CLEANOUTS _____

DISTRIBUTION BOX, LEVEL _____

TILE FIELD, DEPTH 8-11 FT. TRENCH WIDTH 1 1/2 FT.

GRAVEL DEPTH _____ IN. TOTAL LENGTH 67 FT.

NUMBER OF TRENCHES _____

effective riser well

total bottom area

334 sq ft

SEEPAGE PITS, INSIDE DIAMETER _____ FT. DEPTH BELOW INLET _____ FT.

ABSORBENT AREA _____ SQ. FT.

REMARKS

4/14/76 - Hot water at 11 ft. Riser system to 7 ft.
 Clay for 5-6 ft.


DATE SYSTEM APPROVED

4/14/76

INSPECTOR

Robert Tom

J. Dentler Jr.
124/321

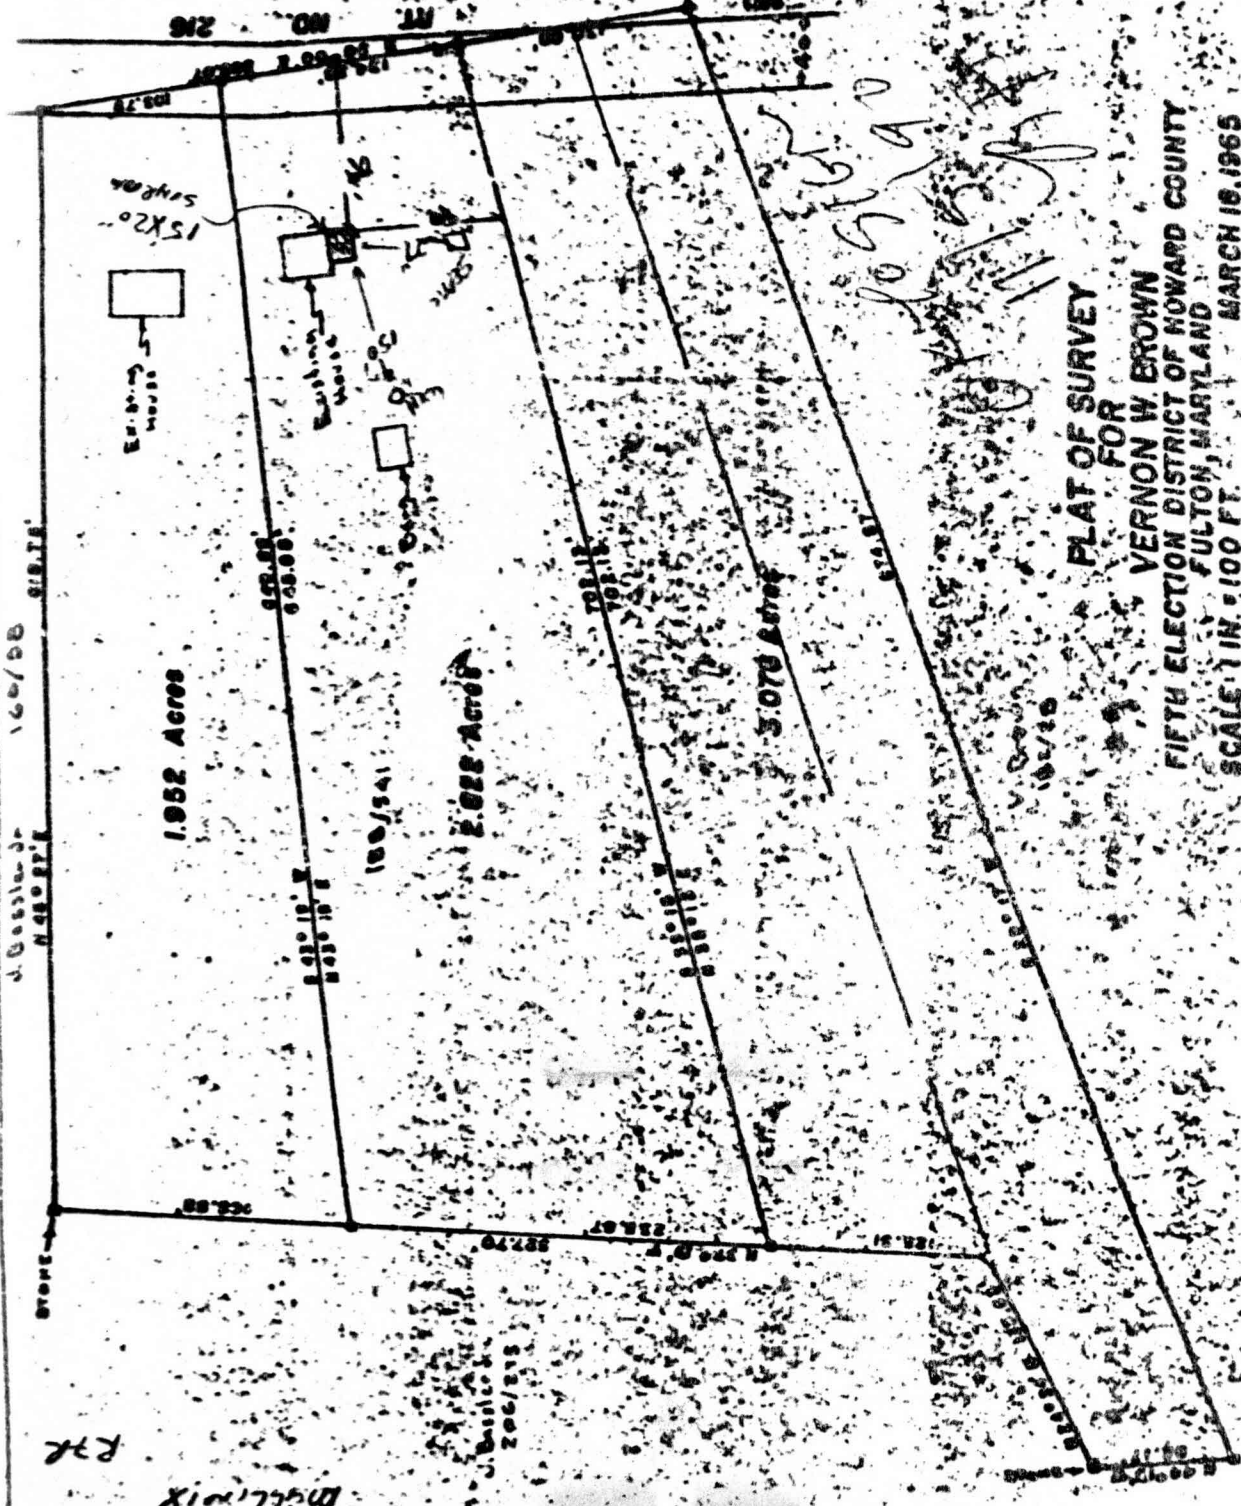

PLAT OF SURVEY
 FOR
 VERNON W. BROWN
 FIFTH ELECTION DISTRICT OF HOWARD COUNTY
 FULTON, MARYLAND
 MARCH 18, 1965
 SCALE 1 IN. = 100 FT.

Charles M. Brown

R22

District