

9/11/01 Layout 10:30-11:00
9/12/01 CB, PM
1/13/01 1:30-2:00

ISSUE DATE: 8/31/2001

APPROVAL DATE: 10/5/01

PERMIT INDEXED

P 516011-B

A 512694-DD

ON-SITE SEWAGE DISPOSAL SYSTEM HOWARD COUNTY HEALTH DEPARTMENT BUREAU OF ENVIRONMENTAL HEALTH

03-330893

South Carroll Backhoe, Inc IS PERMITTED TO INSTALL ALTER

ADDRESS: 4410 Salem Bottom Road, Westminster PHONE NUMBER: 410-875-4197

SUBDIVISION: Brantwood 2/1 LOT NUMBER: 28

ADDRESS: 3008 Seneca Chief Trail PROPERTY OWNER: NV Homes

SEPTIC TANK CAPACITY (GALLONS): 1250

PUMP CHAMBER CAPACITY (GALLONS): N/A

NUMBER OF BEDROOMS: 3

SQUARE FEET PER BEDROOM: 180

LINEAR FEET OF TRENCH REQUIRED: 240

TRENCHES:	Trench to be 3.0 feet wide. Inlet 2.0 feet below original grade. Bottom maximum depth 4.0 feet below original grade. Effective area begins at 2.0 feet below original grade. 2.0 feet of stone below distribution pipe.
LOCATION:	Begin trenches 90 feet off the rear lot line and 100 feet off the left lot line as seen when facing the front of the house. Run trenches on contour toward the rear of the lot.
NOTES:	

PLANS APPROVED: Amy Mc Millen 6/5/01 OK (BB) DATE: 6-1-01


- NOTE: PERMIT VOID AFTER 2 YEARS
- NOTE: CONTRACTOR RESPONSIBLE FOR SCHEDULING A PRE-CONSTRUCTION INSPECTION FOR ALL INSTALLATIONS
- NOTE: WATERTIGHT SEPTIC TANKS REQUIRED
- NOTE: ALL PARTS OF SEPTIC SYSTEM SHALL BE 100 FEET FROM ANY WATER WELL
- NOTE: MANHOLE RISERS REQUIRED ON ALL SEPTIC TANKS AND PUMP CHAMBERS

NEITHER THE HOWARD COUNTY COUNCIL NOR THE HEALTH DEPARTMENT IS RESPONSIBLE FOR THE SUCCESSFUL OPERATION OF ANY SYSTEM PERMITTEE RESPONSIBLE FOR OBTAINING FINAL APPROVAL ON THIS PERMIT CALL 410-313-2640 FOR INSPECTION OF SEPTIC SYSTEM

**BUILDING PERMIT SIGNED
AND RETURNED 5-8-02
B00136013-2 Level Deck**

P516011-B

NOT TO SCALE

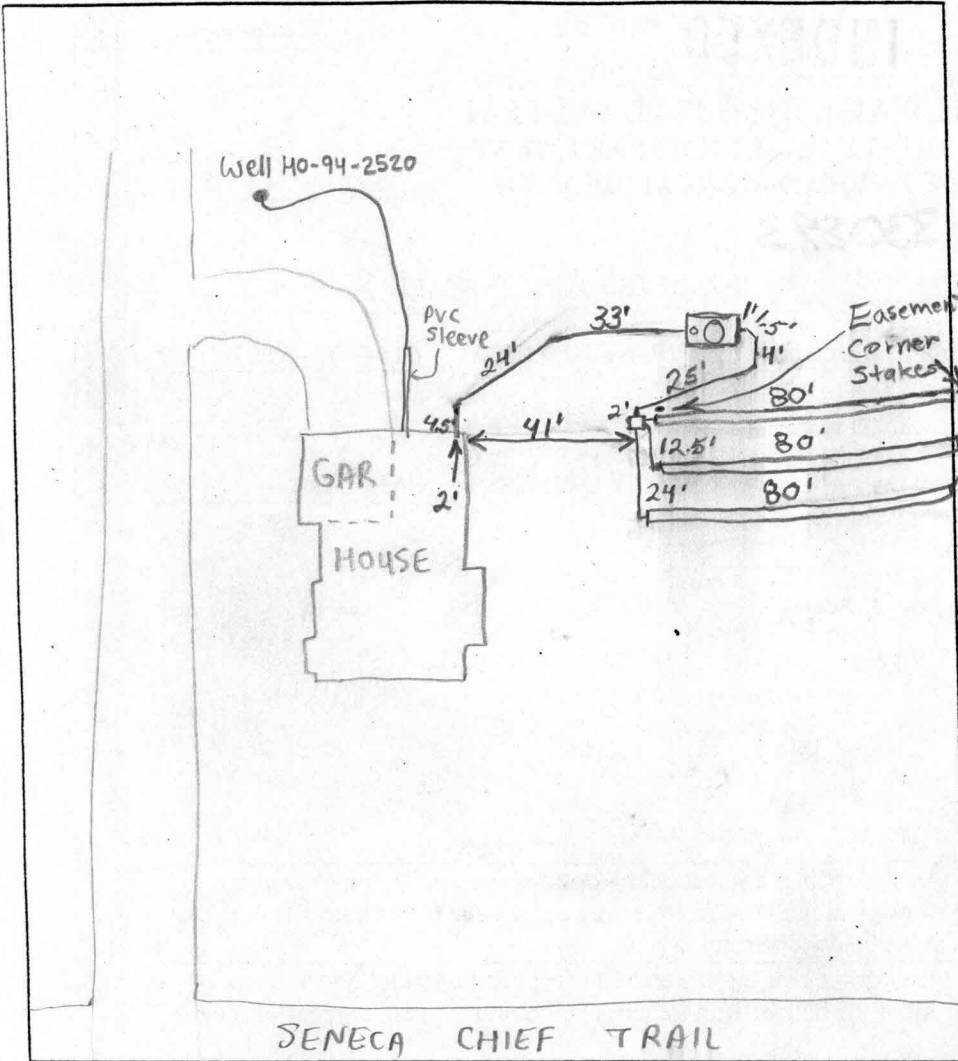

TRENCH DATA

TRENCH WIDTH 3'
 TRENCH INLET DEPTH 2'
 TRENCH BOTTOM DEPTH 4'
 DEPTH OF STONE 2'
 NUMBER OF TRENCHES 3
 TOTAL TRENCH LENGTH 240'
 ABSORBENT AREA 720 sq ft
 DISTRIBUTION BOX LEVEL Yes
 BAFFLE IN DISTRIBUTION BOX Yes

SEPTIC TANK DATA

SEPTIC TANK 1250 TS GALLONS
 MANHOLE RISER Yes
 6 INCH INSPECTION PORT Yes

PUMP CHAMBER DATA

~~PUMP CHAMBER GALLONS _____
 MANHOLE RISER _____
 ALARM _____
 PUMP PERFORMANCE TEST _____~~ N/A

PRE-CONSTRUCTION INSPECTION: 9/11/01 To install as per B.P. Tank
relocated because of neighboring well. (BB)
 INSPECTION COMMENTS: 9/12/01 First trench done. Second trench
started. Need house connection. (BB) 9/13/01 Need house
connection. O.K. to cover. (BB) 10/5/01- HOUSE CONN. VERIFIED TO HAVE
BEEN MADE THRU T/C W/ BUILDER. (SRK)

INSPECTOR Steven R. Krieg

DATE SYSTEM APPROVED 10/5/01

