

# APPLICATION

PERCOLATION TESTING

A \_\_\_\_\_

P \_\_\_\_\_

HOWARD COUNTY HEALTH DEPARTMENT  
BUREAU OF ENVIRONMENTAL HEALTH  
3525-H ELLICOTT MILLS DRIVE/ELLICOTT CITY, MARYLAND 21043  
TELEPHONE: 313-2640

DISTRICT \_\_\_\_\_

DATE 3/9/98

TO: THE COUNTY HEALTH OFFICER  
ELLICOTT CITY, MARYLAND

I HEREBY APPLY FOR THE NECESSARY TEST PRIOR TO APPLICATION FOR PERMIT TO CONSTRUCT (OR RECONSTRUCT) A SEWAGE DISPOSAL SYSTEM.

PROPERTY OWNER \_\_\_\_\_

ADDRESS \_\_\_\_\_ PHONE \_\_\_\_\_

AGENT OR PROSPECTIVE BUYER WINCHESTER HOMES INC. c/o Mr. KEITH KUBISTA

ADDRESS 6305 IVY LANE SUITE 800 PHONE (301) 489-1120  
GREENBELT MD. 20770

PROPERTY LOCATION:

SUBDIVISION MOBBERLY PROPERTY LOT NO. 4

ROAD AND DESCRIPTION BURNT WOODS ROAD

TAX MAP 22 PARCEL # 141, 2, 234 & 530

SIZE OF LOT 1 AC. CLUSTER TYPE BLDG. S.F.D.  
(SINGLE FAMILY DWELLING OR COMMERCIAL)

THE SYSTEM INSTALLED UNDER THIS APPLICATION IS ACCEPTABLE ONLY UNTIL PUBLIC FACILITIES BECOME AVAILABLE. I FULLY UNDERSTAND THE FEE CONNECTED WITH THE FILING OF THIS PERC TEST APPLICATION IS NON-REFUNDABLE UNDER ANY CIRCUMSTANCES. I ALSO AGREE TO COMPLY WITH ALL M.O.S.H.A. REQUIREMENTS IN TESTING THIS LOT.

Zacharia Y. Fisch  
(SIGNATURE OF APPLICANT)

APPROVED BY \_\_\_\_\_ FOR \_\_\_\_\_ DATE \_\_\_\_\_

DISAPPROVED BY \_\_\_\_\_ FOR \_\_\_\_\_ DATE \_\_\_\_\_

HOLD PENDING FURTHER TESTS \_\_\_\_\_

REASONS FOR REJECTION OR HOLDING \_\_\_\_\_

PERCOLATION TEST PLAT/PRELIMINARY PLAT - TITLE OR I.D. # \_\_\_\_\_ DATE \_\_\_\_\_

SITE DEVELOPMENT PLAN/FINAL PLAT - TITLE OR I.D. # \_\_\_\_\_ DATE \_\_\_\_\_

## THIS IS NOT A PERMIT

COUNTY #

SOIL PROFILE

0' [Empty box for soil profile]

9554

[Empty box for soil profile]


9554

TOPSOIL  
BR L

---

TAN  
SC  
5/8 small  
Rock

13

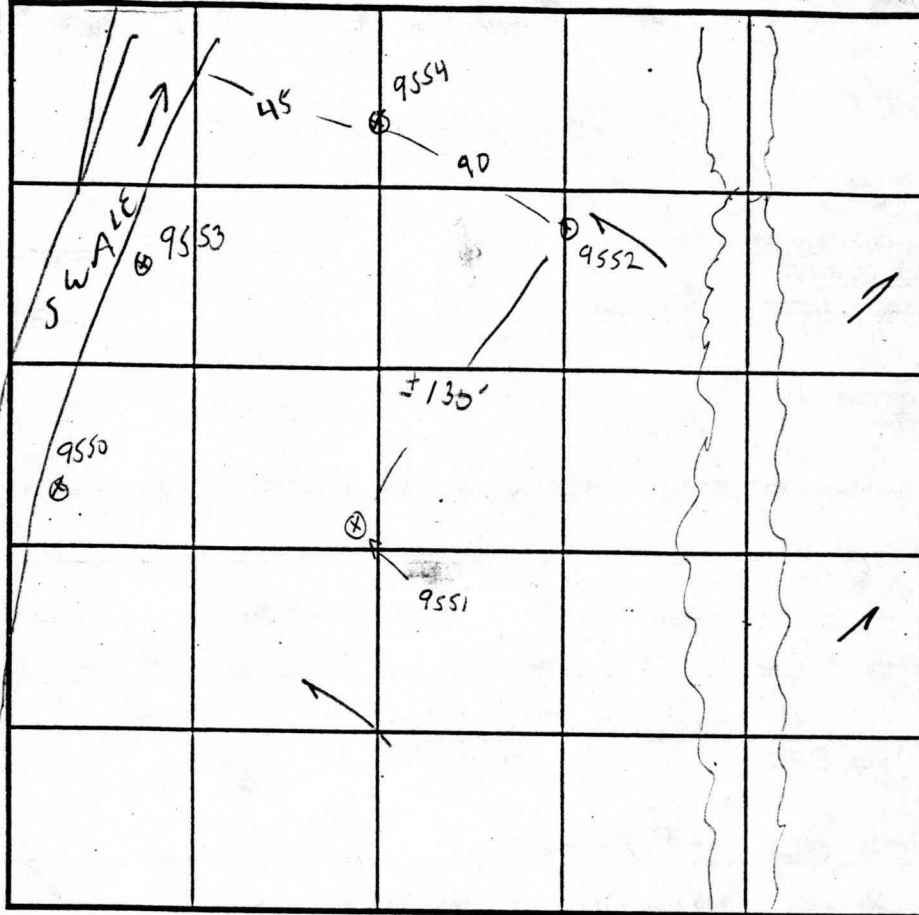

INDICATE NORTH - NAME ADJOINING ROADWAY AS BASE LINE.

BRANWOOD RD

SOIL PROFILE

9551

0' TOPSOIL  
D/B BR L

---

1 TAN SC  
2/8 Rock

13

LOT 4

DATE	TEST NO.	DEPTH	PRE-WET		TEST - 1" DROP		TIME
			START	STOP	START	STOP	
5/15/98	9551	3/13	11:42	11:51	→	5/12:15	24 MIN
						SLOW	—
	9554	3/13	11:53				
		3.5	12:01	12:07	→	12:14	7 MIN
	9552	2.5/12V	GOOD PROBLE - SC		BA/V	5/8 small Rock	OK

REMARKS \_\_\_\_\_

TYPE OF SOIL \_\_\_\_\_

TESTED BY G. SAUAGE ALSO PRESENT \_\_\_\_\_

TRENCH DESIGN DATA: AVERAGE PERCOLATION TIME \_\_\_\_\_ TRENCH WIDTH \_\_\_\_\_

INLET DEPTH \_\_\_\_\_ MAXIMUM BOTTOM DEPTH \_\_\_\_\_ SQ. FT./BEDROOM \_\_\_\_\_

# APPLICATION

PERCOLATION TESTING

A \_\_\_\_\_

P \_\_\_\_\_

HOWARD COUNTY HEALTH DEPARTMENT  
BUREAU OF ENVIRONMENTAL HEALTH  
3525-H ELLICOTT MILLS DRIVE/ELLICOTT CITY, MARYLAND 21043  
TELEPHONE: 313-2640

DISTRICT \_\_\_\_\_

DATE 3/9/98

TO: THE COUNTY HEALTH OFFICER  
ELLICOTT CITY, MARYLAND

I HEREBY APPLY FOR THE NECESSARY TEST PRIOR TO APPLICATION FOR PERMIT TO CONSTRUCT (OR RECONSTRUCT) A SEWAGE DISPOSAL SYSTEM.

PROPERTY OWNER \_\_\_\_\_

ADDRESS \_\_\_\_\_ PHONE \_\_\_\_\_

AGENT OR PROSPECTIVE BUYER WINCHESTER HOMES INC. c/o MR. KEITH KUBISTA

ADDRESS 6305 IVY LANE SUITE 800 PHONE (301) 489-1120  
GREENBELT MD. 20770

PROPERTY LOCATION:

SUBDIVISION MOBBERLY PROPERTY LOT NO. 23

ROAD AND DESCRIPTION BURNT WOODS ROAD

TAX MAP 22 PARCEL # 141, 2, 234 & 530

SIZE OF LOT 1 AC. CLUSTER TYPE BLDG. S.F.D.  
(SINGLE FAMILY DWELLING OR COMMERCIAL)

THE SYSTEM INSTALLED UNDER THIS APPLICATION IS ACCEPTABLE ONLY UNTIL PUBLIC FACILITIES BECOME AVAILABLE. I FULLY UNDERSTAND THE FEE CONNECTED WITH THE FILING OF THIS PERC TEST APPLICATION IS NON-REFUNDABLE UNDER ANY CIRCUMSTANCES. I ALSO AGREE TO COMPLY WITH ALL M.O.S.H.A. REQUIREMENTS IN TESTING THIS LOT.

Zecharia Y. Fisch  
(SIGNATURE OF APPLICANT)

APPROVED BY \_\_\_\_\_ FOR \_\_\_\_\_ DATE \_\_\_\_\_

DISAPPROVED BY \_\_\_\_\_ FOR \_\_\_\_\_ DATE \_\_\_\_\_

HOLD PENDING FURTHER TESTS \_\_\_\_\_

REASONS FOR REJECTION OR HOLDING \_\_\_\_\_

PERCOLATION TEST PLAT/PRELIMINARY PLAT - TITLE OR I.D. # \_\_\_\_\_ DATE \_\_\_\_\_

SITE DEVELOPMENT PLAN/FINAL PLAT - TITLE OR I.D. # \_\_\_\_\_ DATE \_\_\_\_\_

# THIS IS NOT A PERMIT


COUNTY #

SOIL PROFILE

0' [Empty box for soil profile]

48

4  
DK BR HEAVY CLAY  
Pink FINE SC  
MULTI-COLORS  
THROUGHOUT FROM PM  
10g SOLT PM  
13

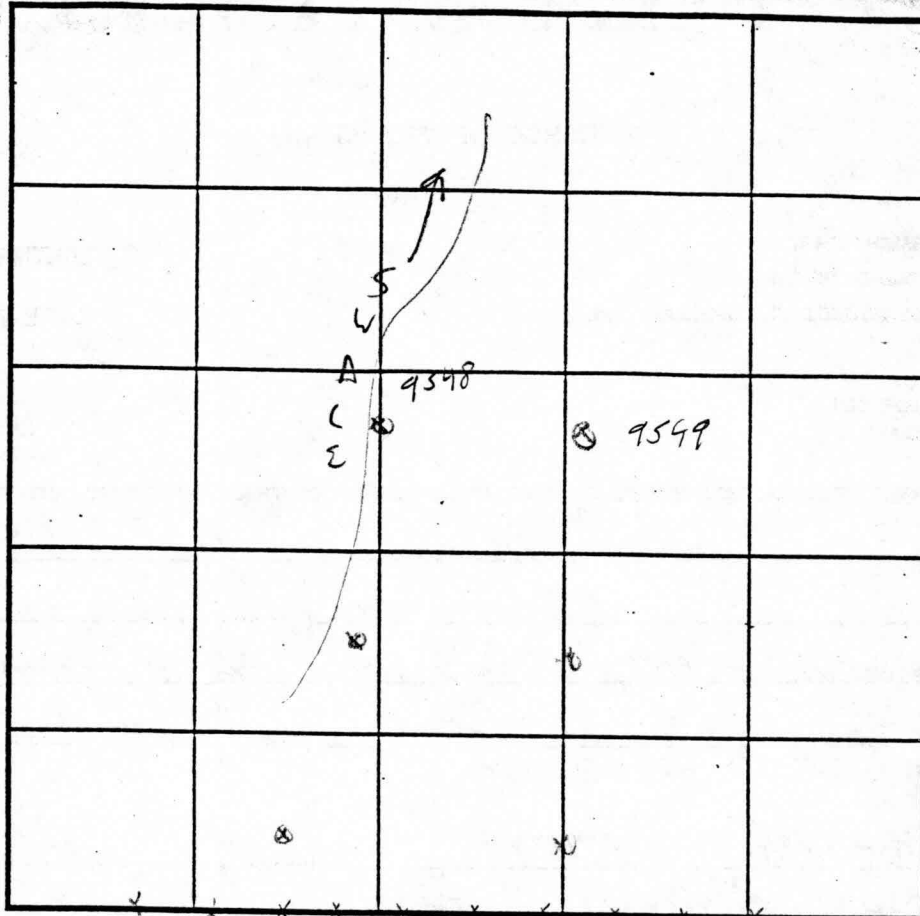

9549  
SOIL PROFILE

0'  
TOPSOIL 1'  
BROWN CLAY 5'  
LT BR SC  
10g RICKS MICACEOUS  
10.5'  
MASSIVE RICKS 112 OF HOLE  
12.5'

LOT 2

INDICATE NORTH - NAME ADJOINING ROADWAY AS BASE LINE.  
BURNINGWOODS ROAD

DATE	TEST NO.	DEPTH	PRE-WET		TEST - 1" DROP		TIME
			START	STOP	START	STOP	
5/15/78	9549	5.5 / 12.5	12:50	1:04	WOLLS PERC - SCAL		
		8'	1:27	1:30	→	1:33	3 MIN
	9548	11. / 13	12:32	12:35	→	12:38	34W
		5.5	1:27	1:31	→	1:37	64W

REMARKS 9549 Q' - ROCK & CLAY (C)  
TYPE OF SOIL \_\_\_\_\_  
TESTED BY G SAUVAGE ALSO PRESENT \_\_\_\_\_  
TRENCH DESIGN DATA: AVERAGE PERCOLATION TIME \_\_\_\_\_ TRENCH WIDTH \_\_\_\_\_  
INLET DEPTH \_\_\_\_\_ MAXIMUM BOTTOM DEPTH \_\_\_\_\_ SQ. FT./BEDROOM \_\_\_\_\_

# APPLICATION

## PERCOLATION TESTING

A \_\_\_\_\_

P \_\_\_\_\_

HOWARD COUNTY HEALTH DEPARTMENT  
BUREAU OF ENVIRONMENTAL HEALTH  
3525-H ELLICOTT MILLS DRIVE/ELLICOTT CITY, MARYLAND 21043  
TELEPHONE: 313-2640

DISTRICT \_\_\_\_\_

DATE 3/9/98

TO: THE COUNTY HEALTH OFFICER  
ELLICOTT CITY, MARYLAND

I HEREBY APPLY FOR THE NECESSARY TEST PRIOR TO APPLICATION FOR PERMIT TO CONSTRUCT (OR RECONSTRUCT) A SEWAGE DISPOSAL SYSTEM.

PROPERTY OWNER \_\_\_\_\_

ADDRESS \_\_\_\_\_ PHONE \_\_\_\_\_

AGENT OR PROSPECTIVE BUYER WINCHESTER HOMES INC. c/o MR. KEITH KUBISTA

ADDRESS 6305 IVY LANE SUITE 800 PHONE (301) 489-1120  
GREENBELT MD. 20770

PROPERTY LOCATION:

SUBDIVISION MOBBERLY PROPERTY LOT NO. 5

ROAD AND DESCRIPTION BURNT WOODS ROAD

TAX MAP 22 PARCEL # 141, 2, 234 & 530

SIZE OF LOT 1 AC. CLUSTER TYPE BLDG. S.F.D.  
(SINGLE FAMILY DWELLING OR COMMERCIAL)

THE SYSTEM INSTALLED UNDER THIS APPLICATION IS ACCEPTABLE ONLY UNTIL PUBLIC FACILITIES BECOME AVAILABLE. I FULLY UNDERSTAND THE FEE CONNECTED WITH THE FILING OF THIS PERC TEST APPLICATION IS NON-REFUNDABLE UNDER ANY CIRCUMSTANCES. I ALSO AGREE TO COMPLY WITH ALL M.O.S.H.A. REQUIREMENTS IN TESTING THIS LOT.

Zacharia Y. Fisch  
(SIGNATURE OF APPLICANT)

APPROVED BY \_\_\_\_\_ FOR \_\_\_\_\_ DATE \_\_\_\_\_

DISAPPROVED BY \_\_\_\_\_ FOR \_\_\_\_\_ DATE \_\_\_\_\_

HOLD PENDING FURTHER TESTS \_\_\_\_\_

REASONS FOR REJECTION OR HOLDING \_\_\_\_\_

PERCOLATION TEST PLAT/PRELIMINARY PLAT - TITLE OR I.D. # \_\_\_\_\_ DATE \_\_\_\_\_

SITE DEVELOPMENT PLAN/FINAL PLAT - TITLE OR I.D. # \_\_\_\_\_ DATE \_\_\_\_\_

# THIS IS NOT A PERMIT

↑ TO BURNT WOODS ROAD ↑


COUNTY #

SOIL PROFILE

0'

SOIL PROFILE

55  
0'  
6"  
TOPSOIL  
STRONG  
BR CL  
TAN  
LS  
3  
14

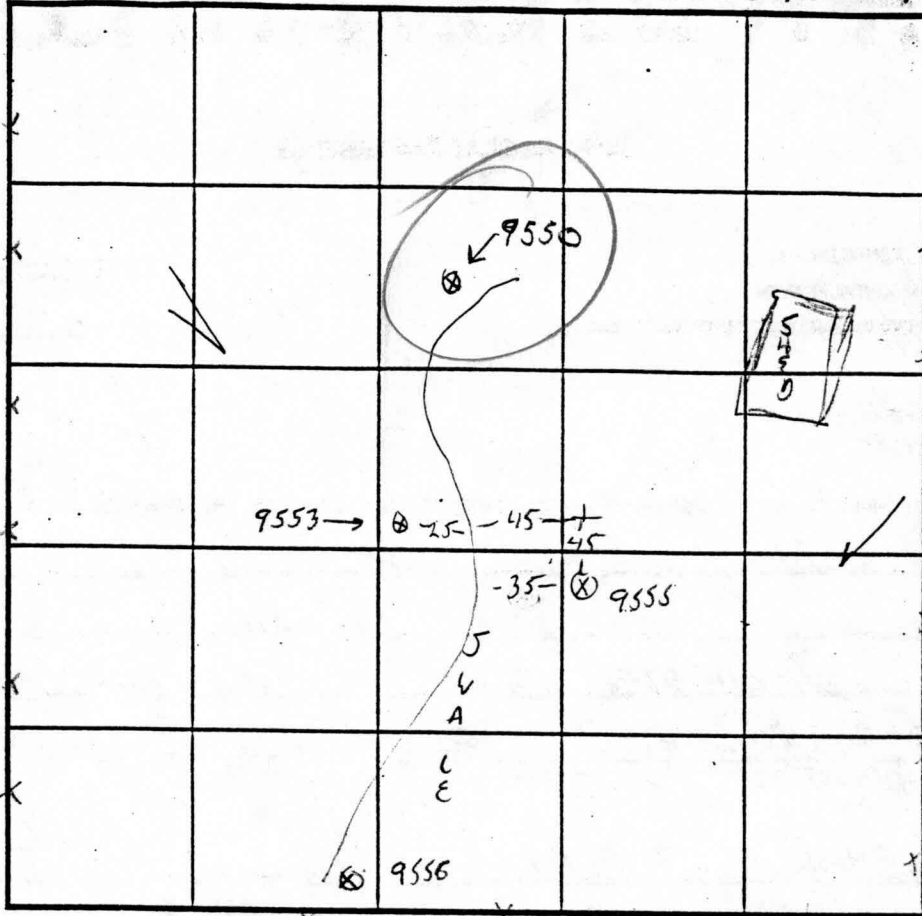

INDICATE NORTH - NAME ADJOINING ROADWAY AS BASE LINE

LOT 5

53 50  
18  
5'  
TOPSOIL  
STRONG  
BROWN  
LOAM  
TAN  
SL  
14

DATE	TEST NO.	DEPTH	PRE-WET		TEST - 1" DROP		TIME
			START	STOP	START	STOP	
4-23-98	9555	3.5/14	1:40	1:41	→	1:44	3 MW
	53	5/14	1:54	1:58	→	2:03	5 MW
	50	1/14	VISUAL	OK			OK
	56	SEE SHEET 1 OF 2	LOT 7	SLOW			F

REMARKS \_\_\_\_\_  
 TYPE OF SOIL \_\_\_\_\_  
 TESTED BY G. SAUACE ALSO PRESENT Fyock's CREW  
 TRENCH DESIGN DATA: AVERAGE PERCOLATION TIME \_\_\_\_\_ TRENCH WIDTH \_\_\_\_\_  
 INLET DEPTH \_\_\_\_\_ MAXIMUM BOTTOM DEPTH \_\_\_\_\_ SQ. FT./BEDROOM \_\_\_\_\_

# APPLICATION

PERCOLATION TESTING

A 59868  
P \_\_\_\_\_

HOWARD COUNTY HEALTH DEPARTMENT  
BUREAU OF ENVIRONMENTAL HEALTH  
3525-H ELLICOTT MILLS DRIVE/ELLICOTT CITY, MARYLAND 21043  
TELEPHONE: 313-2640

DISTRICT \_\_\_\_\_  
DATE 3/9/98

TO: THE COUNTY HEALTH OFFICER  
ELLICOTT CITY, MARYLAND

I HEREBY APPLY FOR THE NECESSARY TEST PRIOR TO APPLICATION FOR PERMIT TO CONSTRUCT (OR RECONSTRUCT) A SEWAGE DISPOSAL SYSTEM.

PROPERTY OWNER \_\_\_\_\_

ADDRESS \_\_\_\_\_ PHONE \_\_\_\_\_

AGENT OR PROSPECTIVE BUYER WINCHESTER HOMES INC. c/o Mr. KEITH KUBISTA

ADDRESS 6305 IVY LANE SUITE 800 PHONE (301) 489-1120  
GREENBELT MD. 20770

PROPERTY LOCATION:

SUBDIVISION MOBBERLY PROPERTY LOT NO. 15 3

ROAD AND DESCRIPTION BURNT WOODS ROAD

TAX MAP 22 PARCEL # 141, 2, 234 & 530

SIZE OF LOT 1 AC. CLUSTER TYPE BLDG. S.F.D.  
(SINGLE FAMILY DWELLING OR COMMERCIAL)

THE SYSTEM INSTALLED UNDER THIS APPLICATION IS ACCEPTABLE ONLY UNTIL PUBLIC FACILITIES BECOME AVAILABLE. I FULLY UNDERSTAND THE FEE CONNECTED WITH THE FILING OF THIS PERC TEST APPLICATION IS NON-REFUNDABLE UNDER ANY CIRCUMSTANCES. I ALSO AGREE TO COMPLY WITH ALL M.O.S.H.A. REQUIREMENTS IN TESTING THIS LOT.

Zecharia Y. Fisch  
(SIGNATURE OF APPLICANT)

APPROVED BY \_\_\_\_\_ FOR \_\_\_\_\_ DATE \_\_\_\_\_

DISAPPROVED BY \_\_\_\_\_ FOR \_\_\_\_\_ DATE \_\_\_\_\_

HOLD PENDING FURTHER TESTS \_\_\_\_\_

REASONS FOR REJECTION OR HOLDING \_\_\_\_\_

PERCOLATION TEST PLAT/PRELIMINARY PLAT - TITLE OR I.D. # \_\_\_\_\_ DATE \_\_\_\_\_

SITE DEVELOPMENT PLAN/FINAL PLAT - TITLE OR I.D. # \_\_\_\_\_ DATE \_\_\_\_\_

# THIS IS NOT A PERMIT

H59868

COUNTY#

SOIL PROFILE

0'

dark  
orange  
brown  
silt

---

3.0

like  
8241

---


2.0

8241

no  
distinct  
clay  
layer  
pink &  
yellow  
mottled  
silm  
not H<sub>2</sub>O  
1096 lg.  
(6-7")  
diameter  
slate

8242

like  
8241  
but  
pockets  
of  
pink  
silm  
&  
decayed  
white  
quartzite

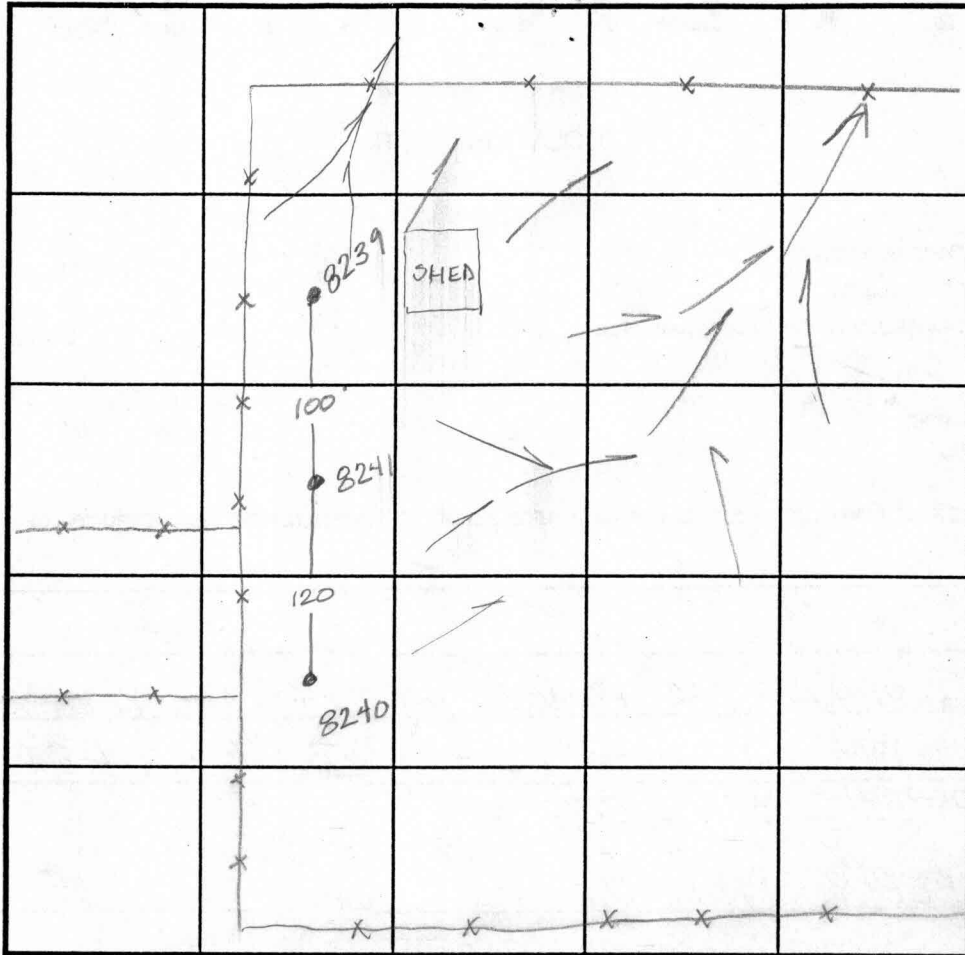

SOIL PROFILE

0'

INDICATE NORTH - NAME ADJOINING ROADWAY AS BASE LINE.

DATE	TEST NO.	DEPTH	PRE-WET		TEST - 1" DROP		TIME
			START	STOP	START	STOP	
3-18-99	8240	3.5 1/12.0	2:56	3:00	3:00	3:06	6min
	8241	Visual	to 12.0	-see	profile	—	OK
	8242	4.0 1/12.0	3:14	3:16	3:16	3:19	3min

REMARKS \_\_\_\_\_

TYPE OF SOIL \_\_\_\_\_


TESTED BY Amy McMillen ALSO PRESENT Fogles

TRENCH DESIGN DATA: AVERAGE PERCOLATION TIME 6 min. TRENCH WIDTH 3'

INLET DEPTH 3.5' MAXIMUM BOTTOM DEPTH 5.5' SQ. FT./BEDROOM 180' <sup>2</sup>

2.0

2.0

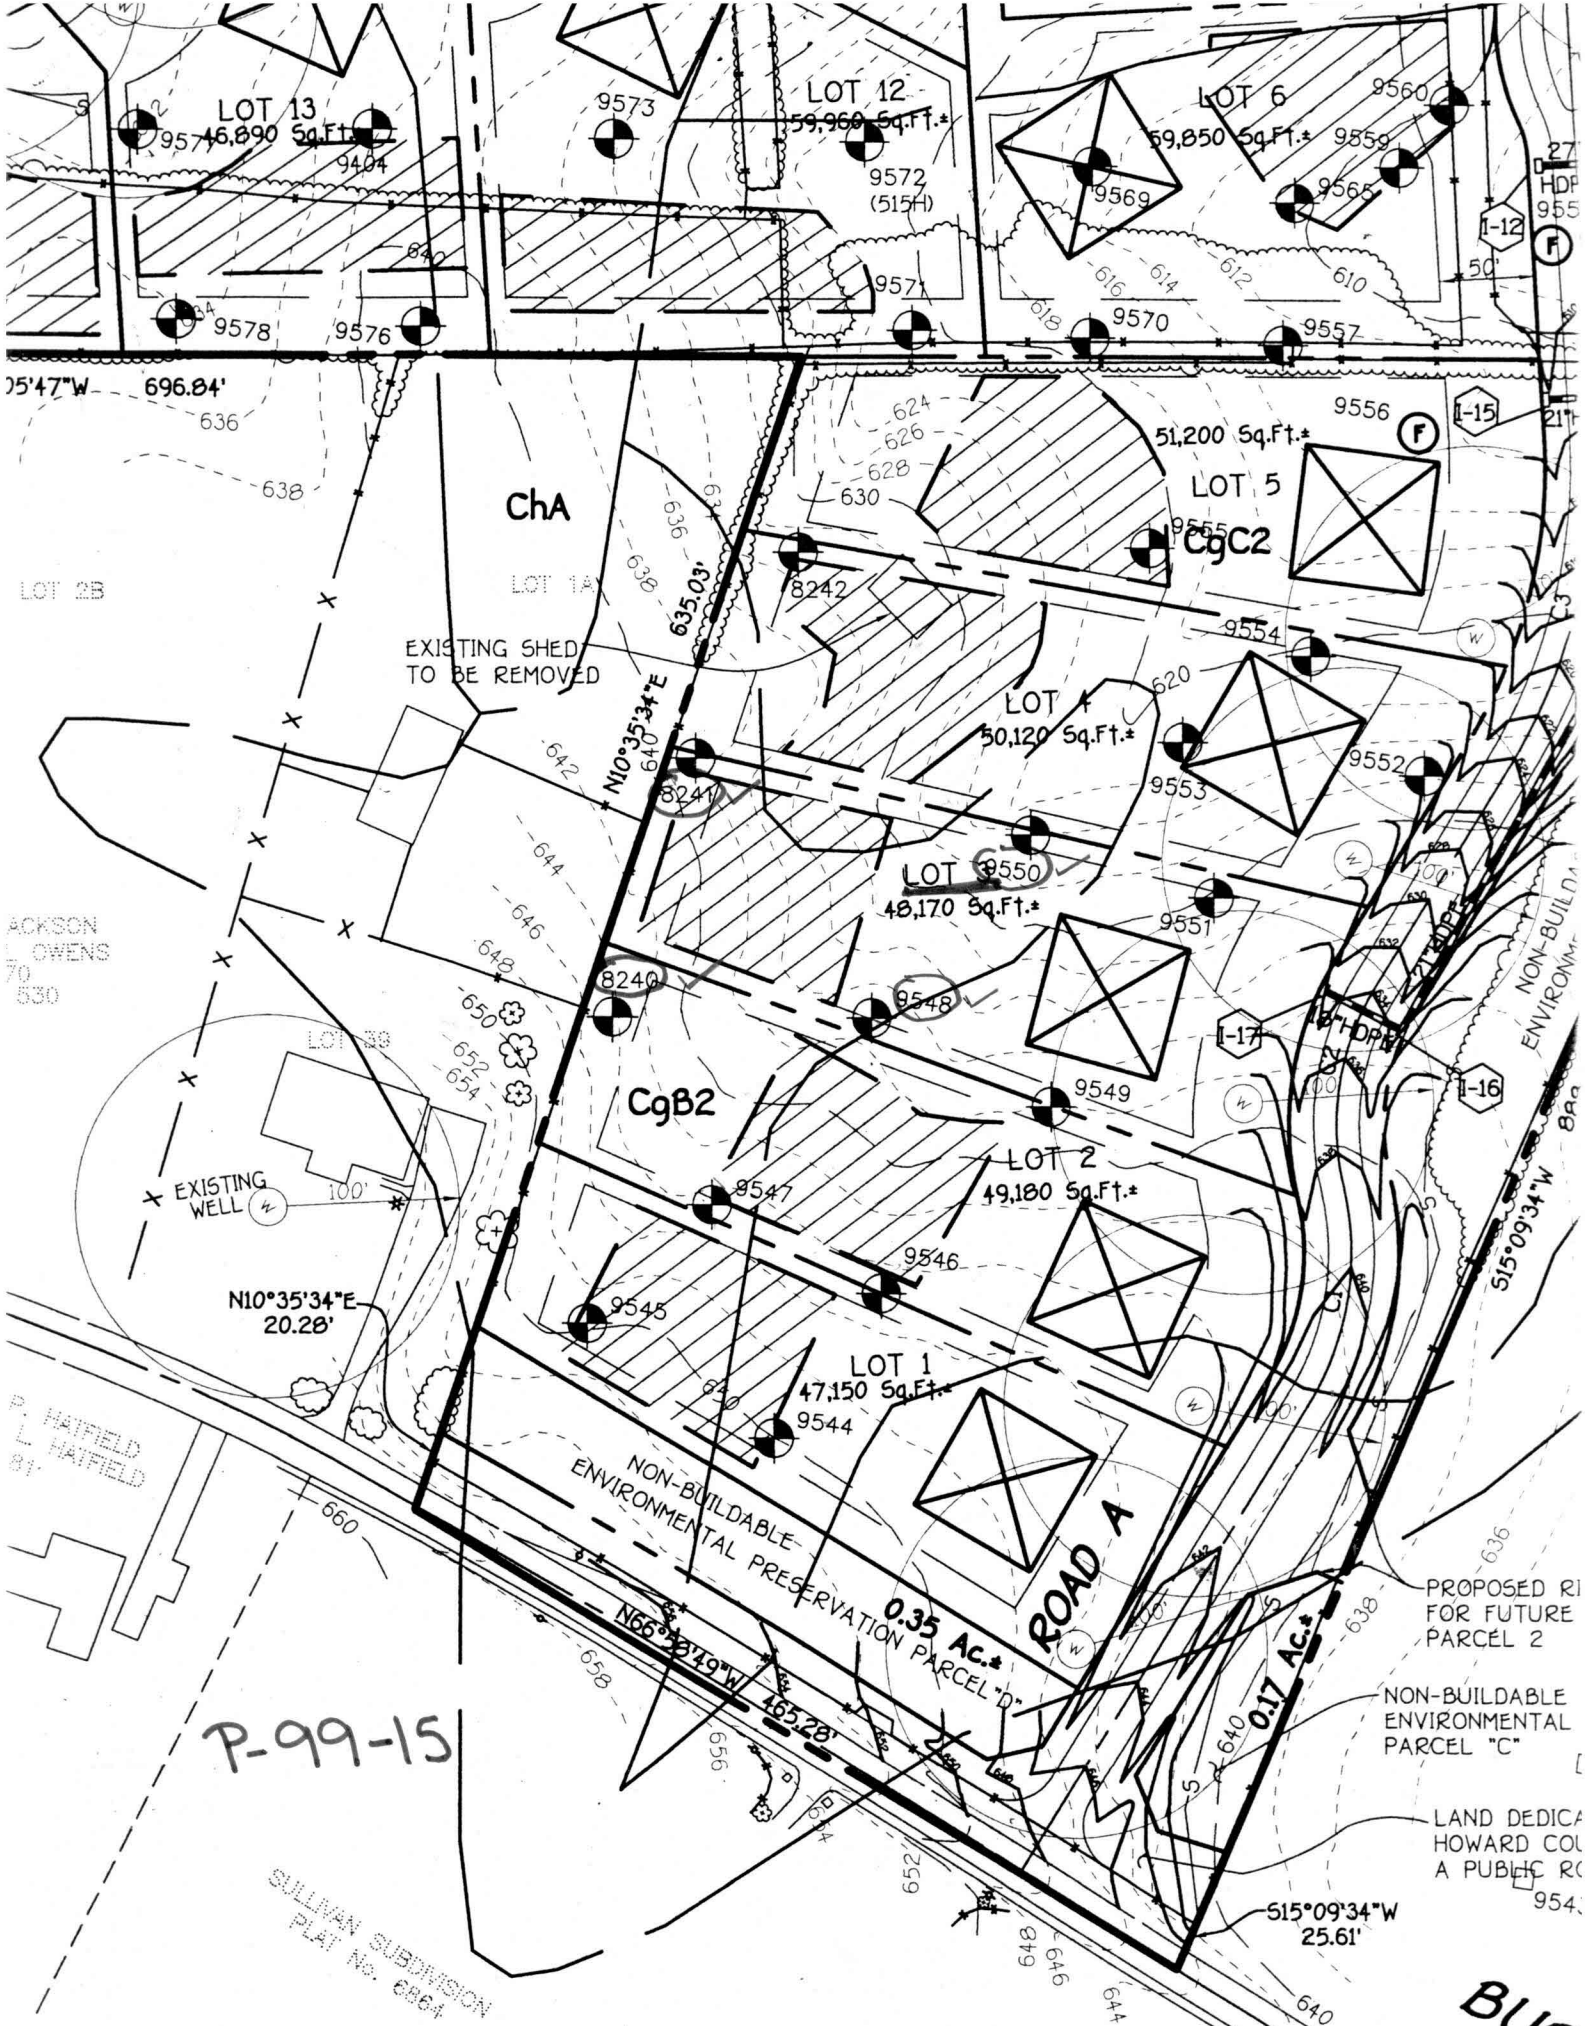

75'47"W 696.84'

LOT 2B

JACKSON  
OWENS  
70  
530

P. HAIFIELD  
L. HAIFIELD  
81'

P-99-15

SULLIVAN SUBDIVISION  
PLAT No. 8884

ChA

LOT 1A

EXISTING SHED  
TO BE REMOVED

$N10^{\circ}35'34"E$   
640.33'

CgB2

$N10^{\circ}35'34"E$   
20.28'

NON-BUILDABLE  
ENVIRONMENTAL PRESERVATION PARCEL "D"  
0.35 Ac.\*

ROAD A

0.17 Ac.\*

PROPOSED RI  
FOR FUTURE  
PARCEL 2

NON-BUILDABLE  
ENVIRONMENTAL  
PARCEL "C"

LAND DEDICA  
HOWARD COL  
A PUBLIC RC

BUR

LOT 13  
46,890 Sq.Ft.\*

LOT 12  
59,960 Sq.Ft.\*

LOT 6  
59,850 Sq.Ft.\*

LOT 5  
51,200 Sq.Ft.\*  
CgC2

LOT 4  
50,120 Sq.Ft.\*

LOT 3  
48,170 Sq.Ft.\*

LOT 2  
49,180 Sq.Ft.\*

LOT 1  
47,150 Sq.Ft.\*

27  
HDP  
955  
(F)

(F) I-15

9556

9552

(F) I-17


(F) I-16

NON-BUILDABLE  
ENVIRONMENTAL  
PRESERVATION  
PARCEL "B"

515°09'34"W  
25.61'

515°09'34"W  
25.61'

954

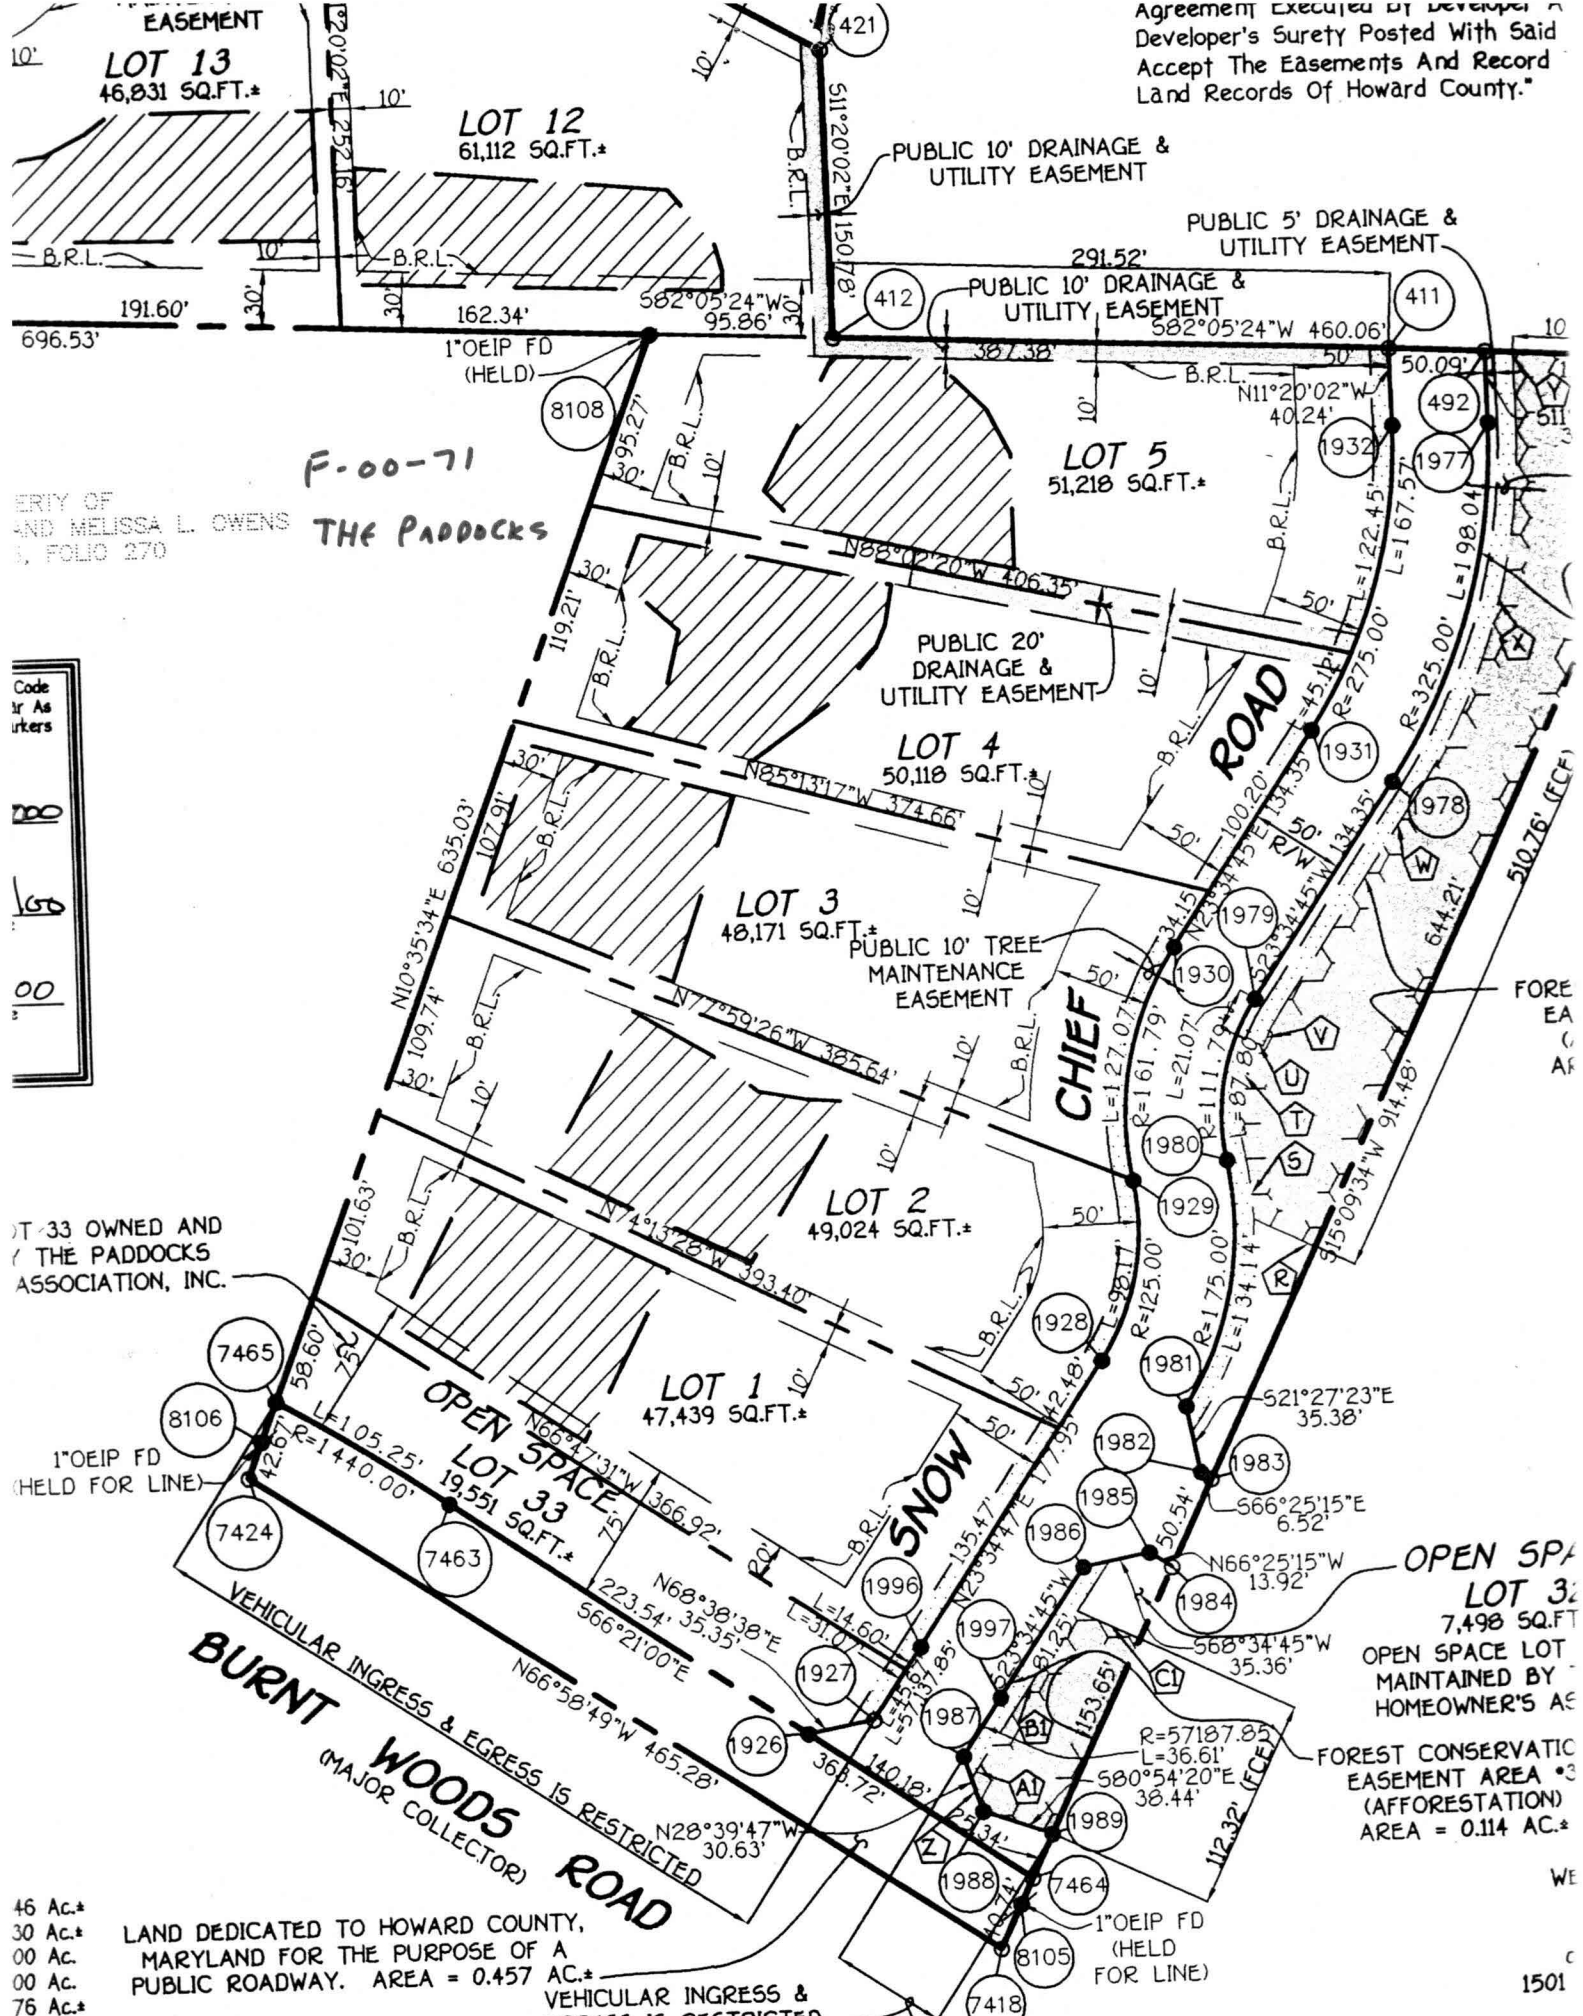

Agreement Executed by Developer and Developer's Surety Posted With Said Accept The Easements And Record Land Records Of Howard County."

**EASEMENT**  
**LOT 13**  
 46,831 SQ.FT.\*

**LOT 12**  
 61,112 SQ.FT.\*

**PUBLIC 5' DRAINAGE & UTILITY EASEMENT**

**PUBLIC 10' DRAINAGE & UTILITY EASEMENT**

**PUBLIC 10' DRAINAGE & UTILITY EASEMENT**

**F-00-71**  
**THE PADDOCKS**

**LOT 5**  
 51,218 SQ.FT.\*

**PUBLIC 20' DRAINAGE & UTILITY EASEMENT**

**LOT 4**  
 50,118 SQ.FT.\*

**LOT 3**  
 48,171 SQ.FT.\*

**PUBLIC 10' TREE MAINTENANCE EASEMENT**

**LOT 2**  
 49,024 SQ.FT.\*

**LOT 1**  
 47,439 SQ.FT.\*

**OPEN SPACE LOT 33**  
 19,551 SQ.FT.\*

LOT 33 OWNED AND THE PADDOCKS ASSOCIATION, INC.

1°OEIP FD (HELD FOR LINE)

**OPEN SPACE LOT 32**  
 7,498 SQ.FT.  
 OPEN SPACE LOT MAINTAINED BY HOMEOWNER'S ASSOCIATION

**FOREST CONSERVATION EASEMENT AREA (AFFORESTATION) AREA = 0.114 AC.\***

- 46 Ac.\*
- 30 Ac.\*
- 00 Ac.\*
- 00 Ac.\*
- 76 Ac.\*
- 22 Ac.\*

LAND DEDICATED TO HOWARD COUNTY, MARYLAND FOR THE PURPOSE OF A PUBLIC ROADWAY. AREA = 0.457 AC.\*  
 VEHICULAR INGRESS & EGRESS IS RESTRICTED

