

LAYOUT 3/4/08 INSP 4 \_\_\_\_\_  
INSP 2 \_\_\_\_\_ INSP 5 \_\_\_\_\_  
INSP 3 \_\_\_\_\_ INSP 6 \_\_\_\_\_

ISSUE DATE: 2/21/08

P 528507

APPROVAL DATE: 3/5/08

**PERMIT**  
*Logged Into Permit Manager*  
TAX ID # 05-431905

A 526672

**ON-SITE SEWAGE DISPOSAL SYSTEM  
HOWARD COUNTY HEALTH DEPARTMENT  
BUREAU OF ENVIRONMENTAL HEALTH**

Belkacem Manseur IS PERMITTED TO INSTALL  ALTER

ADDRESS: 14017 Big Branch Dr. PHONE NUMBER: 443-535-9639

SUBDIVISION: Big Branch overlook LOT NUMBER: 4

ADDRESS: 14017 Big Branch Dr. PROPERTY OWNER: Belkacem Manseur

SEPTIC TANK CAPACITY (GALLONS): Min 750 gal OUTLET BAFFLE FILTER REQUIRED

PUMP CHAMBER CAPACITY (GALLONS): \_\_\_\_\_ COMPARTMENTED TANK REQUIRED

DESIGN FLOW: \_\_\_\_\_

SQUARE FEET PER BEDROOM: \_\_\_\_\_

LINEAR FEET OF TRENCH REQUIRED: \_\_\_\_\_

TRENCHES:	
LOCATION:	
NOTES:	A minimum of a 750 gal piggy tank is required only if it is placed after the existing 1250 gal septic tank. If the new tank is placed before the existing 1250 gal tank, a 1250 gal or greater tank will be required. All tanks must meet current code. A traffic bearing lid will be required for the new septic tank if earth cover exceeds 3 feet on top of tank. Layout inspection required prior to installation.


PLANS APPROVED: SS DATE: 2/22/08

- NOTE: PERMIT VOID AFTER 2 YEARS
- NOTE: CONTRACTOR RESPONSIBLE FOR SCHEDULING A PRE-CONSTRUCTION INSPECTION FOR ALL INSTALLATIONS
- NOTE: WATERTIGHT SEPTIC TANKS REQUIRED
- NOTE: ALL PARTS OF SEPTIC SYSTEM SHALL BE 100 FEET FROM ANY WATER WELL
- NOTE: MANHOLE RISERS REQUIRED ON ALL SEPTIC TANKS AND PUMP CHAMBERS UNLESS SPECIFICALLY AUTHORIZED

**NEITHER THE HOWARD COUNTY COUNCIL NOR THE HEALTH DEPARTMENT IS RESPONSIBLE FOR THE SUCCESSFUL OPERATION OF ANY SYSTEM PERMITTEE RESPONSIBLE FOR OBTAINING FINAL APPROVAL ON THIS PERMIT CALL 410-313-1771 FOR INSPECTION OF SEPTIC SYSTEM**

H0-94-3067

NOT TO SCALE

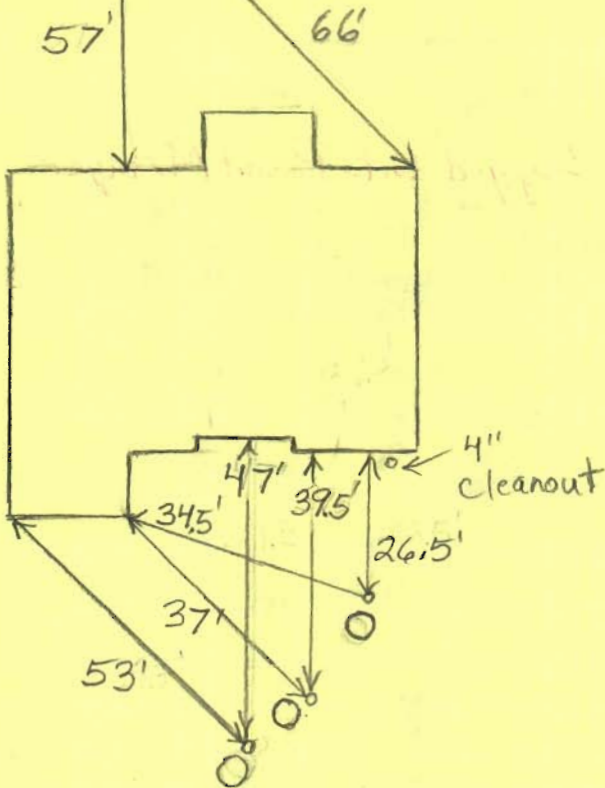

ROAD

**TRENCH/DRAINFIELD DATA**

WIDTH	INLET	BOTTOM
_____	_____	_____
NUMBER OF TRENCHES _____		
TOTAL LENGTH _____		
ABSORPTION AREA _____		
DISTRIBUTION BOX LEVEL _____		
DISTRIBUTION BOX BAFFLE _____		
DISTRIBUTION BOX PORT _____		

**SEPTIC TANK DATA**

SEPTIC TANK 1 LEVEL \_\_\_\_\_

CAPACITY 1250? GAL

SEAM LOC \_\_\_\_\_

TANK LID DEPTH \_\_\_\_\_

BAFFLES Front

BAFFLE FILTER No

MANHOLE LOC Middle

6" PORT LOC Front

WATERTIGHT TEST No

SEPTIC TANK 2 LEVEL \_\_\_\_\_

CAPACITY \_\_\_\_\_ GAL

SEAM LOC \_\_\_\_\_

TANK LID DEPTH \_\_\_\_\_

BAFFLES \_\_\_\_\_

BAFFLE FILTER \_\_\_\_\_

MANHOLE LOC \_\_\_\_\_

6" PORT LOC \_\_\_\_\_

WATERTIGHT TEST \_\_\_\_\_

PRE-CONSTRUCTION 3/4/08 set additional 1250 S.T. in front of  
existing ST. (KW) 3/5/08 New tank installed and back-  
 INSTALLATION filled. (BB)

FINAL INSPECTOR B. Baker

DATE OF APPROVAL 3/5/08

14017 Big Branch Cr.

### FILE INQUIRY NOTES

DATE	RESULTS OF REVIEW FOR FILE
2/22/08	
	Need an additional tank
	added to support a wash three permit.
	SS