

APPLICATION

A 16134

SEWAGE DISPOSAL TESTING

P _____

MARYLAND STATE DEPARTMENT OF HEALTH

HOWARD COUNTY *Septic Tank - 1000 gal*

ELLICOTT CITY

Day Well - 300 sq ft abandoned sidewalk area

DISTRICT 4

*to begin below the point 4 1/2 ft of non-porous
discharge length, so that pipe may extend to
at least 100 ft from grade. Inside day well
200 ft directly on back of red brick on corner
on 1st street.*

DATE 7/22/71

TO: THE COUNTY HEALTH OFFICER
ELLICOTT CITY, MARYLAND

I, HEREBY, APPLY FOR THE NECESSARY TESTS IN ORDER TO CONSTRUCT (OR RECONSTRUCT) A SEWAGE DISPOSAL SYSTEM.

PROPERTY OWNER Stanley B. Miller & wife

ADDRESS Route 144, Woodbine, Maryland PHONE 489-4816

PROPERTY LOCATION:

SUBDIVISION _____ LOT NO. _____

ROAD AND DESCRIPTION Route 144 - 1 mile outside of Lisbon going West - marked "The Farm"

OCCUPANT _____ PHONE _____

PERSON TO CONSTRUCT SYSTEM _____

ADDRESS _____ PHONE _____

SIZE OF LOT 100 acres TYPE BLDG. Trailer

IF NOT SINGLE RESIDENCE DESCRIBE _____ (Single Famly. Dwlg.)

SIGNATURE OF APPLICANT Stanley B. Miller

APPROVED BY [Signature] FOR Original DATE 7/30/71
(KIND OF SYSTEM)


REJECTED BY _____ FOR _____ DATE _____
(KIND OF SYSTEM)

HOLD PENDING FURTHER TESTS _____ DATE _____

REASONS FOR REJECTION OR HOLDING _____

THIS IS NOT A PERMIT

APPLICATION

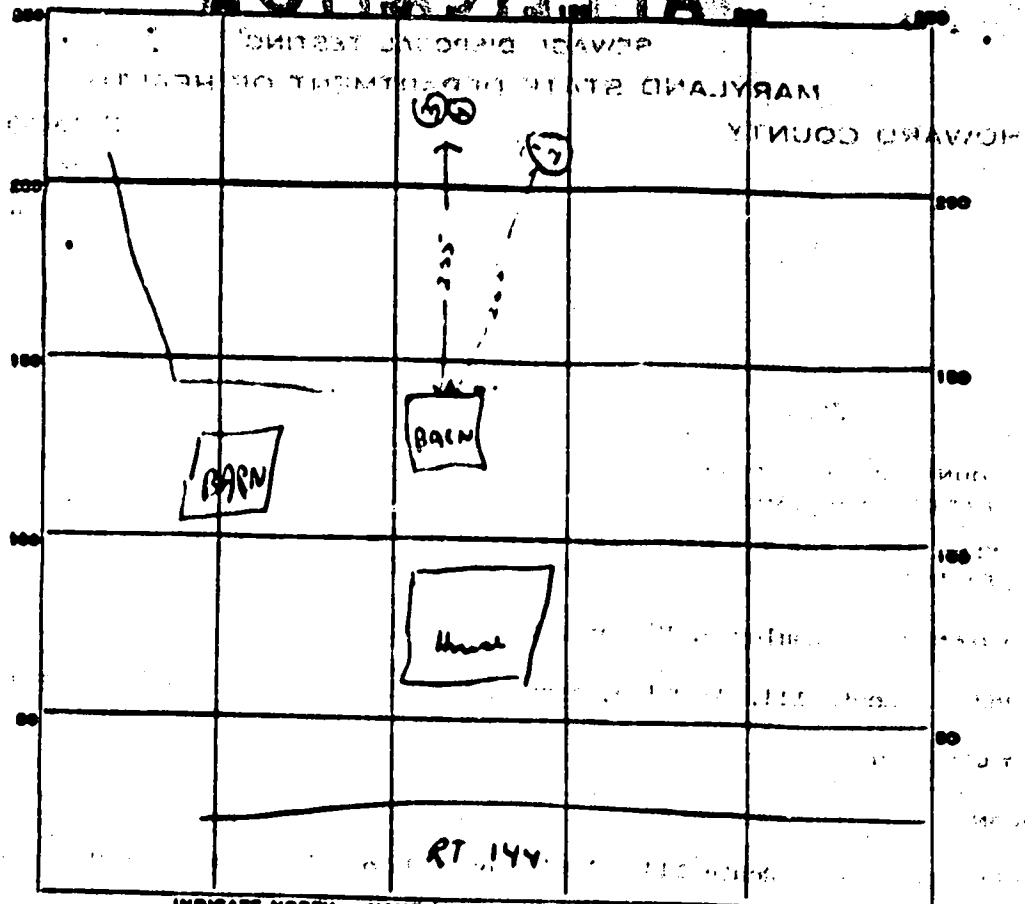

DATE	TEST NO.	DEPTH	PRE-WET		TEST - 1" DROP		TIME
			START	STOP	START	STOP	
7/29/71	1	10 1/2 ft.	11:08	11:21	11:21	11:45	26 min
	2	4 1/2 ft.	11:08	11:20	11:20	11:35	15 min
	3	5 ft.	11:19	11:22	11:22	11:29	7 min
	4	11 ft.	11:19	11:24	11:24	11:32	8 min

SOIL AUGER FINDING _____

TESTED BY R. Tone

REMARKS _____