

PUB. SEWER STATUS VERIFIED BY \_\_\_\_\_

04-338197

ISSUE DATE: \_\_\_\_\_

P \_\_\_\_\_

APPROVAL DATE: 5/29/73

A 56997-B

# PERMIT INDEXED

## ON-SITE SEWAGE DISPOSAL SYSTEM HOWARD COUNTY HEALTH DEPARTMENT BUREAU OF ENVIRONMENTAL HEALTH

\_\_\_\_\_ IS PERMITTED TO INSTALL  ALTER

ADDRESS: \_\_\_\_\_ PHONE NUMBER: \_\_\_\_\_

SUBDIVISION: \_\_\_\_\_ LOT NUMBER: \_\_\_\_\_

ADDRESS: 16347 Frederick Road PROPERTY OWNER: Langley

SEPTIC TANK CAPACITY (GALLONS): \_\_\_\_\_

PUMP CHAMBER CAPACITY (GALLONS): \_\_\_\_\_

NUMBER OF BEDROOMS: \_\_\_\_\_

SQUARE FEET PER BEDROOM: \_\_\_\_\_

LINEAR FEET OF TRENCH REQUIRED: \_\_\_\_\_

TRENCHES:	Trench to be _____ feet wide. Inlet _____ feet below original grade. Bottom maximum depth _____ feet below original grade. Effective area begins at _____ feet below original grade. _____ feet of stone below distribution pipe.
LOCATION:	_____
PURPOSE:	_____

PLANS APPROVED: \_\_\_\_\_ DATE: \_\_\_\_\_

- NOTE: PERMIT VOID AFTER 2 YEARS
- NOTE: CONTRACTOR RESPONSIBLE FOR SCHEDULING A PRE-CONSTRUCTION INSPECTION FOR ALL INSTALLATIONS
- NOTE: WATERTIGHT SEPTIC TANKS REQUIRED
- NOTE: ALL PARTS OF SEPTIC SYSTEM SHALL BE 100 FEET FROM ANY WATER WELL
- NOTE: MANHOLE RISERS REQUIRED ON ALL SEPTIC TANKS AND PUMP CHAMBERS

**NEITHER THE HOWARD COUNTY COUNCIL NOR THE HEALTH DEPARTMENT IS RESPONSIBLE FOR THE SUCCESSFUL OPERATION OF ANY SYSTEM PERMITTEE RESPONSIBLE FOR OBTAINING FINAL APPROVAL ON THIS PERMIT CALL 410-313-2640 FOR INSPECTION OF SEPTIC SYSTEM**

A 56997-B

# PERMIT

SEWAGE DISPOSAL SYSTEM

MARYLAND STATE DEPARTMENT OF HEALTH

HOWARD COUNTY

ELLICOTT CITY

DISTRICT 4

DATE 5/15/78

9/25/78

478 5220 73  
A 56997B  
A 78124

Stanley B. Miller & wife

IS PERMITTED TO INSTALL X ALTER

ADDRESS Route 144, Lisbon, Maryland

PHONE 482-4816

A SEWAGE DISPOSAL SYSTEM LOCATED AT

SUBDIVISION

16347 Frederick Road

ROAD Route 144

LOT

PROPERTY OWNER

Phillips & Plaster

(see application for better directions)

Henry Gloria Laagley

ADDRESS

16333 Frederick Rd., Woodburn, Md. 21791

489-4634

SPECIFICATIONS - trailer - 2 bedrooms

BLDG. PERMIT SIGNED

AND RETURNED 11/1/78

Permit No. 31522

Trailer to be removed & house 3

DRAIN FIELD \_\_\_\_\_ DEPTH \_\_\_\_\_ FEET. BOTTOM AREA \_\_\_\_\_ SQ. FT.

bedroom house constructed

SEEPAGE PITS \_\_\_\_\_ ABSORBENT SIDE-WALL AREA \_\_\_\_\_ SQ. FT.

SEPTIC TANK CAPACITY 1,000 GALLONS

FOR GARBAGE GRINDER, INCREASE DISPOSAL AREA 22% & TANK CAPACITY 50%.

OTHER Dry well - 200 sq. ft. absorbent sidewall area to begin below the slant

4 1/2 ft. of non-porous soil. Maximum depth permitted for dry well is 11 ft. below

original grade. Locate dry well 200 ft. directly in back of house as shown on plan sheet.

NOTE: ALL PIPE FROM HOUSE TO DRY WELL MUST BE CAST IRON.

PERMIT VOID AFTER THREE YEARS.

NOTE: INSTALL STAND PIPE ON SEPTIC TANK AND DRY WELL.

PLANS APPROVED BY Robert Torre

DATE 7/20/77


FILL SEPTIC TANK AND DISTRIBUTION BOX WITH WATER BEFORE CALLING FOR AN INSPECTION. COVER NO WORK UNTIL INSPECTED AND APPROVED.

NEITHER THE HOWARD COUNTY COMMISSIONERS NOR THE HEALTH DEPARTMENT IS RESPONSIBLE FOR THE SUCCESSFUL OPERATION OF ANY SYSTEM.

Add-on Deck  
BLDG. PERMIT SIGNED  
AND RETURNED 6-21-96  
Serial # B00100 715

A 66134

A 56997B

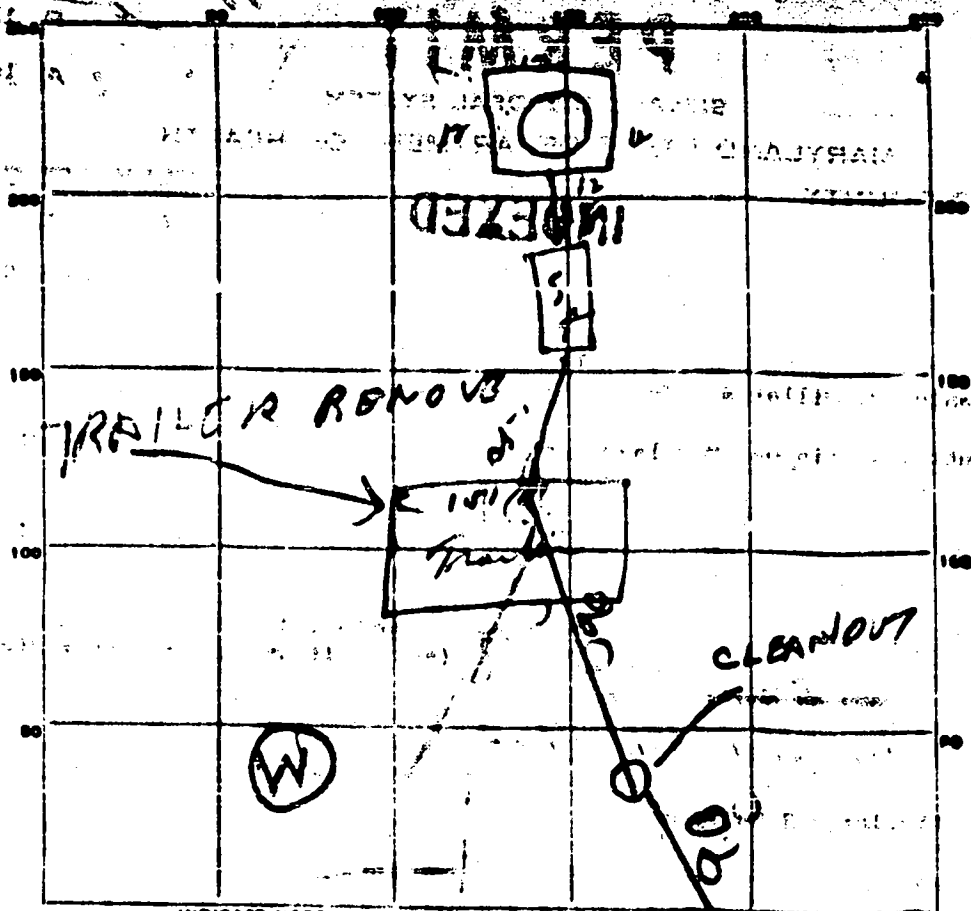

INDICATE NORTH - NAME ADJOINING ROADWAY AS BOUNDARY LINE.

PERMIT CARD OK

SEPTIC TANK, LEVEL OK

DISTRIBUTION BOX, LEVEL \_\_\_\_\_

TILE FIELD, DEPTH \_\_\_\_\_ FT. TRENCH WIDTH \_\_\_\_\_ FT.

GRAVEL DEPTH \_\_\_\_\_ IN. TOTAL LENGTH \_\_\_\_\_ FT.

NUMBER OF TRENCHES \_\_\_\_\_ TOTAL BOTTOM AREA \_\_\_\_\_

SEEPAGE PITS, INSIDE DIAMETER 18" FT. DEPTH BELOW INLET 8" FT.

ABSORBENT AREA 384 SQ. FT.

REMARKS 1. 18" LINE OK BUT CLEANOUTS MUST BE EVERY 50 FT. INSTALL CLEANOUT EVERY 50 FT. ON HOUSE SEWER. WORK TO COVER SEWER BUT INSTALL 2 MORE CLEANOUTS & CALL US. THERE WILL BE 3 CLEANOUTS TOTAL

DATE SYSTEM APPROVED 5/29/73 INSPECTOR [Signature]