

SEQUENCE NO. (WRA USE ONLY)  
**C1 5766**  
1 2 3 (SEQ. NO.) 4  
(THIS NUMBER IS TO BE PUNCHED IN COLS. 3-6 ON A&L CARDS)

STATE OF MARYLAND  
WATER RESOURCES ADMINISTRATION  
TAWES STATE OFFICE BLDG., ANNAPOLIS, MD. 21401  
WELL COMPLETION REPORT

THIS REPORT MUST BE SUBMITTED WITHIN 30 DAYS AFTER WELL COMPLETION  
FILL IN THIS FORM COMPLETELY  
COUNTY NUMBER

DATE RECEIVED (WRA USE ONLY)  
DATE WELL COMPLETED  
8-13

DEPTH OF WELL  
22 (TO NEAREST FOOT) 20

PERMIT NO. FROM "PERMIT TO DRILL WELL"  
28 29 30 31 32 33 34 35 36 37

OWNER LAST NAME FIRST NAME  
STREET OR RFD POST OFFICE

WELL LOG

STATE THE KIND OF FORMATIONS PENETRATED, THEIR COLOR, DEPTH, THICKNESS AND IF WATER BEARING

DESCRIPTION (USE ADDITIONAL SHEETS IF NECESSARY)	FEET		CHECK IF WATER BEARING
	FROM	TO	
<i>Basin Shale</i>	0	62	
<i>Blue Rock</i>	62	300	

GROUTING RECORD

WELL HAS BEEN GROUTED (CIRCLE APPROPRIATE BOX)  
YES  NO   
TYPE OF GROUTING MATERIAL (CIRCLE BOX)  
CEMENT  BENTONITE CLAY   
NO. OF BAGS 40 NO. OF POUNDS 40  
GALLONS OF WATER 40  
DEPTH OF GROUT SEAL (TO NEAREST FOOT)  
FROM 0 FT. TO 0 FT.  
(ENTER 0 IF FROM SURFACE)

CASING RECORD  
INSERT APPROPRIATE CODE BELOW  
STEEL  CONCRETE   
PLASTIC  OTHER   
MAIN CASING TYPE 5  
NOMINAL DIAMETER TOP (MAIN) CASING (NEAREST INCH) 60  
TOTAL DEPTH OF MAIN CASING (NEAREST FOOT) 60

OTHER CASING (IF USED)  
DIAMETER (INCH) FROM DEPTH (FEET) TO

SCREEN RECORD  
INSERT APPROPRIATE CODE BELOW  
STEEL  BRASS OPEN HOLE   
PLASTIC  OTHER

DEPTH (NEAREST WHOLE FOOT)  
FROM TO  
1 2 3 4 5 6 7 8 9 10 11 12 13 14 15 16 17 18 19 20 21 22

DIAMETER OF SCREEN (NEAREST INCH)  
FROM TO

GRAVEL PACK  
IF WELL DRILLED WAS A FLOWING WELL CIRCLE BOX

WRA USE ONLY (NOT TO BE FILLED IN BY DRILLER)  
TELESCOPE CASING LOG INDICATOR OTHER DATA AVAILABLE


PUMPING TEST

HOURS PUMPED (TO NEAREST HOUR)  
PUMPING RATE (GALLONS PER MINUTE TO NEAREST GALLON)  
METHOD USED TO MEASURE PUMPING RATE  
WATER LEVEL (DISTANCE FROM LAND SURFACE)  
BEFORE PUMPING AFTER PUMPING  
WHEN PUMPING  
TYPE OF PUMPED USED (CIRCLE APPROPRIATE BOX)  
AIR PISTON TURBINE  
CENTRIFUGAL ROTARY OTHER (DESCRIBE BELOW)  
JET SUBMERSIBLE

PUMP INSTALLED

TYPE OF PUMP (WRITE APPROPRIATE LETTER IN BOX - SEE ABOVE: A, C, J, P, R, S, T, O)  
DRILLER WILL INSTALL PUMP (CIRCLE APPROPRIATE BOX)  
CAPACITY:  
GALLONS PER MINUTE (TO NEAREST GALLON)  
PUMP HORSE POWER  
PUMP COLUMN LENGTH (NEAREST FOOT)  
CASING HEIGHT (CIRCLE APPROPRIATE BOX AND ENTER CASING HEIGHT)  
LAND SURFACE

LOCATION OF WELL ON LOT

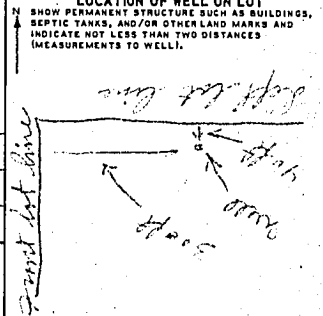

CIRCLE APPROPRIATE BOXES  
A WELL WAS ABANDONED AND SEALED WHEN THIS WELL WAS COMPLETED  
E ELECTRIC LOG OBTAINED  
P TEST WELL CONVERTED TO PRODUCTION WELL  
I HEREBY CERTIFY THAT I HAVE COMPLIED WITH ALL CONDITIONS STATED ON THE ABOVE-CAPTIONED "PERMIT TO DRILL WELL", AND THAT INFORMATION CONTAINED IN THIS REPORT IS TRUE, ACCURATE, AND COMPLETE TO THE BEST OF MY KNOWLEDGE, INFORMATION AND BELIEF.  
DRILLERS NAME  
SIGNATURE