

2/20/84
8/1/84
7/31/84
a.m.
well pump inspt.
please

approved
7/31/84

PERMIT

P 34153
A 28130

SEWAGE DISPOSAL SYSTEM

MARYLAND STATE DEPARTMENT OF HEALTH

HOWARD COUNTY
BUREAU OF ENVIRONMENTAL HEALTH
992-2330

INDEX

ELLICOTT CITY

DISTRICT 4th

DATE 7/27/84

04-319052

Donald Parlette IS PERMITTED TO INSTALL ALTER

ADDRESS 6575 Route 32, Clarksville, Maryland 21029 PHONE 531-286-2140

SUBDIVISION Lower Trail ROAD 16480 Route 144 LOT 2

PROPERTY OWNER Mr. & Mrs. Mark J. McNeill

ADDRESS P. O. Box 188
West Friendship, Maryland 21794

IF GARBAGE GRINDER IS USED INCREASE SEPTIC TANK CAPACITY BY 50% AND ABSORPTION AREA BY 22%.

GARBAGE GRINDER? YES NO

SEPTIC TANK CAPACITY 1500 GALLONS NUMBER OF BEDROOMS 3

DRY WELL - 147 square ft. sidewall area per bedroom. Dry well inlet maximum to be 3 feet below original grade and dry well bottom to be 11 feet below original grade. Place the dry well 131 feet from the front lot line and 142 feet from the right lot line as seen when facing the lot from Route 144 Road. The front lot line is the 343.73 ft. long lot line. Lot also suitable for deep trench - 2 ft. wide, 9 ft. deep, 97 ft. long with inlet at 3 ft. below original grade, and 6 ft. of gravel below distribution pipe. Run trench on level ground running through the point that is 131 ft. from the front lot line and 142 feet from the right side line. If trench is used, called for two inspections - before and after gravel is installed.

PLANS APPROVED BY Raymond Hodges DATE 4/2/80

COVER NO WORK UNTIL INSPECTED AND APPROVED.

NEITHER THE HOWARD COUNTY COUNCIL NOR THE HEALTH DEPARTMENT IS RESPONSIBLE FOR THE SUCCESSFUL OPERATION OF ANY SYSTEM.

NOTE: IF TRENCH IS USED CALL FOR INSPECTION BEFORE AND AFTER PLACING GRAVEL IN TRENCH.

NOTE: NO DRY WELL SHALL EXCEED 15 FOOT IN DIAMETER. NO ABSORPTION TRENCH TO EXCEED 100 FEET IN LENGTH.

NOTE: ALL PIPE FROM HOUSE TO SEPTIC TANK MUST BE CAST IRON OR SCHEDULE 40 PVC OR ABS.

PERMIT VOID AFTER THREE YEARS.

NOTE: INSTALL STAND PIPE ON SEPTIC TANK AND DRY WELL. STAND PIPES MUST BE 6 INCHES IN DIAMETER. CAST IRON, CONCRETE OR TERRA COTTA, OR PVC OR ABS ACCEPTED. IF TOP OF SEPTIC TANK IS DEEPER THAN 3 FEET MANHOLE TO GRADE REQUIRED.


BUDG. PERMIT SIGNED
AND RETURNED 8/31/90
Serial # 34527
1 story addition
5 rooms

A 28130

***INSTALLER IS RESPONSIBLE FOR OBTAINING FINAL APPROVAL ON THIS PERMIT**

*CALL 992-2330 FOR INSPECTION OF SEPTIC SYSTEMS.

EH - 2-1082

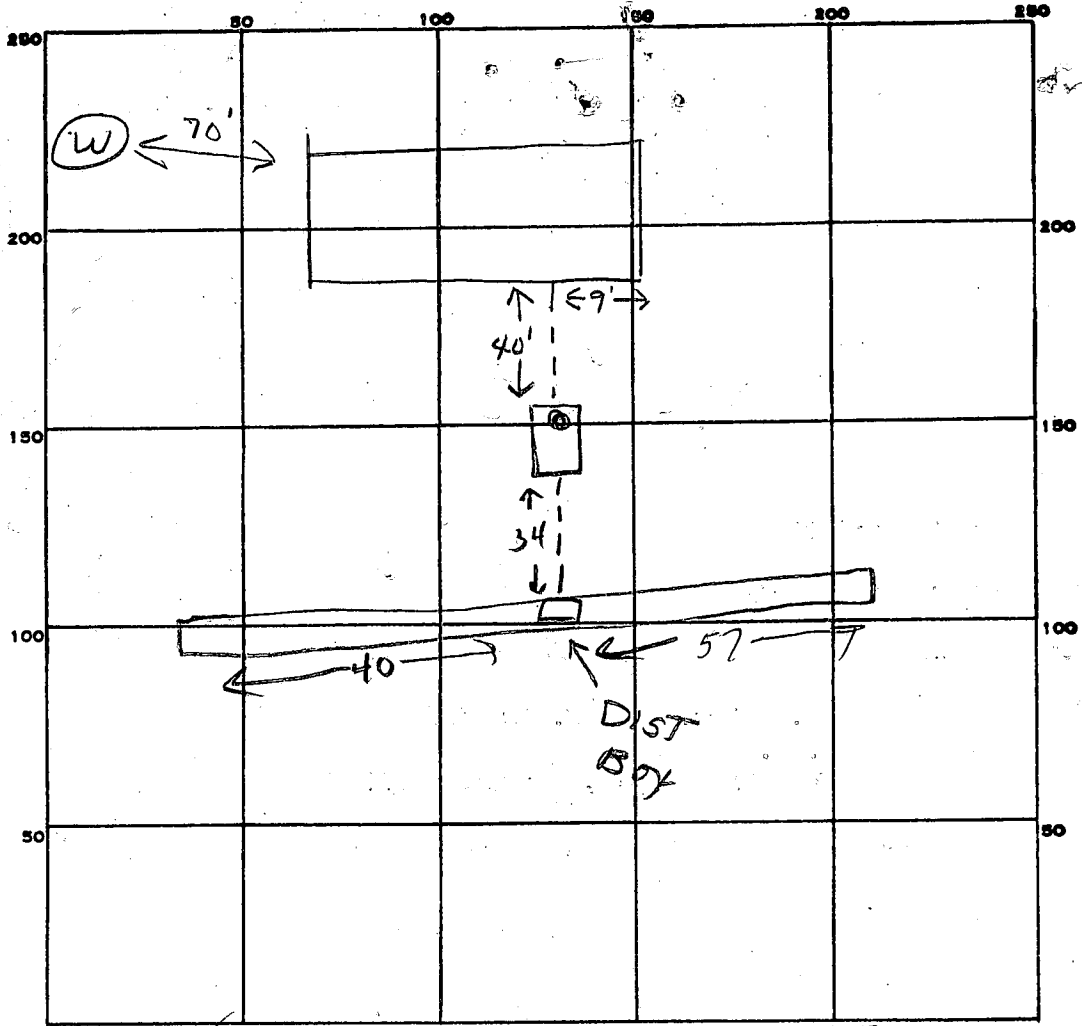

147
~~3~~
 441

INDICATE NORTH. - NAME ADJOINING ROADWAY AS BASE LINE.

PERMIT CARD _____

SEPTIC TANK, LEVEL ✓ 1500 gal CLEANOUTS ✓

DISTRIBUTION BOX, LEVEL ✓

TILE FIELD, DEPTH 9 FT. TRENCH WIDTH 2 FT.

GRAVEL DEPTH 6 FT IN. TOTAL LENGTH 97 FT.

NUMBER OF TRENCHES 1 TOTAL BOTTOM AREA 582

SEEPAGE PITS, INSIDE DIAMETER _____ FT. DEPTH BELOW INLET _____ FT.

ABSORBENT AREA 582 SQ. FT.

194
 3 | 582
 328
 27
 12

REMARKS 7/30/84 OK to add stone in trench

DATE SYSTEM APPROVED 7/30/84 INSPECTOR Craig Wilbur