

APPLICATION

A 28129

P _____

SEWAGE DISPOSAL TESTING

STATE OF MARYLAND - DEPARTMENT OF HEALTH AND MENTAL HYGIENE

HOWARD COUNTY HEALTH DEPARTMENT
ENVIRONMENTAL HEALTH SERVICES
P. O. BOX 476, ELLICOTT CITY, MARYLAND 21043
TELEPHONE: 465-5000, EXT. 356

DISTRICT 4th

DATE 6/2/78

TO THE COUNTY HEALTH OFFICER
ELLICOTT CITY, MARYLAND

I, HEREBY, APPLY FOR THE NECESSARY TEST IN ORDER TO CONSTRUCT (OR RECONSTRUCT) A SEWAGE DISPOSAL SYSTEM.

PROPERTY OWNER Howard Associates *Roger W. Haynes*
Dean Sumbough

ADDRESS 19686 ~~Wilton~~ *2921 Marlow Road*
Del Silver Springs PHONE *349-2035*
MD *384-6080*

PROPERTY LOCATION:

SUBDIVISION Lower Trail LOT NO. 1

ROAD AND DESCRIPTION *16488* Route 144

SIZE OF LOT 5.996 acres m/1 TYPE BLDG. 3 or 4 bedrooms
NUMBER OF BEDROOMS

IF NOT SINGLE RESIDENCE DESCRIBE _____

THE SYSTEM INSTALLED UNDER THIS APPLICATION IS ACCEPTABLE ONLY UNTIL PUBLIC FACILITIES BECOME AVAILABLE.

SIGNATURE OF APPLICANT /s/ Joel Abramson BLDG. PERMIT SIGNED AND RETURNED *10/16/84*
Serial # 41241 SFLD

APPROVED BY *Raymond Hodges* FOR *Dr. [unclear]* DATE *4/2/80*
(KIND OF SYSTEM)

REJECTED BY _____ FOR _____ DATE _____
(KIND OF SYSTEM)


HOLD PENDING FURTHER TESTS _____ DATE _____

REASONS FOR REJECTION OR HOLDING *perc. O.K. Hold for certified test hole*

locations F.S.

4/2/80 P. and Plot has been signed KH

THIS IS NOT A PERMIT

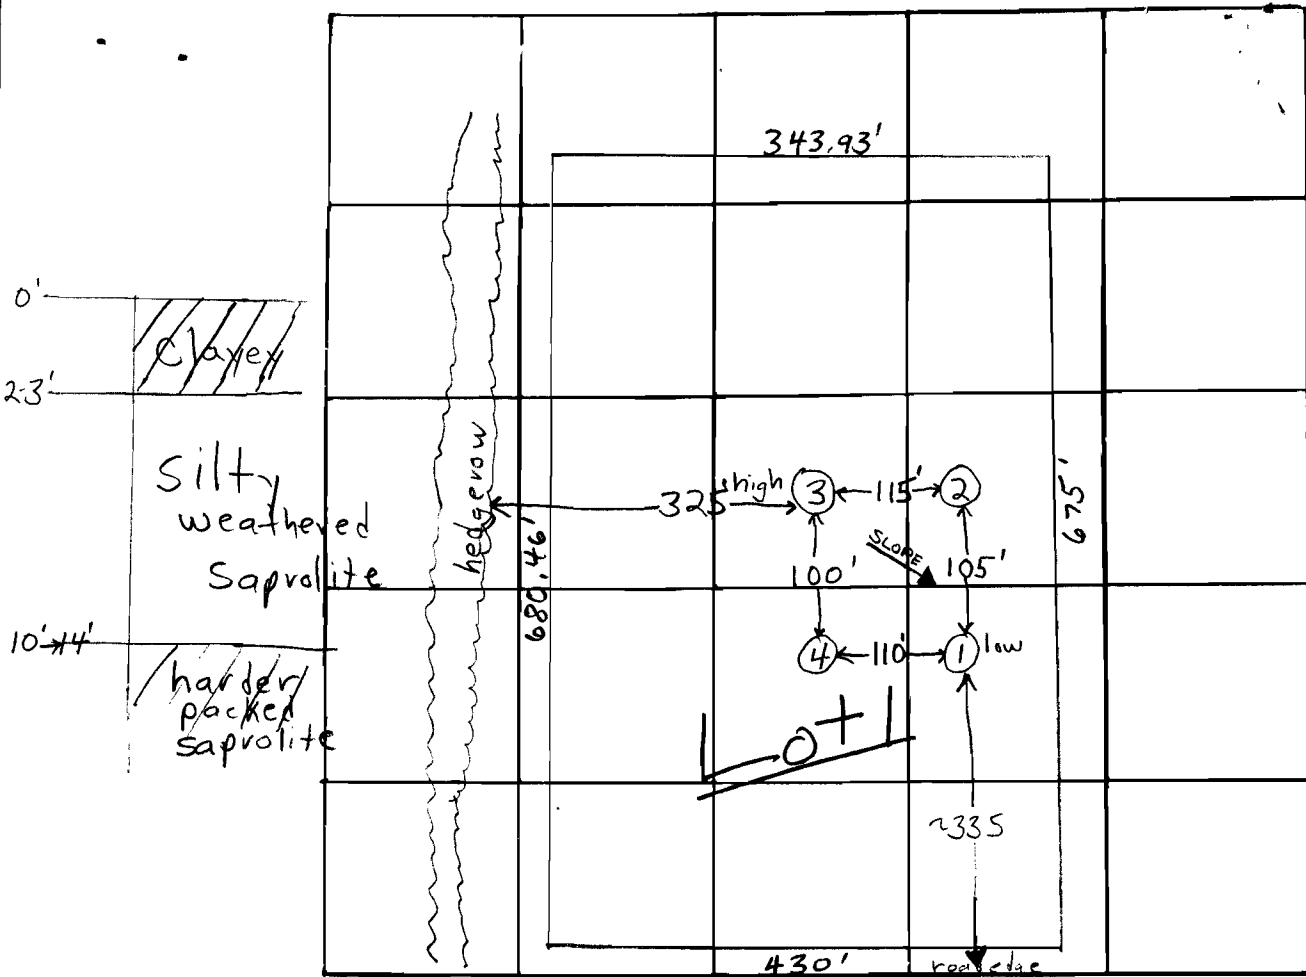

INDICATE NORTH - NAME ADJOINING ROADWAY AS BASE LINE

← West

Rte. # 144

East →

DATE	TEST NO.	DEPTH	PRE-WET		TEST - 1" DROP		TIME	
			START	STOP	START	STOP		
6/21/78	1 low	3'	10:20	10:32	10:32	10:54	22 min	
	1A	13'	10:18	10:25	10:25	10:44	19 min	
	2	3'	10:24	10:35	10:35	11:00	25 min	
	2A	13'	10:24	10:33	10:33	10:50	17 min	
	3 high	2 1/2'	10:31	10:35	10:35	10:41	6 min	
	3A	10 1/2'	10:31	10:41	10:41	11:05	24 min	
	4	14'	Clayey to ~3', silty weathered saprolite below					

REMARKS Hold for certified test hole locations, perc. O.K.

TYPE OF SOIL clayey to 2-3'; silty weathered saprolite below

TESTED BY F.S. & G.K. ALSO PRESENT: P. Lendrim