


A/P 5173

5173  
Brown L  
Orange/Brow  
Sel w/ 2500  
Cable City  
Firm 3 1/2  
Red/Brow  
SL 7 1/2  
Yellow/Brow  
SL w/  
trace  
Rock 12'

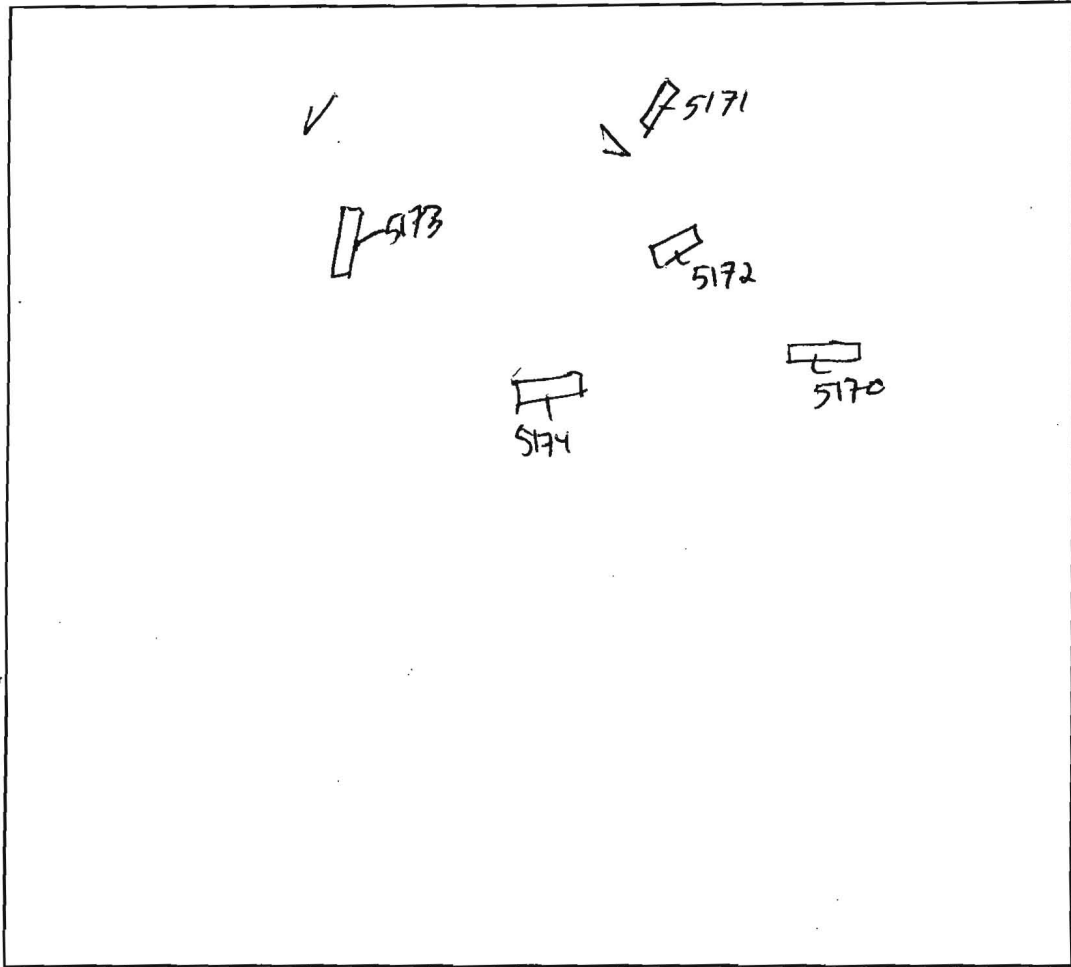

5174  
Brown L 1 1/2'  
Brown/Orange  
Sel 4'  
Brown/Yellow  
Rock  
SL 8'  
Yellow/Brown  
SL  
w/ trace  
Rock 12'

5172  
Brown L 1/2'  
Orange/Brown  
Sel 4'  
Yellow/Brown  
SL  
Yellow/Brown  
S  
w/ trace  
Rock 12'

5171  
Brown L  
Orange/Brown  
Sel  
Yellow/Brown  
SL  
Orange/Brown  
S  
w/ trace  
Rock

5170  
Brown L  
Red/Brown  
heavy  
Sel 3 1/2'  
Orange/Brown  
Red  
SL 9 1/2'  
Yellow/Brown  
SL  
w/ trace  
Rock 11'

DATE	TEST #	DEPTH	START	BREAK 1" DROP	STOP 2" DROP	TIME OF 2nd INCH	P/F/H
9/15/05	5173	4' / 12'	10:08	10:09	10:11	2nu	P
	5174	4 1/2' / 12'	10:13	10:16	10:21	8mir	P
	5172	4' / 12'	10:16	10:20	10:28	8mir	P
	5171	5' / 10'	10:27	10:30	10:34	4mir	P
	5170	4' / 11'	10:34	10:36	10:38	2mir	P

REMARKS lot 73 5170 shared w/ lot 22

SANITARIAN \_\_\_\_\_ BACKHOE \_\_\_\_\_ OTHERS \_\_\_\_\_

TEST HOLES USED IN SDA \_\_\_\_\_ AVG. PERC TIME \_\_\_\_\_ SQ. FT/BR \_\_\_\_\_


TRENCH WIDTH \_\_\_\_\_ INLET DEPTH \_\_\_\_\_ MAX. BOT DEPTH \_\_\_\_\_ EFFECTIVE S/W \_\_\_\_\_

A/P 5169

Wk org  
sicc 2'  
org brn  
(Trace Rr)  
h4L 5 1/2'  
brn  
3L  
Trace  
Rr  
Bottom 11 1/2'

5169  
org brn  
dense  
3L SE side  
cut to 6'

Refused 10'

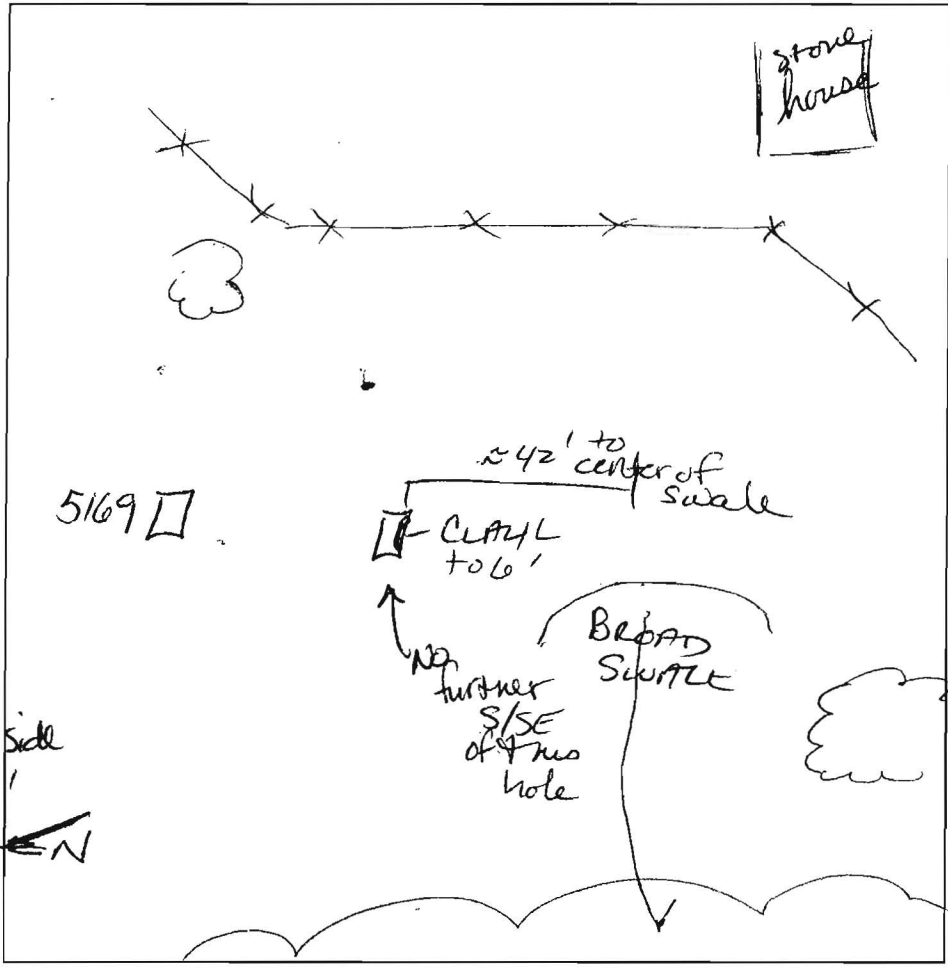

DATE	TEST #	DEPTH	START	BREAK 1" DROP	STOP 2" DROP	TIME OF 2nd INCH	P/F/H
9/15/05	5169	4'3" / 11 1/2'	11:57	12:00	12:04	4	P
	5167 ON Stake	3'2" / 10'	12:02	12:13	12:33	20	P

LOCATION OF HOLES: ON W. SIDE  
of BARN; NE CORNER OF Stone  
House ≈ 170' E

REMARKS \_\_\_\_\_

SANITARIAN \_\_\_\_\_ BACKHOE \_\_\_\_\_ OTHERS \_\_\_\_\_

TEST HOLES USED IN SDA \_\_\_\_\_ AVG. PERC TIME \_\_\_\_\_ SQ. FT/BR \_\_\_\_\_

TRENCH WIDTH \_\_\_\_\_ INLET DEPTH \_\_\_\_\_ MAX. BOT DEPTH \_\_\_\_\_ EFFECTIVE S/W \_\_\_\_\_



ENVIRONMENTAL SETBACK (TVP)

P17

EXISTING WELL  
TO BE  
ABANDONED

BUILDINGS  
TO REMAIN

EX. CARPORT  
TO REMAIN

Approved plan  
1/25/88

PRIVATELY OWNED  
BUILDABLE  
PRESERVATION  
PARCEL 1A  
11.188 AC.

24,000 GAL TANK FOR  
BUASE WATER SUPPLY  
& DRY INDICANT  
ROAD B  
PUBLIC ACCESS  
STREET B

55'x20' W/10'-1  
OFF  
FOR FIRE TRUCK