


① 2:11-2:13 2:13-2:17
5 1/2

NOT TO SCALE

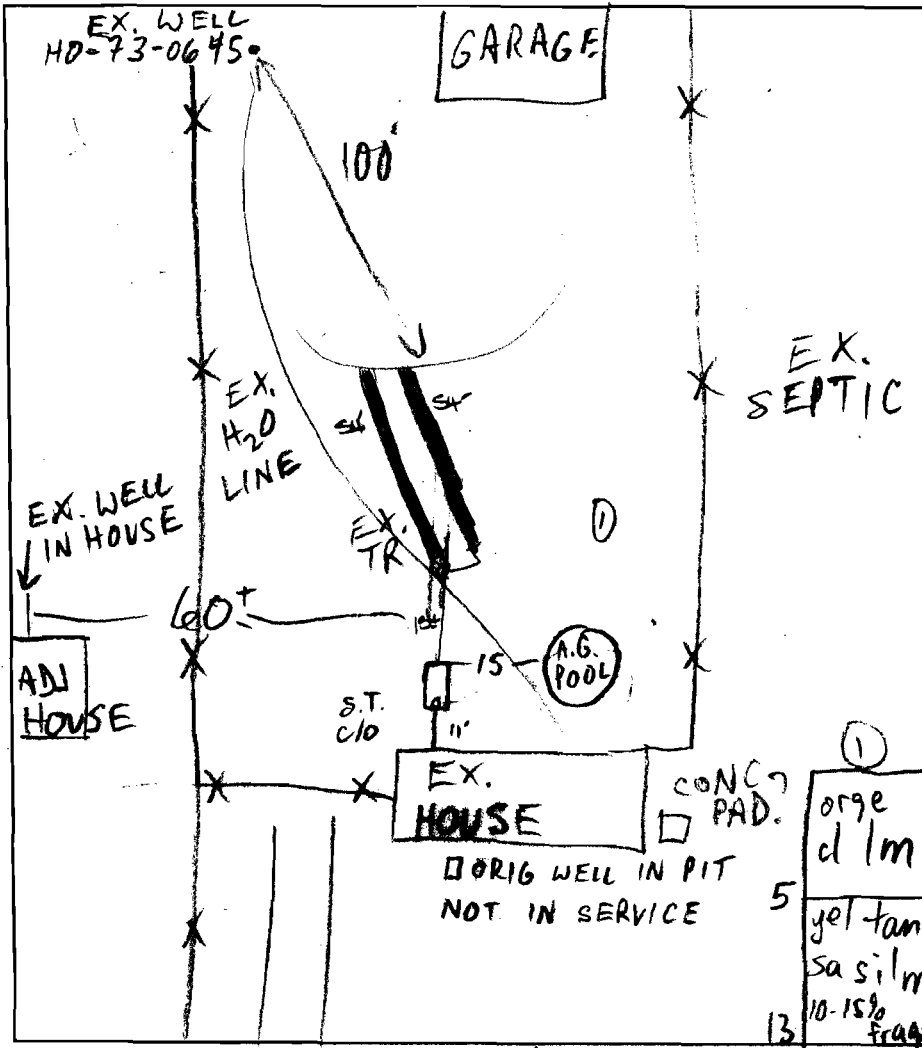

TRENCH DATA	
TRENCH WIDTH	2
TRENCH INLET DEPTH	4
TRENCH BOTTOM DEPTH	9
DEPTH OF STONE	5
NUMBER OF TRENCHES	2
TOTAL TRENCH LENGTH	108
ABSORBENT AREA	540
DISTRIBUTION BOX LEVEL	<input checked="" type="checkbox"/>
BAFFLE IN DISTRIBUTION BOX	<input type="checkbox"/>

SEPTIC TANK DATA	
SEPTIC TANK	Existing
GALLONS	
MANHOLE RISER	N/A
6 INCH INSPECTION PORT	<input checked="" type="checkbox"/>
PUMP CHAMBER DATA	
PUMP CHAMBER GALLONS	
MANHOLE RISER	
ALARM	
PUMP PERFORMANCE TEST	

PRE-CONSTRUCTION INSPECTION: 2/13/01 OK TO START

INSPECTION COMMENTS: 2/20/01 final inspection - OK to cover all septic work. DEC

INSPECTOR DEC DATE SYSTEM APPROVED 2/20/01