

FREDERICK ROAD RTE 144

Mac Paving

57 1/4° E

17 pchs

280.5'

321.75'

19 1/2 pchs

U 163 1/4° E

152'

18 pchs

S 10 1/2° W

APPROVED





WALK-THRU BUILDING PERMIT

BP# BC0155086 A# P 30182

APP. SAN AM DATE: 7/20/05

DESC. OF WORK: Blockwork

250'

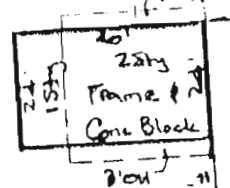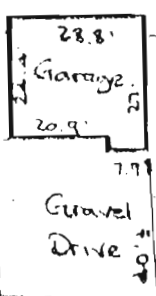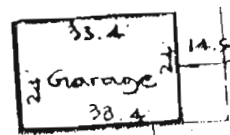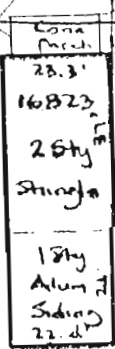

10 1/2 pchs

113.25'

B 1/2 pchs

313.5'

U 79° W

THE LOT SHOWN HEREON IS IN FLOOD ZONE C PER F.E.M.A. FLOOD INSURANCE RATE MAP PANEL# 240044 - 00078

The plat is of benefit to consumer only insofar as it is required by a lender or a title insurance company or its agent in connection with contemplated transfer, financing, or refinancing. The plat is not to be relied upon for the establishment or location of fences, garages, buildings, or other existing or future improvements. The plat does not provide for the accurate identification of property boundary lines, but such identification may not be required for the transfer of title or securing financing or refinancing. The plat contains a tolerance of accuracy of two feet, more or less.



Ertel Associates, Inc.

3109 Moreland Avenue
Baltimore, Maryland 21234
Phone: 410-882-0989 • Fax: 410-882-0842

LOCATION DRAWING
#16823 FREDERICK ROAD
LIBER 427, FOLIO 1066
HOWARD COUNTY, MD.

DATE: 8/20/00

SCALE: 1" = 40'

FILE: 00155086