

APPLICATION

FOR PERCOLATION TESTING AND SITE EVALUATION

TEST DATE(S) _____

TEST TIME _____

AP 522987
DATE 7/22/05

AGENCY REVIEW: _____

DO NOT WRITE ABOVE THIS LINE

I HEREBY APPLY FOR THE NECESSARY TESTING/EVALUATION PRIOR TO ISSUANCE OF SEWAGE DISPOSAL SYSTEM PERMIT(S) TO:

CHECK AS NEEDED:

- CONSTRUCT NEW SEPTIC SYSTEM(S)
- REPAIR/ADD TO AN EXISTING SEPTIC SYSTEM
- REPLACE AN EXISTING SEPTIC SYSTEM

CHECK AS NEEDED:

- NEW STRUCTURE(S)
- ADDITION TO AN EXISTING STRUCTURE
- REPLACE AN EXISTING STRUCTURE

CHECK ONE:

- CREATE NEW LOT(S)
- BUILD ON AN EXISTING LOT IN A SUBDIVISION
- BUILD ON AN EXISTING PARCEL OF RECORD

IS THE PROPERTY WITHIN 2500' OF ANY RESERVOIR?

- YES
- NO

THE TYPE OF STRUCTURE IS:

- RESIDENTIAL WITH PROPOSED BEDROOMS IN THE COMPLETED STRUCTURE (NOTE UNKNOWN IF APPROPRIATE)
- COMMERCIAL (PROVIDE DETAIL OF NUMBERS AND TYPES OF EMPLOYEES/CUSTOMERS ON ACCOMPANYING PLAN)
- INSTITUTIONAL/GOVERNMENT (PROVIDE DETAIL OF NUMBERS AND TYPES OF EMPLOYEES/USERS ON ACCOMPANYING PLAN)

PROPERTY OWNER(S) Frances Devlin

DAYTIME PHONE 410-997-4600 Goodier Bldrs. CELL _____ FAX _____

MAILING ADDRESS Echo Farm Route 3, 43 East Litchfield Rd., Litchfield CT 06750
STREET CITY/TOWN STATE ZIP

APPLICANT Heritage Land Development

DAYTIME PHONE 410-489-7900 CELL 410-982-2882 FAX 410-489-9768

MAILING ADDRESS 3060 Washington Road, Suite 220 Glenwood MD 21738
STREET CITY/TOWN STATE ZIP


APPLICANT'S ROLE DEVELOPER BUILDER BUYER RELATIVE/FRIEND REALTOR CONSULTANT

PROPERTY LOCATION
SUBDIVISION NAME Meriweather Farm - Section 3 LOT NO. 68

PROPERTY ADDRESS 14944 Roxbury Road Glenelg
STREET TOWN/POST OFFICE

TAX MAP PAGE(S) 21 GRID 16 PARCEL(S) 28 PROPOSED LOT SIZE 1 Acre

AS APPLICANT, I UNDERSTAND THE FOLLOWING: THE SYSTEM INSTALLED SUBSEQUENT TO THIS APPLICATION IS ACCEPTABLE ONLY UNTIL PUBLIC SEWAGE IS AVAILABLE. THIS APPLICATION IS COMPLETE WHEN ALL APPLICABLE FEES AND A SUITABLE SITE PLAN HAVE BEEN RECEIVED. I ACCEPT THE RESPONSIBILITY FOR COMPLIANCE WITH ALL M.O.S.H.A. AND "MISS UTILITY" REQUIREMENTS. APPROVAL IS BASED UPON SATISFACTORY REVIEW OF A PERCO CERTIFICATION PLAN. TEST RESULTS WILL BE MAILED TO APPLICANT.

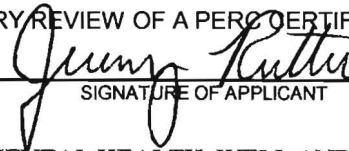
SIGNATURE OF APPLICANT


HOWARD COUNTY HEALTH DEPARTMENT, BUREAU OF ENVIRONMENTAL HEALTH, WELL AND SEPTIC PROGRAM
3525-H ELLICOTT MILLS DRIVE, ELLICOTT CITY, MARYLAND 21043-4544 (410) 313-1771 FAX (410) 313-2648
TDD (410) 313-2323 TOLL FREE 1-877-4MD-DHMH

LOTS 41 & 42

AP
5045
1' Tan loam Till layer
Red CLM Weakly cemented
5' Yellow Brown Solm 25% weak saprolite
Orange Brown 1m
11' Refusa

5044
1' Tan 1m
Orange Wcemented CLM
3' Orange CLM
6' Red Purple Silm < 5% weak saprolite
14

5043
11' Tan loam Plow
Red CLM Medium cementation
4' Red Solm
5' Orange Brown 1m Blacky Structure
8' Yellow Brown Solm 25% saprolite
2 1/2

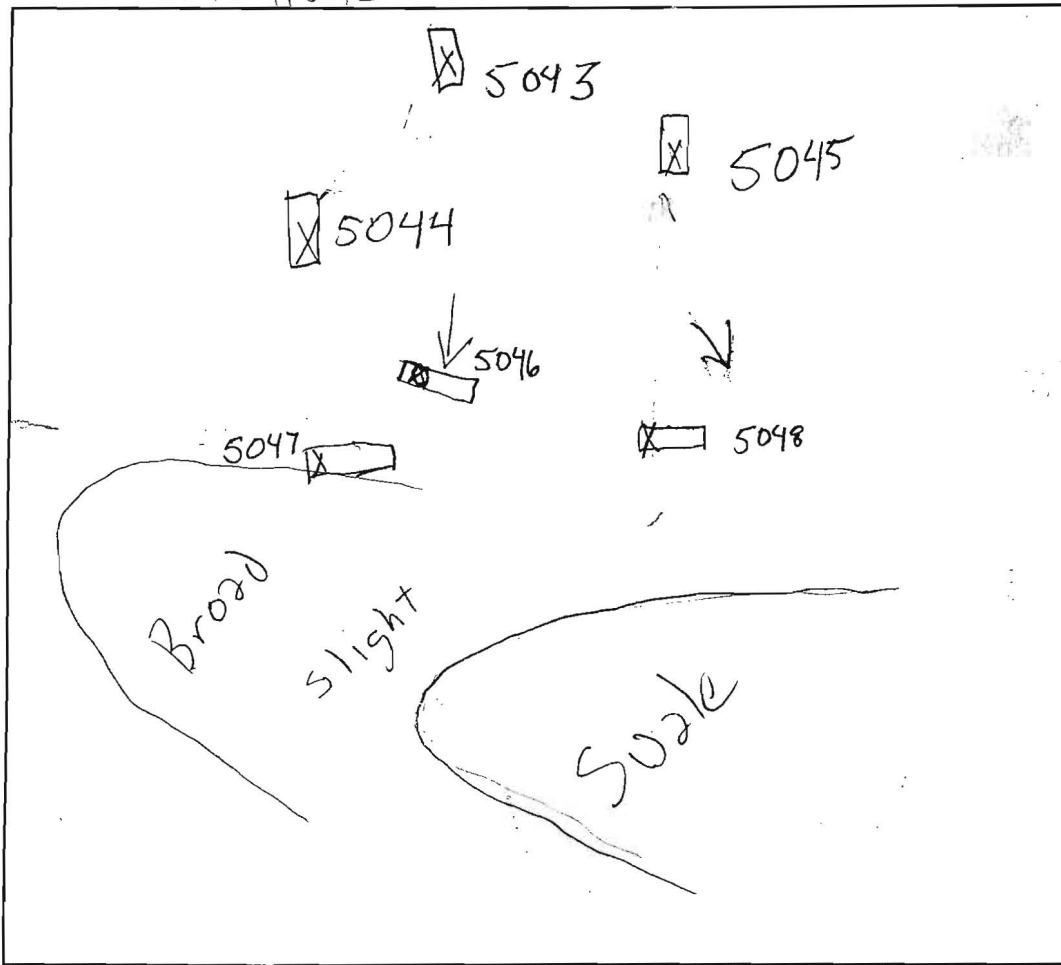

5046
Tan loam Plow
Orange Brown 1m Blacky
Red CLM Weakly cemented 5% rock
Red Solm
Orange Brown/Red 1m 15% Rock

5048
Tan 1m Plow
Orange Brown 1m
Red CLM 10-15% Rock
Red Solm 25% Rock
Tan Solm Orange 35% Rock/Saprolite

Refusa
5047
Tan 1m Plow
Orange Brown CLM
Orange Brown 1m
Red Purple Solm < 5% weak saprolite

DATE	TEST #	DEPTH	START	BREAK 1" DROP	STOP 2" DROP	TIME OF 2nd INCH	P/F/H
9/14/05	5045	5' 11"	9:05	Pulled 9:38			Repair
	5044	6' 14"	9:11	9:18	9:31	13m	P
	5043	6' 12 1/2"	9:23	9:26	9:31	5m	P
	5045 Repair	6' 11"	9:51	9:53	9:57	4m	P
	5046	6' 13"	10:11	10:19	10:30	11m	P
	5048	6' 11"	10:20	→	10:21		Repair
	Repair 5048	6' 11"	10:22	10:26	10:29	3m	P
	5047	6' 13"	10:37	10:39	10:43	4m	P

REMARKS Lot 47 & 48 645 25 to 18

SANITARIAN G. Creighton BACKHOE Zack Brundt OTHERS Jeremy, Justin, KBell, P Yencish

TEST HOLES USED IN SDA _____ AVG. PERC TIME _____ SQ. FT/BR _____

TRENCH WIDTH _____ IN. ET DEP 'H _____ MAX. BOT DEPTH _____ EFFECTIVE S/W _____

PRIVATELY OWNED
BUILDABLE
PRESERVATION
PARCEL 'A'
111.88 AC.±

LOT 18
48,329 sq. ft.

LOT 35
49,518 sq. ft.

LOT 20
40,260 sq. ft.

*Approved
P-Plan 11/25/08*

LOT 17
45,985 sq. ft.

LOT 36
43,657 sq. ft.

LOT 16
41,017 sq. ft.

LOT 37
42,037 sq. ft.

LOT 15
43,528 sq. ft.

LOT 38
40,785 sq. ft.

LOT 14
45,842 sq. ft.

LOT 13
48,007 sq. ft.

OWNER: H.O.A.
EASEMENT HOLDERS: HO. CO., MD. &
HOWARD COUNTY CONSERVANCY
NON-BUILDABLE
PRESERVATION
PARCEL 'H'
3.38 AC.±

FUTURE
LOT 35

FUTURE
LOT 34

FUTURE
LOT 33

FUTURE
LOT 32

EDGEWOOD FARM
PHASE 1
LOTS 1 - 7
NON-BUILDABLE-BULK PARCELS 'AA'-'HH'
NON-BUILDABLE PRESERVATION

P14

P22

P23