

APPLICATION

PERCOLATION TESTING

A _____

P _____

HOWARD COUNTY HEALTH DEPARTMENT
BUREAU OF ENVIRONMENTAL HEALTH
3525-H ELLICOTT MILLS DRIVE/ELLICOTT CITY, MARYLAND 21043
TELEPHONE: 313-2640

DISTRICT _____

DATE 8/17/00

TO: THE COUNTY HEALTH OFFICER
ELLICOTT CITY, MARYLAND

I HEREBY APPLY FOR THE NECESSARY TEST PRIOR TO APPLICATION FOR PERMIT TO CONSTRUCT (OR RECONSTRUCT) A SEWAGE DISPOSAL SYSTEM.

PROPERTY OWNER CARPENTER, FROOK LILLY AND BRANDE

ADDRESS C/O TRINITY QUALITY HOMES INC
7320 GEORGE DRIVE PHONE (410) 977-3082

AGENT OR PROSPECTIVE BUYER TRINITY QUALITY HOMES, INC

ADDRESS 7320 GEORGE DRIVE PHONE (410) 977 3082
Columbia MD 21044

PROPERTY LOCATION:

SUBDIVISION CASTLEBERRY AT TEW OAKS LOT NO. 19 18

ROAD AND DESCRIPTION TEW OAKS ROAD

TAX MAP 28 PARCEL # 551, 90, 60

SIZE OF LOT 40,000 - 60,000 TYPE BLDG. SFD
(SINGLE FAMILY DWELLING OR COMMERCIAL)

THE SYSTEM INSTALLED UNDER THIS APPLICATION IS ACCEPTABLE ONLY UNTIL PUBLIC FACILITIES BECOME AVAILABLE. I FULLY UNDERSTAND THE FEE CONNECTED WITH THE FILING OF THIS PERC TEST APPLICATION IS NON-REFUNDABLE UNDER ANY CIRCUMSTANCES. I ALSO AGREE TO COMPLY WITH ALL M.O.S.H.A. REQUIREMENTS IN TESTING THIS LOT.

Michael P. Paul (Pua)
(SIGNATURE OF APPLICANT)

APPROVED BY _____ FOR _____ DATE _____

DISAPPROVED BY _____ FOR _____ DATE _____

HOLD PENDING FURTHER TESTS _____

REASONS FOR REJECTION OR HOLDING _____


PERCOLATION TEST PLAT/PRELIMINARY PLAT - TITLE OR I.D. # _____ DATE _____

SITE DEVELOPMENT PLAN/FINAL PLAT - TITLE OR I.D. # _____ DATE _____

THIS IS NOT A PERMIT


NOT TO SCALE

COUNTY #

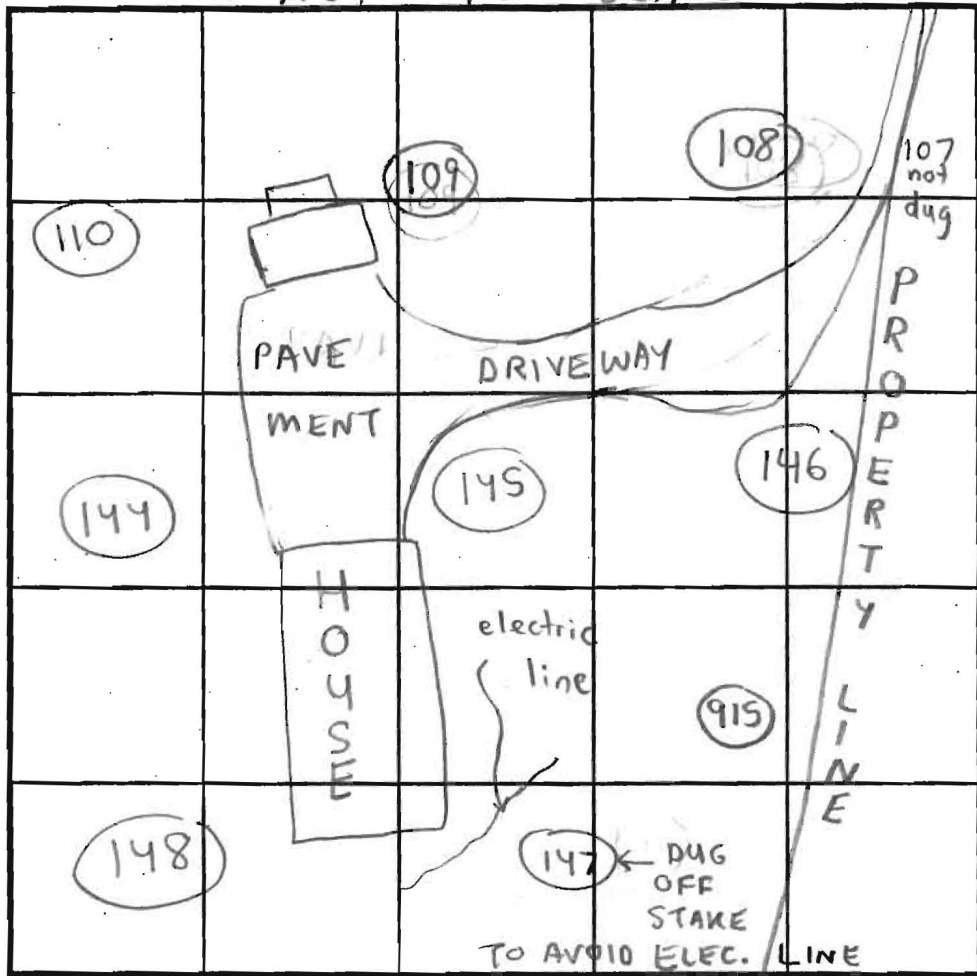


INDICATE NORTH - NAME ADJOINING ROADWAY AS BASE LINE.


SOIL PROFILE

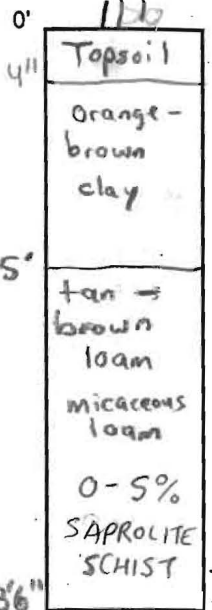


915

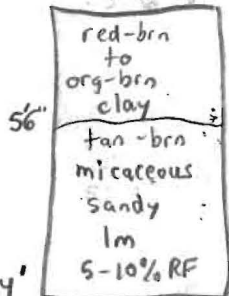


SOIL PROFILE

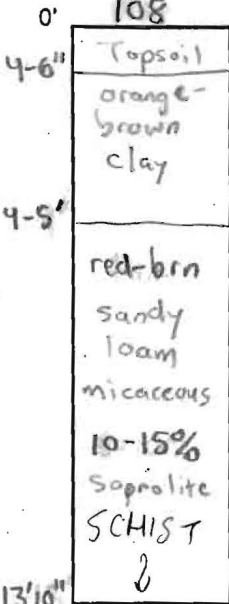

109

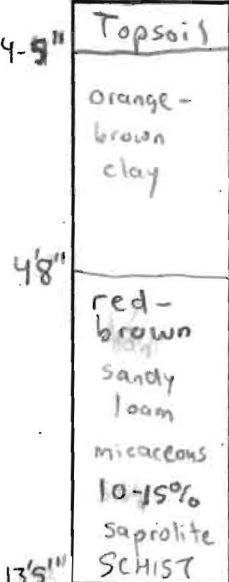

110

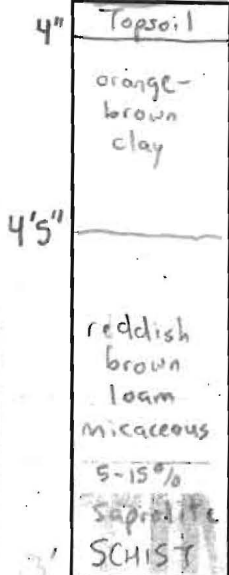

DATE	TEST NO.	DEPTH	PRE-WET		TEST - 1" DROP		TIME	
			START	STOP	START	STOP		
10/31/00	108	4' T 13'10" V	10:15am	10:17am	10:17am	10:21am	4min	OK
	109	4'6" T 13'5" V	10:24am	10:25am	10:25am	10:27am	2min	OK
	110	4'10" T 13'8" V	10:38am	10:40am	10:40am	10:43am	3min	OK
	111	5' T 13'6" V	10:47am	10:50am	10:50am	10:54am	4min	OK
4/10/02	915	5'5" T 14' V	3:49pm	3:51pm	3:51pm	3:55pm	4min	OK
10/31/00	112	4' T 13' V	10:58am	11:00am	11:00am	11:02am	2min	OK
	SEE	SOIL	PROFILE	FOR	111			

REMARKS: NOT MEANT AS WET SEASON TEST

TYPE OF SOIL: Chester


TESTED BY: Steven R. Krieg, Robert Fyock, Rachel Chaps Atkins - Posthole

TRENCH DESIGN DATA: AVERAGE PERCOLATION TIME _____ TRENCH WIDTH _____

INLET DEPTH _____ MAXIMUM BOTTOM DEPTH _____ SQ. FT./BEDROOM _____

Frank Alfonso - 4/10/02
Jack Fyock on 10/31/00

13'8"

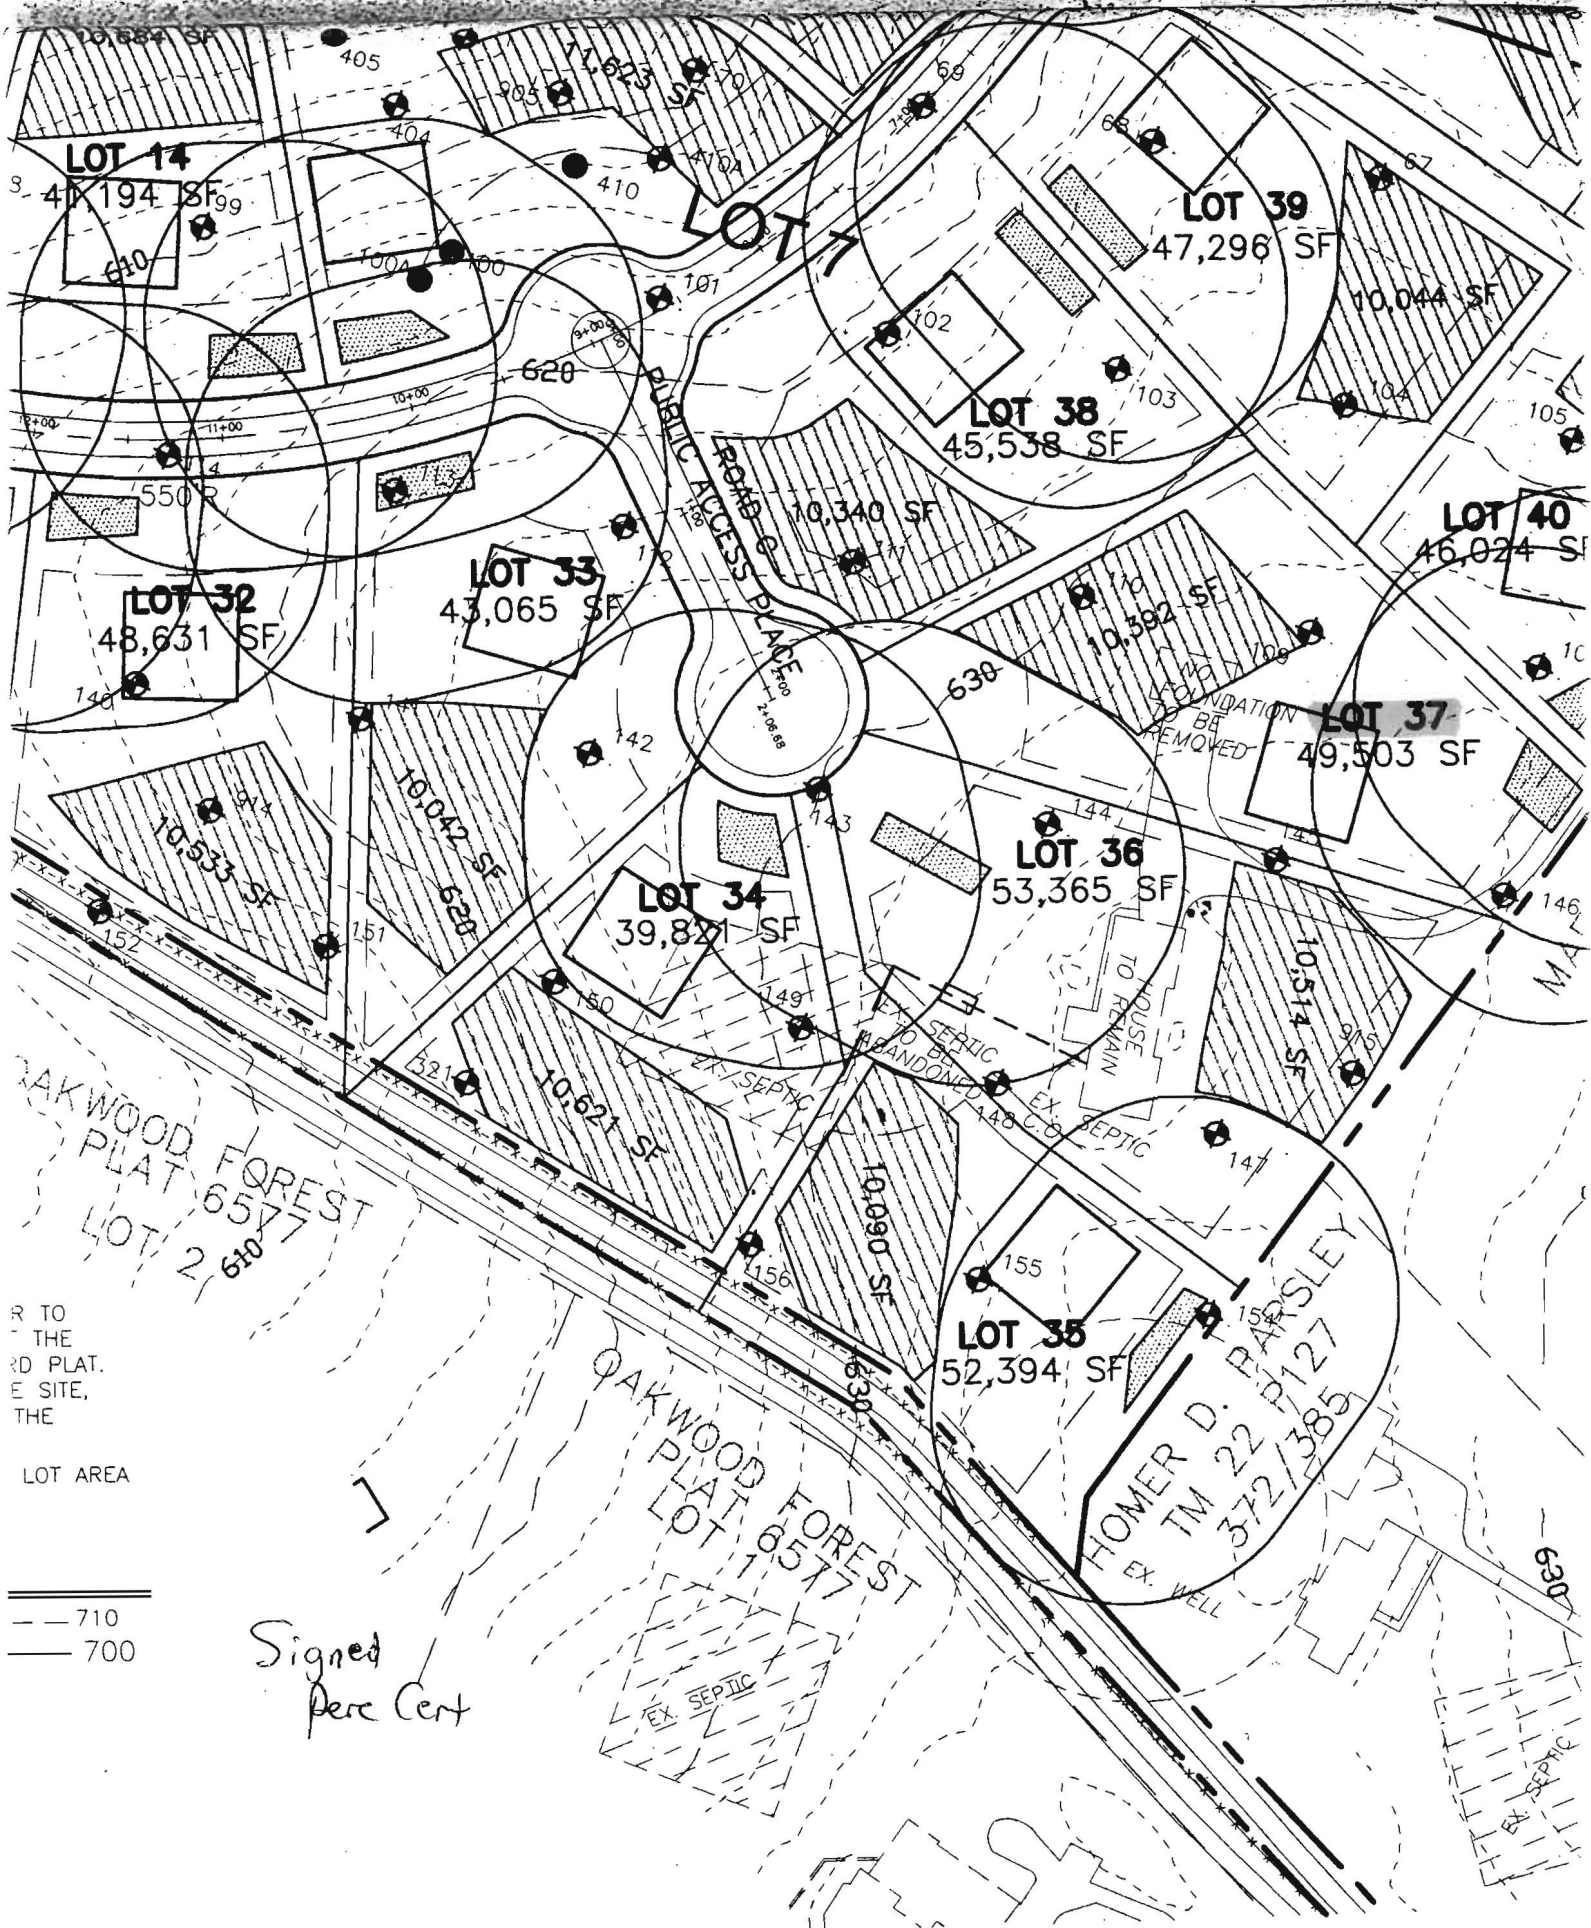

R TO
THE
RD PLAT.
E SITE,
THE

LOT AREA

--- 710
— 700

Signed
perc Cent

