



APPLICATION

FOR PERCOLATION TESTING AND SITE EVALUATION

TEST DATE(S) _____ TEST TIME _____ A/P _____

AGENCY REVIEW: _____ DATE _____

DO NOT WRITE ABOVE THIS LINE

I HEREBY APPLY FOR THE NECESSARY TESTING/EVALUATION PRIOR TO ISSUANCE OF SEWAGE DISPOSAL SYSTEM PERMIT(S) TO:

CHECK AS NEEDED:

- CONSTRUCT NEW SEPTIC SYSTEM(S)
- REPAIR/ADD TO AN EXISTING SEPTIC SYSTEM
- REPLACE AN EXISTING SEPTIC SYSTEM

CHECK AS NEEDED:

- NEW STRUCTURE(S)
- ADDITION TO AN EXISTING STRUCTURE
- REPLACE AN EXISTING STRUCTURE

CHECK ONE:

- CREATE NEW LOT(S)
- BUILD ON AN EXISTING LOT IN A SUBDIVISION
- BUILD ON AN EXISTING PARCEL OF RECORD

IS THE PROPERTY WITHIN 2500' OF ANY RESERVOIR?

- YES
- NO

THE TYPE OF STRUCTURE IS:

- RESIDENTIAL WITH _____ PROPOSED BEDROOMS IN THE COMPLETED STRUCTURE (NOTE UNKNOWN IF APPROPRIATE)
- COMMERCIAL (PROVIDE DETAIL OF NUMBERS AND TYPES OF EMPLOYEES/CUSTOMERS ON ACCOMPANYING PLAN)
- INSTITUTIONAL/GOVERNMENT (PROVIDE DETAIL OF NUMBERS AND TYPES OF EMPLOYEES/USERS ON ACCOMPANYING PLAN)

PROPERTY OWNER(S) Frances Devlin

DAYTIME PHONE 410-997-4600 Goodier Bldrs. CELL _____ FAX _____

MAILING ADDRESS Echo Farm Route 3, 43 East Litchfield Rd., Litchfield CT 06750

STREET CITY/TOWN STATE ZIP

APPLICANT Heritage Land Development

DAYTIME PHONE 410-489-7900 CELL 410-982-2882 FAX 410-489-9768

MAILING ADDRESS 3060 Washington Road, Suite 220 Glenwood MD 21738

STREET CITY/TOWN STATE ZIP

APPLICANT'S ROLE DEVELOPER BUILDER BUYER RELATIVE/FRIEND REALTOR CONSULTANT

PROPERTY LOCATION

SUBDIVISION NAME Meriweather Farm - Section 3 LOT NO. 72

PROPERTY ADDRESS 14944 Roxbury Road Glenelg

STREET TOWN/POST OFFICE


TAX MAP PAGE(S) 21 GRID 16 PARCEL(S) 28 PROPOSED LOT SIZE 1 Acre

AS APPLICANT, I UNDERSTAND THE FOLLOWING: THE SYSTEM INSTALLED SUBSEQUENT TO THIS APPLICATION IS ACCEPTABLE ONLY UNTIL PUBLIC SEWAGE IS AVAILABLE. THIS APPLICATION IS COMPLETE WHEN ALL APPLICABLE FEES AND A SUITABLE SITE PLAN HAVE BEEN RECEIVED. I ACCEPT THE RESPONSIBILITY FOR COMPLIANCE WITH ALL M.O.S.H.A. AND "MISS UTILITY" REQUIREMENTS. APPROVAL IS BASED UPON SATISFACTORY REVIEW OF A PERC CERTIFICATION PLAN. TEST RESULTS WILL BE MAILED TO APPLICANT.

Jenny Kutter
SIGNATURE OF APPLICANT

HOWARD COUNTY HEALTH DEPARTMENT, BUREAU OF ENVIRONMENTAL HEALTH, WELL AND SEPTIC PROGRAM
3525-H ELLICOTT MILLS DRIVE, ELLICOTT CITY, MARYLAND 21043-4544 (410) 313-1771 FAX (410) 313-2648
TDD (410) 313-2323 TOLL FREE 1-877-4MD-DHMH

A/P 5095
 Browns L
 Yellow/orange SL
 Yellow/brow SL
 w/ trace Feek
 10'

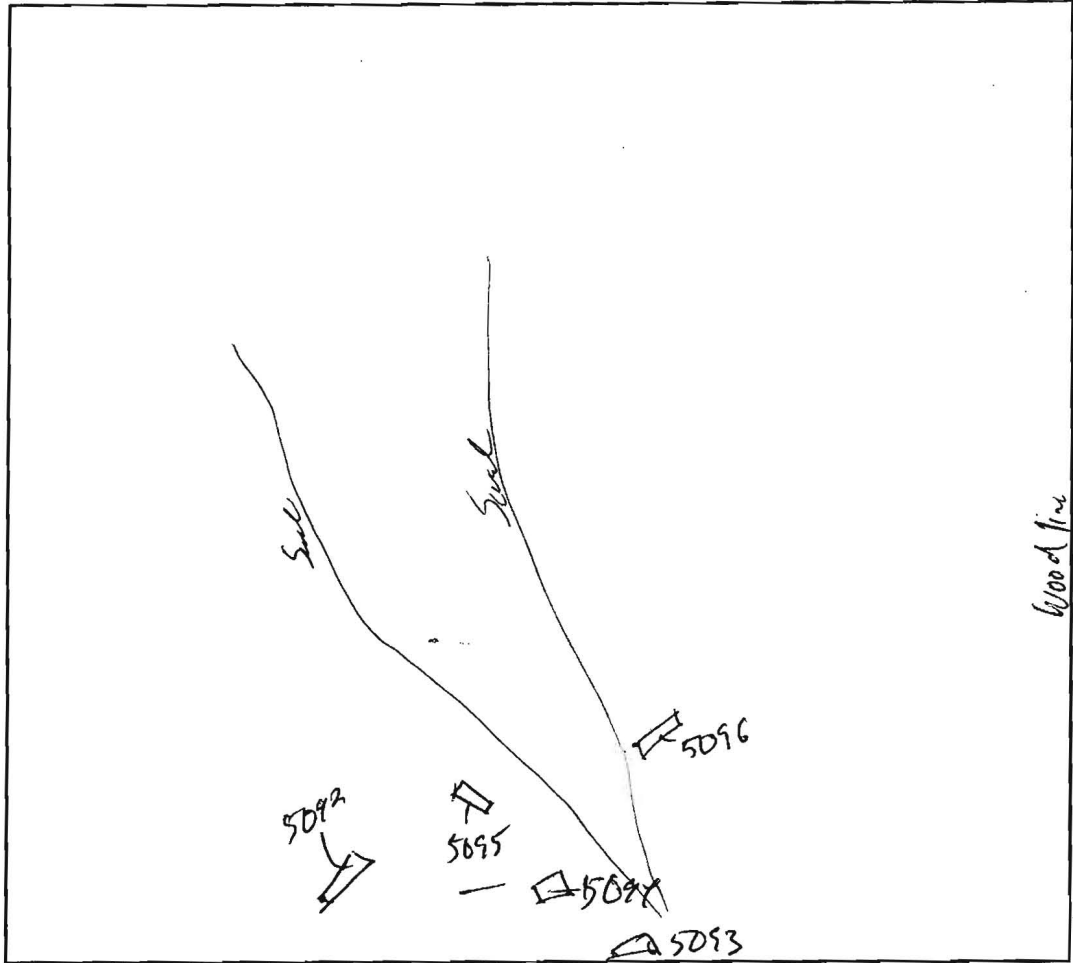

5093
 Browns L
 Orange/Brow SL
 Yellow/Brow SL
 Yellow/grey S w/ trace Rock
 9'

5096
 Browns L
 Yellow/Brow/Red SL
 Yellow/B. SL
 w/ trace Rock
 11'

Brown L
 Red/Brown Brown SL
 Yellow/Brow SL
 w/ trace Rock
 11'

5094
 Browns L
 Red/orange SL
 w/ 40% Boulder
 Yellow/B. SL
 w/ trace Feek
 Yellow/B. S
 w/ trace Feek
 11'

DATE	TEST #	DEPTH	START	BREAK 1" DROP	STOP 2" DROP	TIME OF 2nd INCH	P/F/H
9/14/85	5095	3 1/2' / 10'	12:52	12:55	12:58	3min	P
	5096	5'	-Visible-			Rock	F
	5094	4' / 11'	1:25	1:27	1:29	2min	P
	5093	3' / 9'	1:29	1:32	1:37	6min	P
	5092	11'	-Visible-			OK	P

REMARKS lot of 47

SANITARIAN _____ BACKHOE _____ OTHERS _____

TEST HOLES USED IN SDA _____ AVG. PERC TIME _____ SQ. FT/BR _____

TRENCH WIDTH _____ INLET DEPTH _____ MAX. BOT DEPTH _____ EFFECTIVE S/W _____

B.M.P. No. 8
MICRO-POOL
EXTENDED DETENTION POND
FOR WQ & CPV
HAZARD CLASS 'A'
OWNED AND MAINTAINED BY R.O. J
24' POOL = 477.50
Yr. STORAGE IS NOT RECD.

B.M.P. No. 5
BIO-RETENTION

PRIVATELY OWNED
BUILDABLE
PRESERVATION
PARCEL 'A'
111.88 AC.
B.M.P. No. 6
BIO-RETENTION

FOREST CONSERVATION
LEASEMENT NO. 3
9.29 AC.
(1.41 AC. RETENTION)
(7.85 AC. REFORESTATION)

Approved
P-plan
1/25/08

PRIVATELY OWNED
BUILDABLE
PRESERVATION
PARCEL 'A'
111.88 AC.

LOT 33
51,480 sq. ft.

LOT 19
50,661 sq. ft.

LOT 18
48,329 sq. ft.

LOT 17
45,985 sq. ft.

LOT 36
43,657 sq. ft.

LOT 35
49,515 sq. ft.

LOT 34
48,823 sq. ft.

