

APPLICATION

FOR PERCOLATION TESTING AND SITE EVALUATION

TEST DATE(S) _____

TEST TIME _____

AP 522987

AGENCY REVIEW: _____

DATE 7/22/05

DO NOT WRITE ABOVE THIS LINE

I HEREBY APPLY FOR THE NECESSARY TESTING/EVALUATION PRIOR TO ISSUANCE OF SEWAGE DISPOSAL SYSTEM PERMIT(S) TO:

CHECK AS NEEDED:

- CONSTRUCT NEW SEPTIC SYSTEM(S)
- REPAIR/ADD TO AN EXISTING SEPTIC SYSTEM
- REPLACE AN EXISTING SEPTIC SYSTEM

CHECK AS NEEDED:

- NEW STRUCTURE(S)
- ADDITION TO AN EXISTING STRUCTURE
- REPLACE AN EXISTING STRUCTURE

CHECK ONE:

- CREATE NEW LOT(S)
- BUILD ON AN EXISTING LOT IN A SUBDIVISION
- BUILD ON AN EXISTING PARCEL OF RECORD

IS THE PROPERTY WITHIN 2500' OF ANY RESERVOIR?

- YES
- NO

THE TYPE OF STRUCTURE IS:

- RESIDENTIAL WITH PROPOSED BEDROOMS IN THE COMPLETED STRUCTURE (NOTE UNKNOWN IF APPROPRIATE)
- COMMERCIAL (PROVIDE DETAIL OF NUMBERS AND TYPES OF EMPLOYEES/CUSTOMERS ON ACCOMPANYING PLAN)
- INSTITUTIONAL/GOVERNMENT (PROVIDE DETAIL OF NUMBERS AND TYPES OF EMPLOYEES/USERS ON ACCOMPANYING PLAN)

PROPERTY OWNER(S) Frances Devlin

DAYTIME PHONE 410-997-4600 Goodier Bldrs. CELL _____ FAX _____

MAILING ADDRESS Echo Farm Route 3, 43 East Litchfield Rd., Litchfield CT 06750

STREET CITY/TOWN STATE ZIP

APPLICANT Heritage Land Development

DAYTIME PHONE 410-489-7900 CELL 410-982-2882 FAX 410-489-9768

MAILING ADDRESS 3060 Washington Road, Suite 220 Glenwood MD 21738

STREET CITY/TOWN STATE ZIP

APPLICANT'S ROLE DEVELOPER BUILDER BUYER RELATIVE/FRIEND REALTOR CONSULTANT

PROPERTY LOCATION

SUBDIVISION NAME Meriweather Farm - Section 3 LOT NO. 65

PROPERTY ADDRESS 14944 Roxbury Road Glenelg

STREET TOWN/POST OFFICE

TAX MAP PAGE(S) 21 GRID 16 PARCEL(S) 28 PROPOSED LOT SIZE 1 Acre

AS APPLICANT, I UNDERSTAND THE FOLLOWING: THE SYSTEM INSTALLED SUBSEQUENT TO THIS APPLICATION IS ACCEPTABLE ONLY UNTIL PUBLIC SEWAGE IS AVAILABLE. THIS APPLICATION IS COMPLETE WHEN ALL APPLICABLE FEES AND A SUITABLE SITE PLAN HAVE BEEN RECEIVED. I ACCEPT THE RESPONSIBILITY FOR COMPLIANCE WITH ALL M.O.S.H.A. AND "MISS UTILITY" REQUIREMENTS. APPROVAL IS BASED UPON SATISFACTORY REVIEW OF A PERC CERTIFICATION PLAN. TEST RESULTS WILL BE MAILED TO APPLICANT.

Jeremy Kutler
SIGNATURE OF APPLICANT

HOWARD COUNTY HEALTH DEPARTMENT, BUREAU OF ENVIRONMENTAL HEALTH, WELL AND SEPTIC PROGRAM
3525-H ELLICOTT MILLS DRIVE, ELLICOTT CITY, MARYLAND 21043-4544 (410) 313-1771 FAX (410) 313-2648
TDD (410) 313-2323 TOLL FREE 1-877-4MD-DHMH

A/P 5026

1 brown
orange
brown
(ab)
Scl
3 1/2
TRANSITION
4 1/2
o-b
heavy loam
coarse
sandy
loam.
10
y-b gray
sl w/ 10% cherty frags

5029
1 brown
dark
orange
brown
ab
Scl
4 1/2


yellow
brown
pink
compact
sandy
loam

9
15 sand
Refusal

5030
1 1/2 brown
dark
o-b
angular
blocky
heavy l/
heavy scl

5 TRANSITION
y-b
sandy
silty
loam
mix

10 v-b
heavy sl
compact

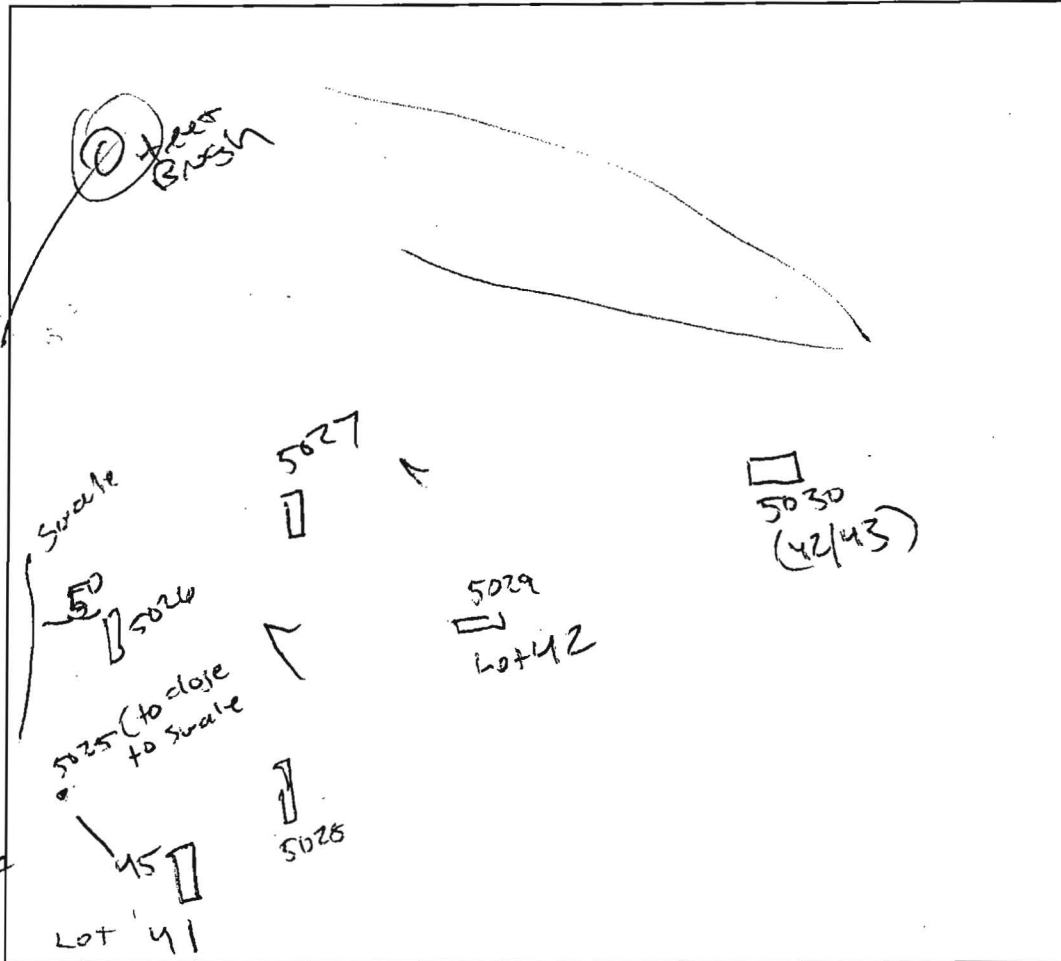

5025
1 brown
yellow
loam
heavy loam
3
o-b
scl
(ab)
5
yellow
brown
fine
sandy
silty
loam
11
10% cherty frags
13

5026
1 brown
dark
orange
brown
Scl
angular
blocky
5
TRANSITION
6
y-b
coarse
sandy
loam.

DATE	TEST #	DEPTH	START	BREAK 1" DROP	STOP 2" DROP	TIME OF 2nd INCH	P/F/H
9/14/05	5028	4 1/2 13	9:47	9:55	10:14	19	P
	5029	5 11	10:00	10:04	10:12	8	P
	5030	5 1/2 13	10:14	Slow			F
	5027	6 12	10:36	10:42	10:51	9	P
	5020	5 1/2 13	10:52	11:19	Slow		F
	5025	6 13	11:06	11:18	11:42	24	P
Repa	5026	7 13	3:14	3:23	3:38	15	P
	5030	13	3:14	3:18	3:24	6	P
	50	26					

13 5027
1 brown
dark
o-purple
brown
Scl
(ab)
5
TRANSITION
purple
brown
sandy
silty
mix
12
purple grey
st.

REMARKS

SANITARIAN RAY/KJB/GAC BACKHOE ZAPP & Jewell and OTHERS Feage

TEST HOLES USED IN SDA _____ AVG. PERC TIME _____ SQ. FT/BR _____

TRENCH WIDTH _____ INLET DEPTH _____ MAX. BOT DEPTH _____ EFFECTIVE S/W _____



APPLICATION

FOR PERCOLATION TESTING AND SITE EVALUATION

TEST DATE(S) _____

TEST TIME _____

AP 522987

AGENCY REVIEW: _____

DATE 7/22/05

DO NOT WRITE ABOVE THIS LINE

I HEREBY APPLY FOR THE NECESSARY TESTING/EVALUATION PRIOR TO ISSUANCE OF SEWAGE DISPOSAL SYSTEM PERMIT(S) TO:

CHECK AS NEEDED:

- CONSTRUCT NEW SEPTIC SYSTEM(S)
- REPAIR/ADD TO AN EXISTING SEPTIC SYSTEM
- REPLACE AN EXISTING SEPTIC SYSTEM

CHECK AS NEEDED:

- NEW STRUCTURE(S)
- ADDITION TO AN EXISTING STRUCTURE
- REPLACE AN EXISTING STRUCTURE

CHECK ONE:

- CREATE NEW LOT(S)
- BUILD ON AN EXISTING LOT IN A SUBDIVISION
- BUILD ON AN EXISTING PARCEL OF RECORD

IS THE PROPERTY WITHIN 2500' OF ANY RESERVOIR?

- YES
- NO

THE TYPE OF STRUCTURE IS:

- RESIDENTIAL WITH PROPOSED BEDROOMS IN THE COMPLETED STRUCTURE (NOTE UNKNOWN IF APPROPRIATE)
- COMMERCIAL (PROVIDE DETAIL OF NUMBERS AND TYPES OF EMPLOYEES/CUSTOMERS ON ACCOMPANYING PLAN)
- INSTITUTIONAL/GOVERNMENT (PROVIDE DETAIL OF NUMBERS AND TYPES OF EMPLOYEES/USERS ON ACCOMPANYING PLAN)

PROPERTY OWNER(S)	Frances Devlin			
DAYTIME PHONE	410-997-4600	CELL	Goodier Bldrs.	FAX
MAILING ADDRESS	Echo Farm Route 3, 43 East Litchfield Rd.,	Litchfield	CT	06750
	STREET	CITY/TOWN	STATE	ZIP
APPLICANT	Heritage Land Development			
DAYTIME PHONE	410-489-7900	CELL	410-982-2882	FAX 410-489-9768
MAILING ADDRESS	3060 Washington Road, Suite 220	Glenwood	MD	21738
	STREET	CITY/TOWN	STATE	ZIP
APPLICANT'S ROLE	<input checked="" type="checkbox"/> DEVELOPER	<input type="checkbox"/> BUILDER	<input type="checkbox"/> BUYER	<input type="checkbox"/> RELATIVE/FRIEND
	<input type="checkbox"/> REALTOR	<input type="checkbox"/> CONSULTANT		
PROPERTY LOCATION	Meriweather Farm - Section 3			
SUBDIVISION NAME				LOT NO. 86
PROPERTY ADDRESS	14944 Roxbury Road	Glenelg		
	STREET	TOWN/POST OFFICE		
TAX MAP PAGE(S)	21	GRID	16	PARCEL(S)
				28
	PROPOSED LOT SIZE		1 Acre	

AS APPLICANT, I UNDERSTAND THE FOLLOWING: THE SYSTEM INSTALLED SUBSEQUENT TO THIS APPLICATION IS ACCEPTABLE ONLY UNTIL PUBLIC SEWAGE IS AVAILABLE. THIS APPLICATION IS COMPLETE WHEN ALL APPLICABLE FEES AND A SUITABLE SITE PLAN HAVE BEEN RECEIVED. I ACCEPT THE RESPONSIBILITY FOR COMPLIANCE WITH ALL M.O.S.H.A. AND "MISS UTILITY" REQUIREMENTS. APPROVAL IS BASED UPON SATISFACTORY REVIEW OF A PERC CERTIFICATION PLAN. TEST RESULTS WILL BE MAILED TO APPLICANT.


Jenny Kutter
SIGNATURE OF APPLICANT

HOWARD COUNTY HEALTH DEPARTMENT, BUREAU OF ENVIRONMENTAL HEALTH, WELL AND SEPTIC PROGRAM
3525-H ELLICOTT MILLS DRIVE, ELLICOTT CITY, MARYLAND 21043-4544 (410) 313-1771 FAX (410) 313-2648
TDD (410) 313-2323 TOLL FREE 1-877-4MD-DHMH

5033
brown l
o-b
ab
heavy
1-
scl
5 1/2
Transition
y-b
sl
10
y-b
grey
compact
sl
13

5035
brown l
y-b
heavy
ab loam
3
o-b
purple
scl
5
purple
brown
sl/sil
massive
10
50% clay
frag & compact
sl
13

5034
brown l
y-b
heavy l
3
o-b
scl
(ab)
5
y-b
sl
course
7
purple
brown
massive
sl
13

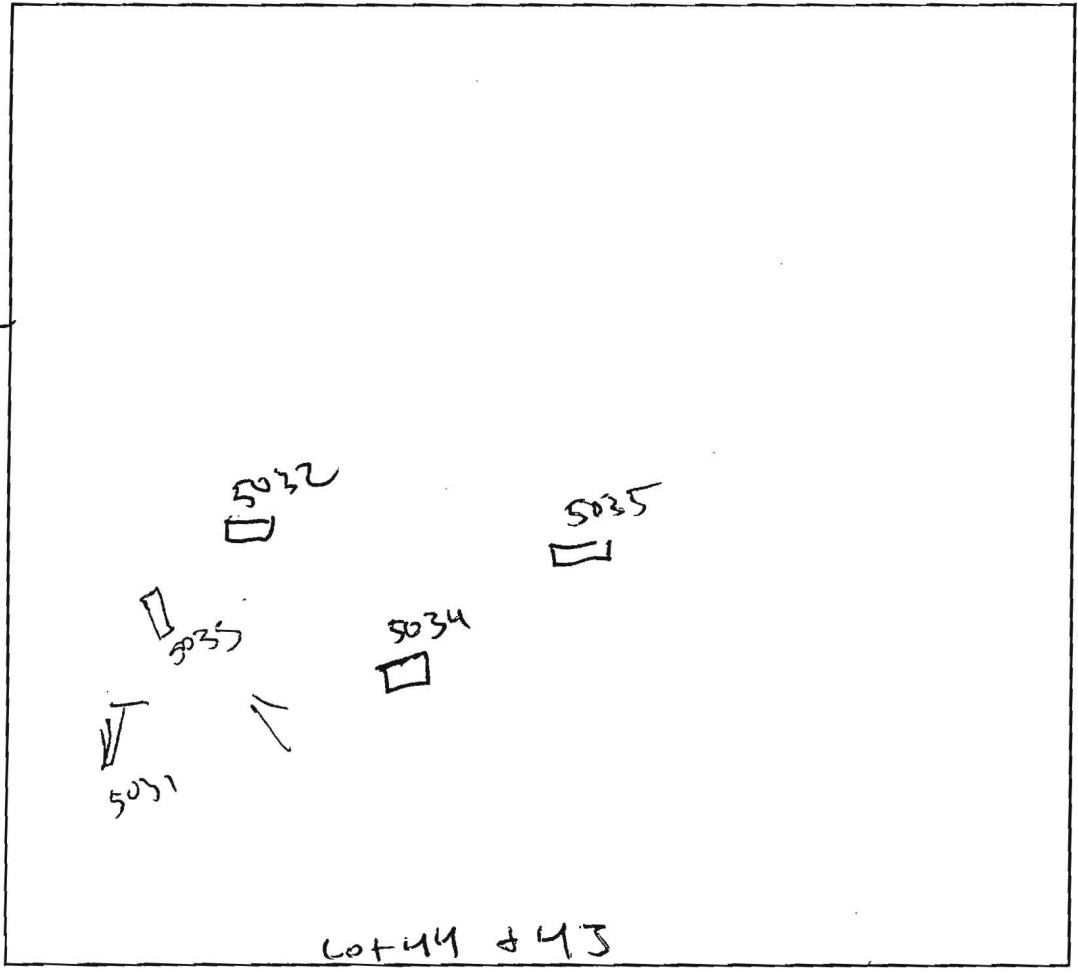

5031
brown l
y-b
(ab)
heavy loam
2 1/2
dark
orange
brown
as
scl
5 1/2
Transition
y-b
course
sl
6 1/2
11
y-grey
sl
12 1/2

5037
brown l
o-b
ab heavy
loam
scl
4 1/2
purple
brown
yellow
sl
mod
grain
10
grey sl
15%
c. cherty
13

DATE	TEST #	DEPTH	START	BREAK 1" DROP	STOP 2" DROP	TIME OF 2nd INCH	P/F/H
9/14/68	5035	6 / 13	9:01	9:06	9:12	6	P
	5034	6 / 13	9:07	9:09	9:13	4	P
	5032	5 / 13	9:28	9:31	9:34	3	P
	5033	6 / 13	10:22	10:25	10:28	3	P
Repour	5031	7 / 12 1/2	3:23	3:39	4:00	22	P
Lot 42/43	5031	6 / 12 1/2	9:44	Flow			F


REMARKS _____

SANITARIAN RAY/KJB BACKHOE Level/and OTHERS Zapp/Frag/eq.

TEST HOLES USED IN SDA _____ AVG. PERC TIME _____ SQ. FT/BR _____

TRENCH WIDTH _____ INLET DEPTH _____ MAX. BOT DEPTH _____ EFFECTIVE S/W _____

Approved
P-Plan
1-25-08

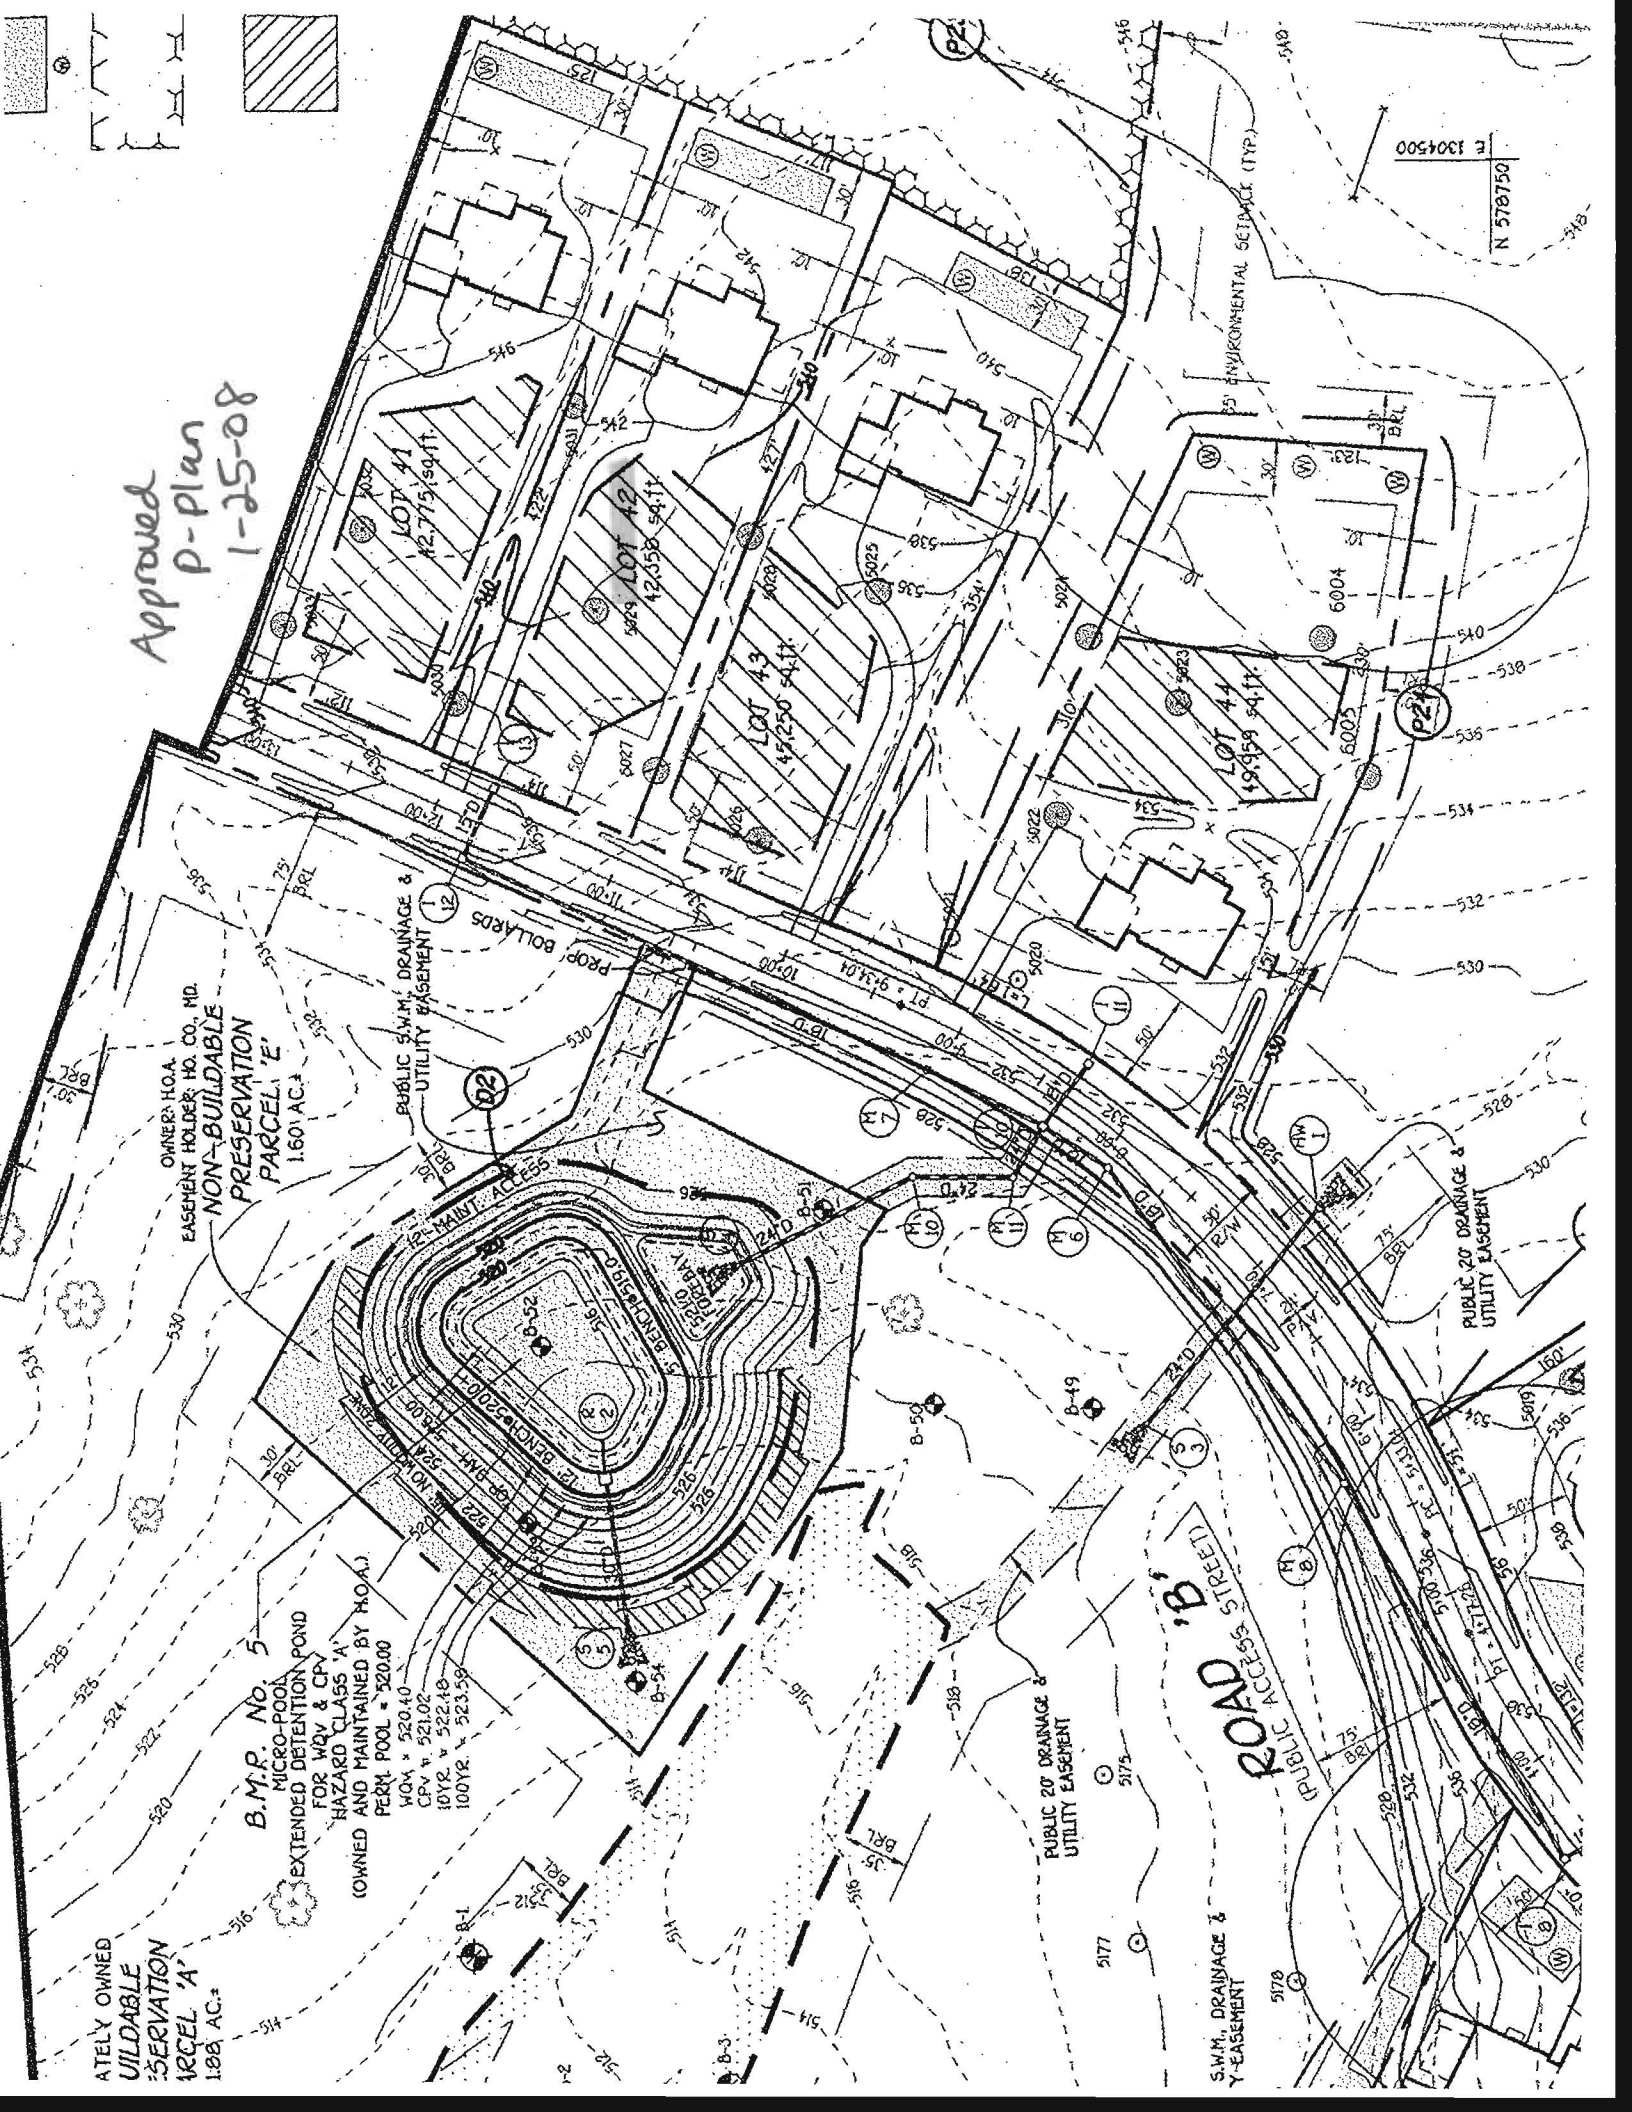

OWNER: H.O.A.
EASEMENT HOLDER: HO. CO. MD.
NON-BUILDABLE
PRESERVATION
PARCEL 'E'
1.60 AC.

B.M.P. NO. 5
MICRO-POOL
EXTENDED DETENTION POND
FOR HWY & CPV
HAZARD CLASS 'A'
(OWNED AND MAINTAINED BY H.O.A.)
PERM POOL = 520.00
WQA = 520.40
CPV = 521.02
10YR = 522.48
100YR = 523.59

ATELY OWNED
UILDABLE
SERVATION
RCEL 'A'
1.88 AC.

S.W.M. DRAINAGE &
UTILITY EASEMENT

PUBLIC 20' DRAINAGE &
UTILITY EASEMENT

ROAD ACCESS STREET

E 1304500
N 570750