

9/28/72  
10/27/72  
*Monaghan*  
*D.W.*

# PERMIT

SEWAGE DISPOSAL SYSTEM

MARYLAND STATE DEPARTMENT OF HEALTH

HOWARD COUNTY

## INDEXED

44-10-27-72  
Dury  
P 17487

A

ELLCOTT CITY

DISTRICT 4

DATE 9/20/72

Grigsby Construction Corp. IS PERMITTED TO INSTALL ALTER X

ADDRESS Box 126, Mt. Airy, Md. PHONE 829-1113

A SEWAGE DISPOSAL SYSTEM LOCATED AT \_\_\_\_\_

SUBDIVISION \_\_\_\_\_ ROAD Route 144 - almost to LOT \_\_\_\_\_  
Long Corner Road

PROPERTY OWNER Dr. Richard Hough

ADDRESS \_\_\_\_\_

SPECIFICATIONS - REPAIR

DRAIN FIELD \_\_\_\_\_ DEPTH \_\_\_\_\_ FEET, BOTTOM AREA \_\_\_\_\_ SQ. FT.

SEEPAGE PITS \_\_\_\_\_ ABSORBENT SIDE-WALL AREA \_\_\_\_\_ SQ. FT.

SEPTIC TANK CAPACITY 1,200 GALLONS

FOR GARBAGE GRINDER, INCREASE DISPOSAL AREA 22% & TANK CAPACITY 50%.

OTHER REPAIR - Trench - 50 ft. long - 11 to 12 ft. deep - 5 to 6 ft. stone under pipe.

Sewer line 14 ft. back from right front corner of building - trench to begin 36 ft. to right of this point.


NOTE: CALL FOR INSPECTION WHEN TRENCH IS OPENED UP BEFORE ANY GRAVEL IS INSTALLED.

PLANS APPROVED BY D. W. Monaghan DATE 9/20/72

FILL SEPTIC TANK AND DISTRIBUTION BOX WITH WATER BEFORE CALLING FOR AN INSPECTION. COVER NO WORK UNTIL INSPECTED AND APPROVED.

NEITHER THE HOWARD COUNTY COMMISSIONERS NOR THE HEALTH DEPARTMENT IS RESPONSIBLE FOR THE SUCCESSFUL OPERATION OF ANY SYSTEM.

17487

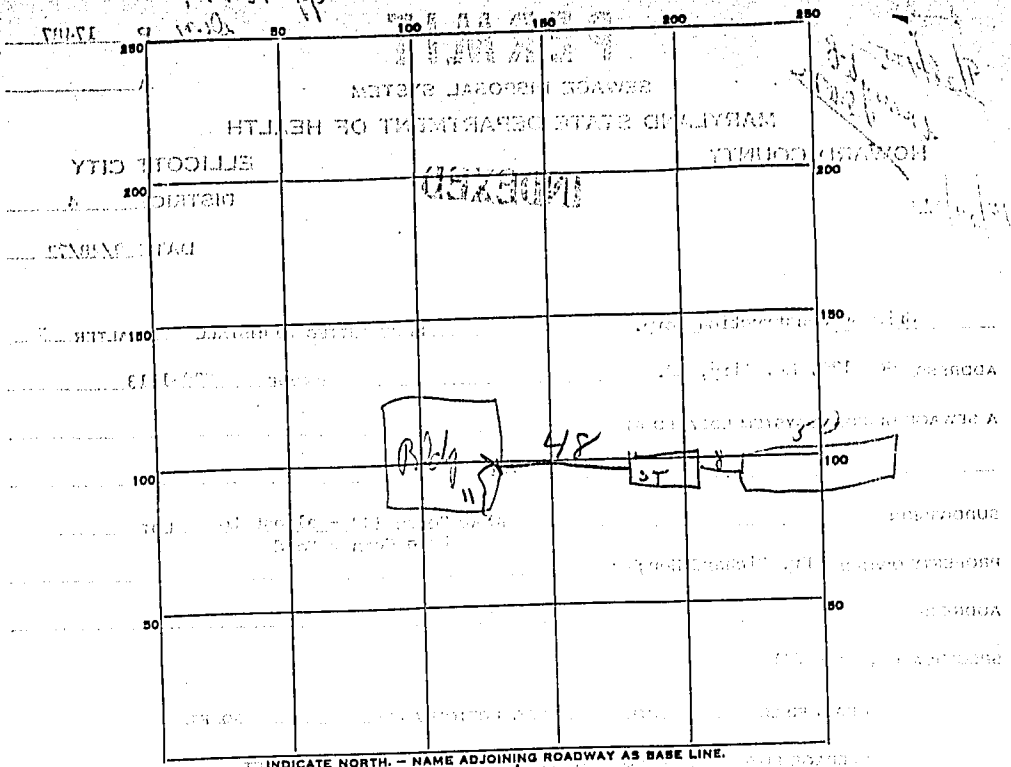

INDICATE NORTH. - NAME ADJOINING ROADWAY AS BASE LINE.

27144

PERMIT CARD OK

SEPTIC TANK, LEVEL OK CLEANOUTS OK

DISTRIBUTION BOX, LEVEL \_\_\_\_\_

TILE FIELD, DEPTH 10 FT. TRENCH WIDTH 2 FT.

GRAVEL DEPTH 60 IN. TOTAL LENGTH 50 FT.

NUMBER OF TRENCHES 1 TOTAL BOTTOM AREA 100

SEEPAGE PITS, INSIDE DIAMETER \_\_\_\_\_ FT. DEPTH BELOW INLET \_\_\_\_\_ FT.

ABSORBENT AREA 600 SQ. FT.

REMARKS 9-28-72 - next to line from bldg & trench  
not in - outlet pipe not cemented

DATE SYSTEM APPROVED 10/27/72 INSPECTOR J. M. Murray