



APPLICATION

FOR PERCOLATION TESTING AND SITE EVALUATION

TEST DATE(S) _____ TEST TIME _____

AP 53167108

AGENCY REVIEW: _____

DATE 3-16-12

DO NOT WRITE ABOVE THIS LINE

I HEREBY APPLY FOR THE NECESSARY TESTING/EVALUATION PRIOR TO ISSUANCE OF SEWAGE DISPOSAL SYSTEM PERMIT(S) TO:

CHECK AS NEEDED:

- CONSTRUCT NEW SEPTIC SYSTEM(S)
- REPAIR/ADD TO AN EXISTING SEPTIC SYSTEM
- REPLACE AN EXISTING SEPTIC SYSTEM

CHECK AS NEEDED:

- NEW STRUCTURE(S)
- ADDITION TO AN EXISTING STRUCTURE
- REPLACE AN EXISTING STRUCTURE

CHECK ONE:

- CREATE NEW LOT(S)
- BUILD ON AN EXISTING LOT IN A SUBDIVISION
- BUILD ON AN EXISTING PARCEL OF RECORD

IS THE PROPERTY WITHIN 2500' OF ANY RESERVOIR?

- YES
- NO

THE TYPE OF STRUCTURE IS:

- RESIDENTIAL WITH 4 PROPOSED BEDROOMS IN THE COMPLETED STRUCTURE (NOTE **UNKNOWN** IF APPROPRIATE)
- COMMERCIAL (PROVIDE DETAIL OF NUMBERS AND TYPES OF EMPLOYEES/ CUSTOMERS ON ACCOMPANYING PLAN)
- INSTITUTIONAL/GOVERNMENT (PROVIDE DETAIL OF NUMBERS AND TYPES OF EMPLOYEES/USERS ON ACCOMPANYING PLAN)

PROPERTY OWNER(S) Tim Keane

DAYTIME PHONE 410-480-0023 CELL 443-324-9806 FAX 410-480-0013

MAILING ADDRESS 3675 Park Lane EC 21053
STREET CITY/TOWN STATE ZIP

APPLICANT Tim Keane

DAYTIME PHONE _____ CELL _____ FAX _____

MAILING ADDRESS _____
STREET CITY/TOWN STATE ZIP

APPLICANT'S ROLE: DEVELOPER BUILDER BUYER RELATIVE/FRIEND REALTOR CONSULTANT

PROPERTY LOCATION
SUBDIVISION/PROPERTY NAME #1 CROC LOT NO. 8

PROPERTY ADDRESS 1475 Rt 32 Sykesville MD 21784
STREET TOWN/POST OFFICE

TAX MAP PAGE(S) 9 GRID 17/18 PARCEL(S) 41 PROPOSED LOT SIZE 3Acr

AS APPLICANT, I UNDERSTAND THE FOLLOWING: THE SYSTEM INSTALLED SUBSEQUENT TO THIS APPLICATION IS ACCEPTABLE ONLY UNTIL PUBLIC SEWERAGE IS AVAILABLE. THIS APPLICATION IS COMPLETE WHEN ALL APPLICABLE FEES AND A SUITABLE SITE PLAN HAVE BEEN RECEIVED. I ACCEPT THE RESPONSIBILITY FOR COMPLIANCE WITH ALL M.O.S.H.A. AND "MISS UTILITY" REQUIREMENTS. APPROVAL IS BASED UPON SATISFACTORY REVIEW OF A PERC CERTIFICATION PLAN.

TEST RESULTS WILL BE MAILED TO APPLICANT.

Tim Keane
SIGNATURE OF APPLICANT

HOWARD COUNTY HEALTH DEPARTMENT, BUREAU OF ENVIRONMENTAL HEALTH, WELL AND SEPTIC PROGRAM
7178 COLUMBIA GATEWAY DRIVE COLUMBIA, MARYLAND 21046 (410) 313-2640 FAX (410) 313-2648
TDD (410) 313-2323 TOLL FREE 1-877-4MD-DHMH

A/P _____

DATE	TEST #	DEPTH	START	BREAK 1" DROP	STOP 2" DROP	TIME OF 2ND INCH	P/F/H

REMARKS _____


SANITARIAN _____ BACKHOE _____ OTHERS _____

TEST HOLES USED IN SDA _____ AVG. PERC TIME _____ SQ. FT/BR _____

TRENCH WIDTH _____ INLET DEPTH _____ MAX. BOT DEPTH _____ EFFECTIVE SW _____

AP

(805)
 1' bm l 1CSBK
 3' yellow bm scl
 6' yellow brn scl
 9' yellow bm fsl
 12' yellow bm v fsl
 ↓

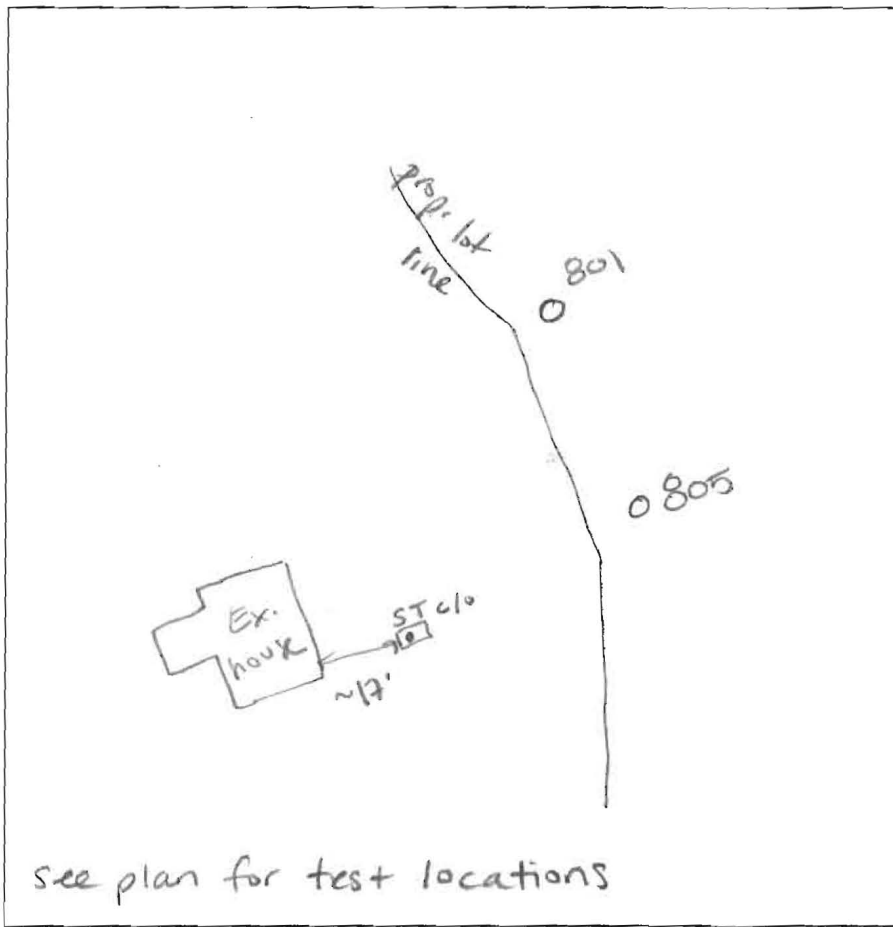

(806)
 roots
 4' brn scl icebk
 8' yellow bm scl 1msbk
 yellow bm scl w mica schist MnV
 12'

(801)
 1' roots / yellow e
 yellow bm scl 2msbk similar to 805
 5.5' yellow fsl saprolite
 7' yellow bm fsl
 10' yellow bm v fsl

(804)
 2' yellow
 4.5' yellow bm scl icebk
 6' yellow bm sl saprolite
 9' yellow bm ch fsl
 yellow bm sl w mica schist
 12'

DATE	TEST #	DEPTH	START	BREAK 1" DROP	STOP 2" DROP	TIME OF 2ND INCH	P/F/H
3-21-12	805	5.5' / 12'	11:25	11:29	11:33	4	P
	801	12.2'	VISUAL				P
	802	5' / 12'	11:50	11:54	11:58	4	P
	806	6' / 12'	12:15	12:19	12:24	5	P
	804	12'	VISUAL				P

(802)
 1.5' roots / bm l
 4' org brn scl 2msbk
 yellow bm fsl 20% rx
 12' yellow brn fsl
 ↓

REMARKS Lot 8 holes dug per plan Ex. system appears OK
 SANITARIAN HB/RR BACKHOE Jake OTHERS Tim K.
 TEST HOLES USED IN SDA 5 AVG. PERC TIME 4.5 SQ. FT/BR
 TRENCH WIDTH 2 INLET DEPTH 4 MAX. BOT DEPTH 8 EFFECTIVE SW 1.5'-2'

